




12" SUBBASE + POINT  
 SUBBASE = 74.1 SF ✓  
 COMMON = 109.5 SF ✓  
 F.G. = 59.5 LF RCD 1/25/11 ✓  
 C.B. 01/20/11

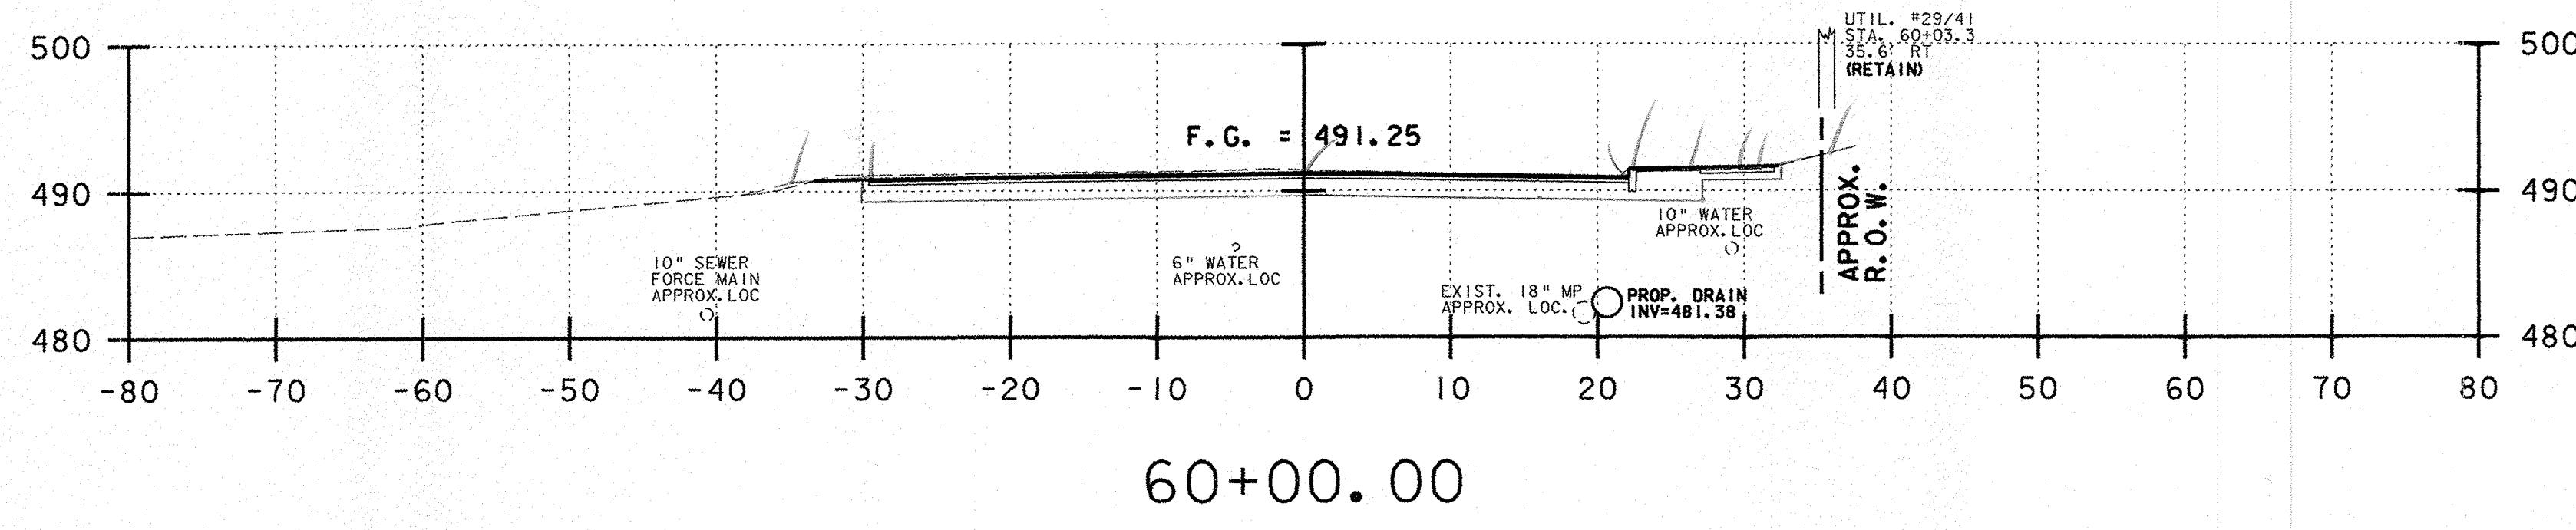

12" SUBBASE + POINT  
 SUBBASE = 69.6 SF ✓  
 COMMON = 105.7 SF ✓  
 F.G. = 57.0 LF RCD 1/25/11 ✓  
 C.B. 01/20/11

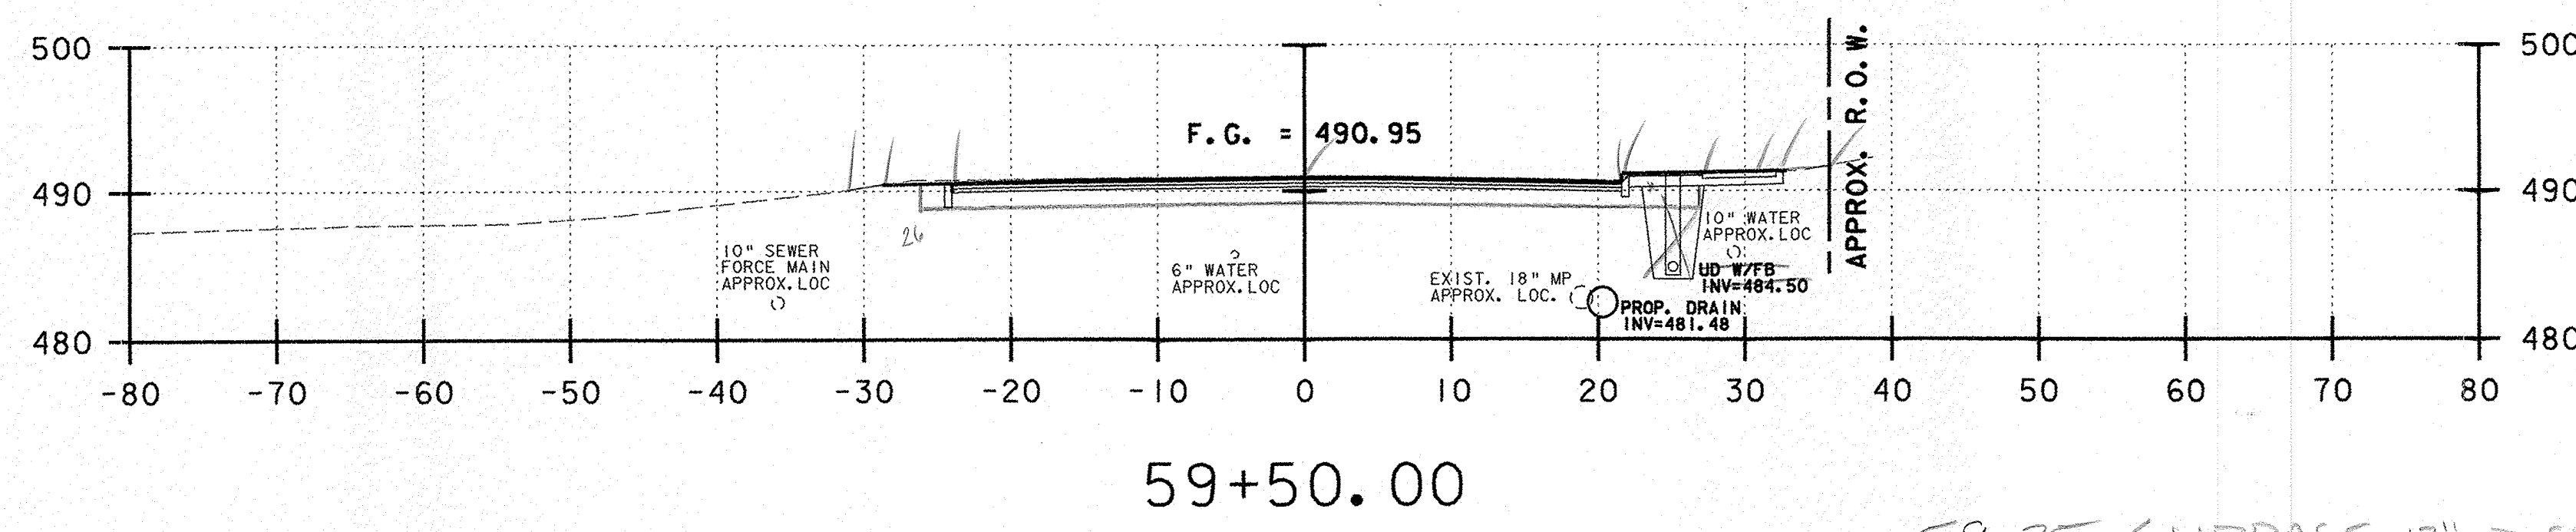

12" SUBBASE  
 SUBBASE = 63.5 SF ✓  
 COMMON = 103.3 SF ✓  
 F.G. = 53.0 LF RCD 1/25/11 ✓  
 C.B. 01/20/11

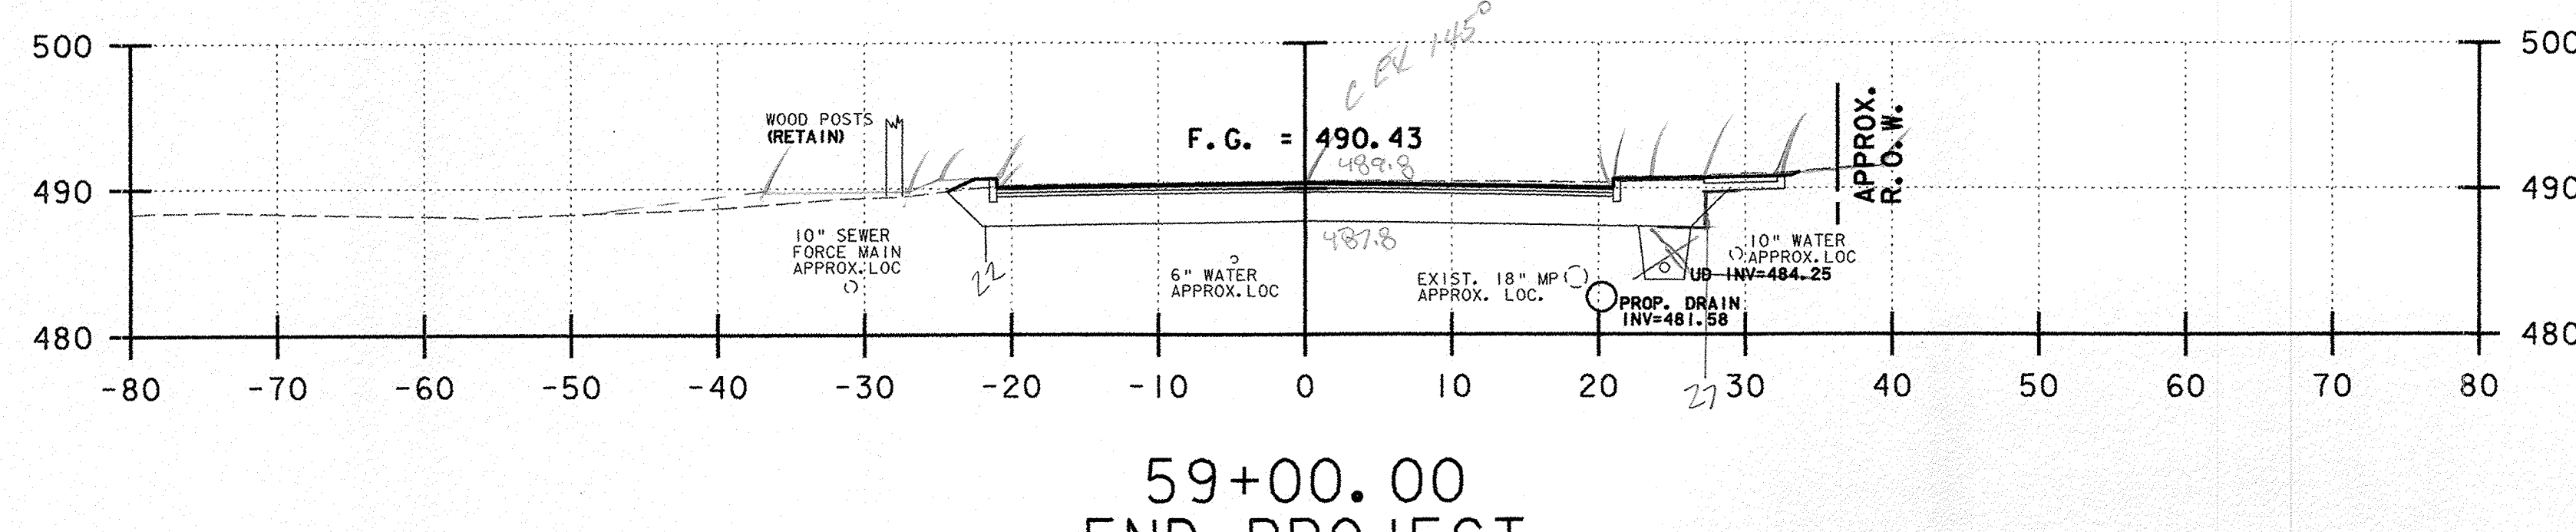

2' SUBBASE  
 SUBBASE = 110.7 SF ✓  
 COMMON = 148.8 SF ✓  
 F.G. = 49.0 LF RCD 1/25/11 ✓  
 C.B. 01/19/11

## U.S. ROUTE 5 HARTFORD AVENUE

**NOTES:**

- 1) REFER TO ROADWAY LAYOUT AND UTILITY LAYOUT SHEETS FOR PROPOSED ABANDONMENT, REMOVAL, OR PROTECTION REQUIREMENTS OF EXISTING UTILITIES IN CONFLICT WITH PROPOSED WORK.

59+00.00  
END PROJECT  
BEGIN APPROACH

PROJECT NAME: HARTFORD		PLOT DATE: 1/11/2007	
PROJECT NUMBER: RS 0113(40)		DRAWN BY: E. ATKINS	
FILE NAME: z86c027xsl.dgn	DESIGNED BY: K. ISHIKURA	CHECKED BY: K. ISHIKURA	SHEET 224 OF 239
PROJECT LEADER: KEN UPMAL	E. ATKINS		