


ORIGINAL	SURVEY	BY	DATE
SURVEY	PLOTTED		
NOTE BOOK	FIELD NOTE		
NO.	NO.		

FINAL	SURVEY	BY	DATE
SURVEY	PLOTTED		
NOTE BOOK	FIELD NOTE		
NO.	NO.		

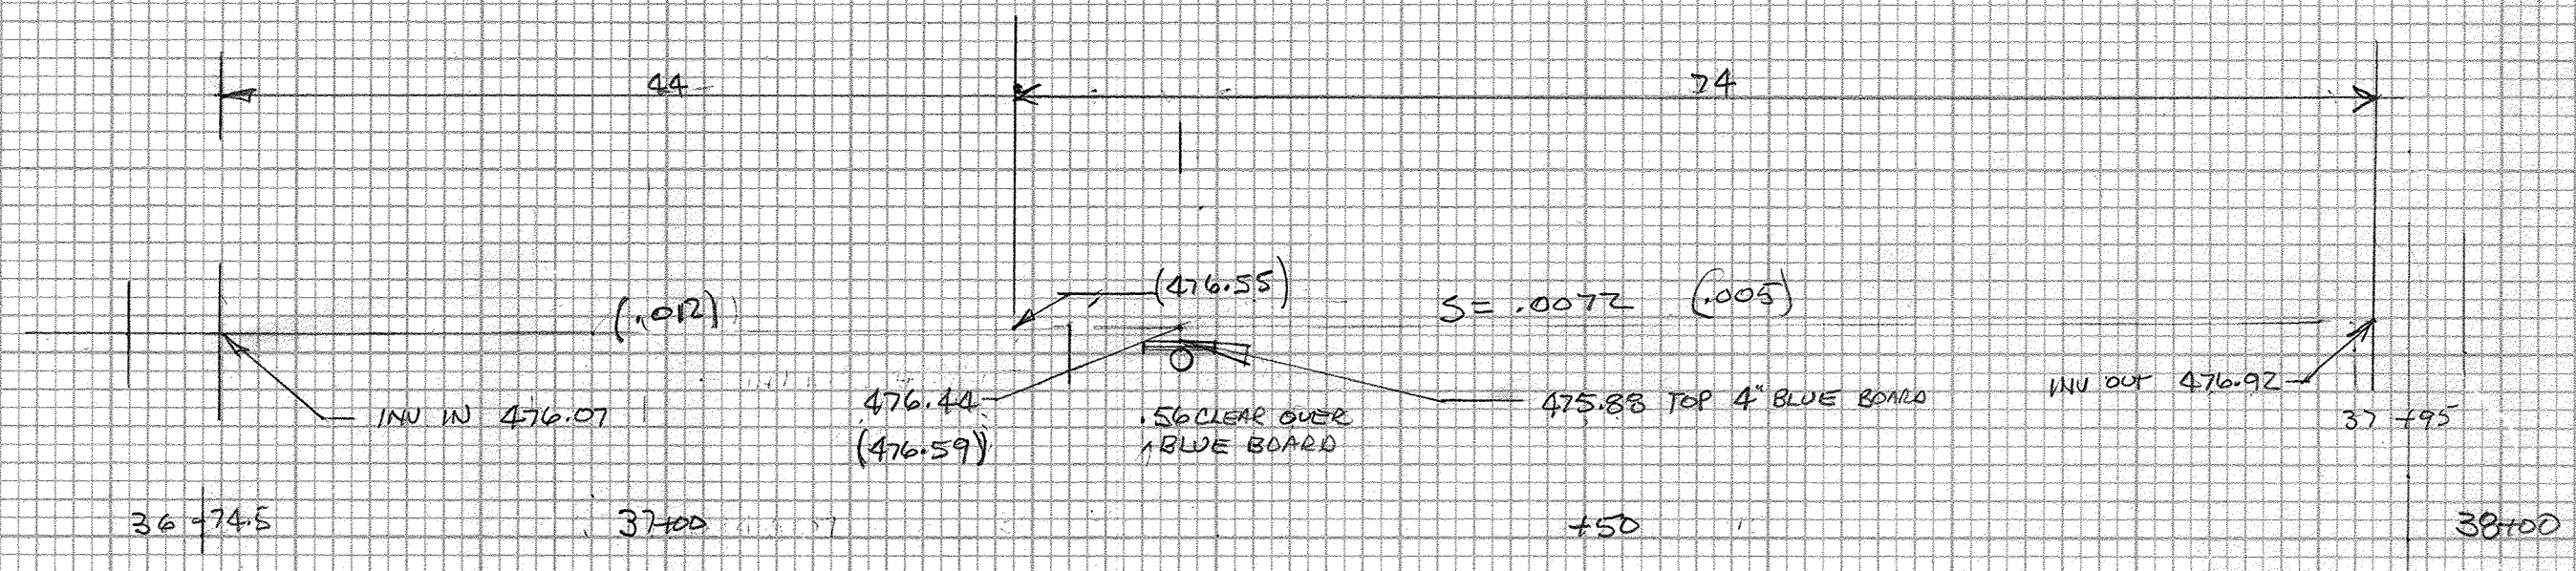

476.92  
 476.07  
 $85 \div 116 = .0072$   
 $.007 \times 66 = .48$

118  
 29  
 44

430

475