

CALCULATED AND DRAWN BY TBG 1/31/08

DR 25
 PIPE T.E. < 5'
 AREA (FROM CADD) = 9.81 SF * 3.75' = 36.79 CF/27 = 1.36 CY
 DS 25
 STRUCTURE T.E. < 5'
 $(5' + 4.5') / 2 * \pi (3.42')^2 = 174.54 \text{ CF/27} = 6.46 \text{ CY}$
 STRUCTURE T.E. > 5'
 $1.5 [(2.53' + 0.00') / 2] * \pi (3.42')^2 = 20.39 \text{ CF/27} = 0.76 \text{ CY}$
 TOT = 7.22 CY
 DR 25 GRANULAR BACKFILL
 $(3.75' * .88' * 15.8') - [(\pi (1.88')^2 / 2) * 15.8'] = 32.92 \text{ CF/27} = 1.22 \text{ CY}$


DR 26
 PIPE T.E. < 5'
 AREA (FROM CADD) = 101.11 SF * 3.75' = 379.16 CF/27 = 14.04 CY
 DS 26
 STRUCTURE T.E. < 5'
 $(2.20' + 2.42') / 2 * \pi (3.42')^2 = 84.88 \text{ CF/27} = 3.14 \text{ CY}$
 DR 26 GRANULAR BACKFILL
 $(3.75' * .88' * 48.7') - [(\pi (1.88')^2 / 2) * 48.7'] = 101.47 \text{ CF/27} = 3.76 \text{ CY}$

DR 27
 PIPE T.E. < 5'
 AREA (FROM CADD) = 7.51 SF * 3.75' = 28.16 CF/27 = 1.04 CY
 DS 27
 STRUCTURE T.E. < 5'
 $(3.89' + 3.79' + 5') / 3 * \pi (3.42')^2 = 155.31 \text{ CF/27} = 5.75 \text{ CY}$
 DR 27 GRANULAR BACKFILL
 $(3.75' * .88' * 7.1') - [(\pi (1.88')^2 / 2) * 7.1'] = 14.79 \text{ CF/27} = 0.55 \text{ CY}$

DR #	PAID	DATE
601.2615	1.61 SF	10/30/08
204.20	9.38 SF	10/30/08
204.30	1.22	
604.20	.75	

DR #	ITEM	PAID	DATE
18" CPEP	601.2615	20 LF	10/1/08
T.E.	204.20	14.04 CY	10/1/08
GRAN BKFL	204.30	1.1 CY	10/1/08
	601.2615	32 LF	10/29/08
	204.20	3.14 CY	"
	204.30	2.86 CY	"
	604.20	.75 EA	"

DR #	ITEM	PAID	DATE
18" CPEP	601.2615	32 LF	10/7/08
T.E.	204.20	6.79 CY	"
GRAN BKFL	204.30	.55	"
4" DI	604.20	.75	"

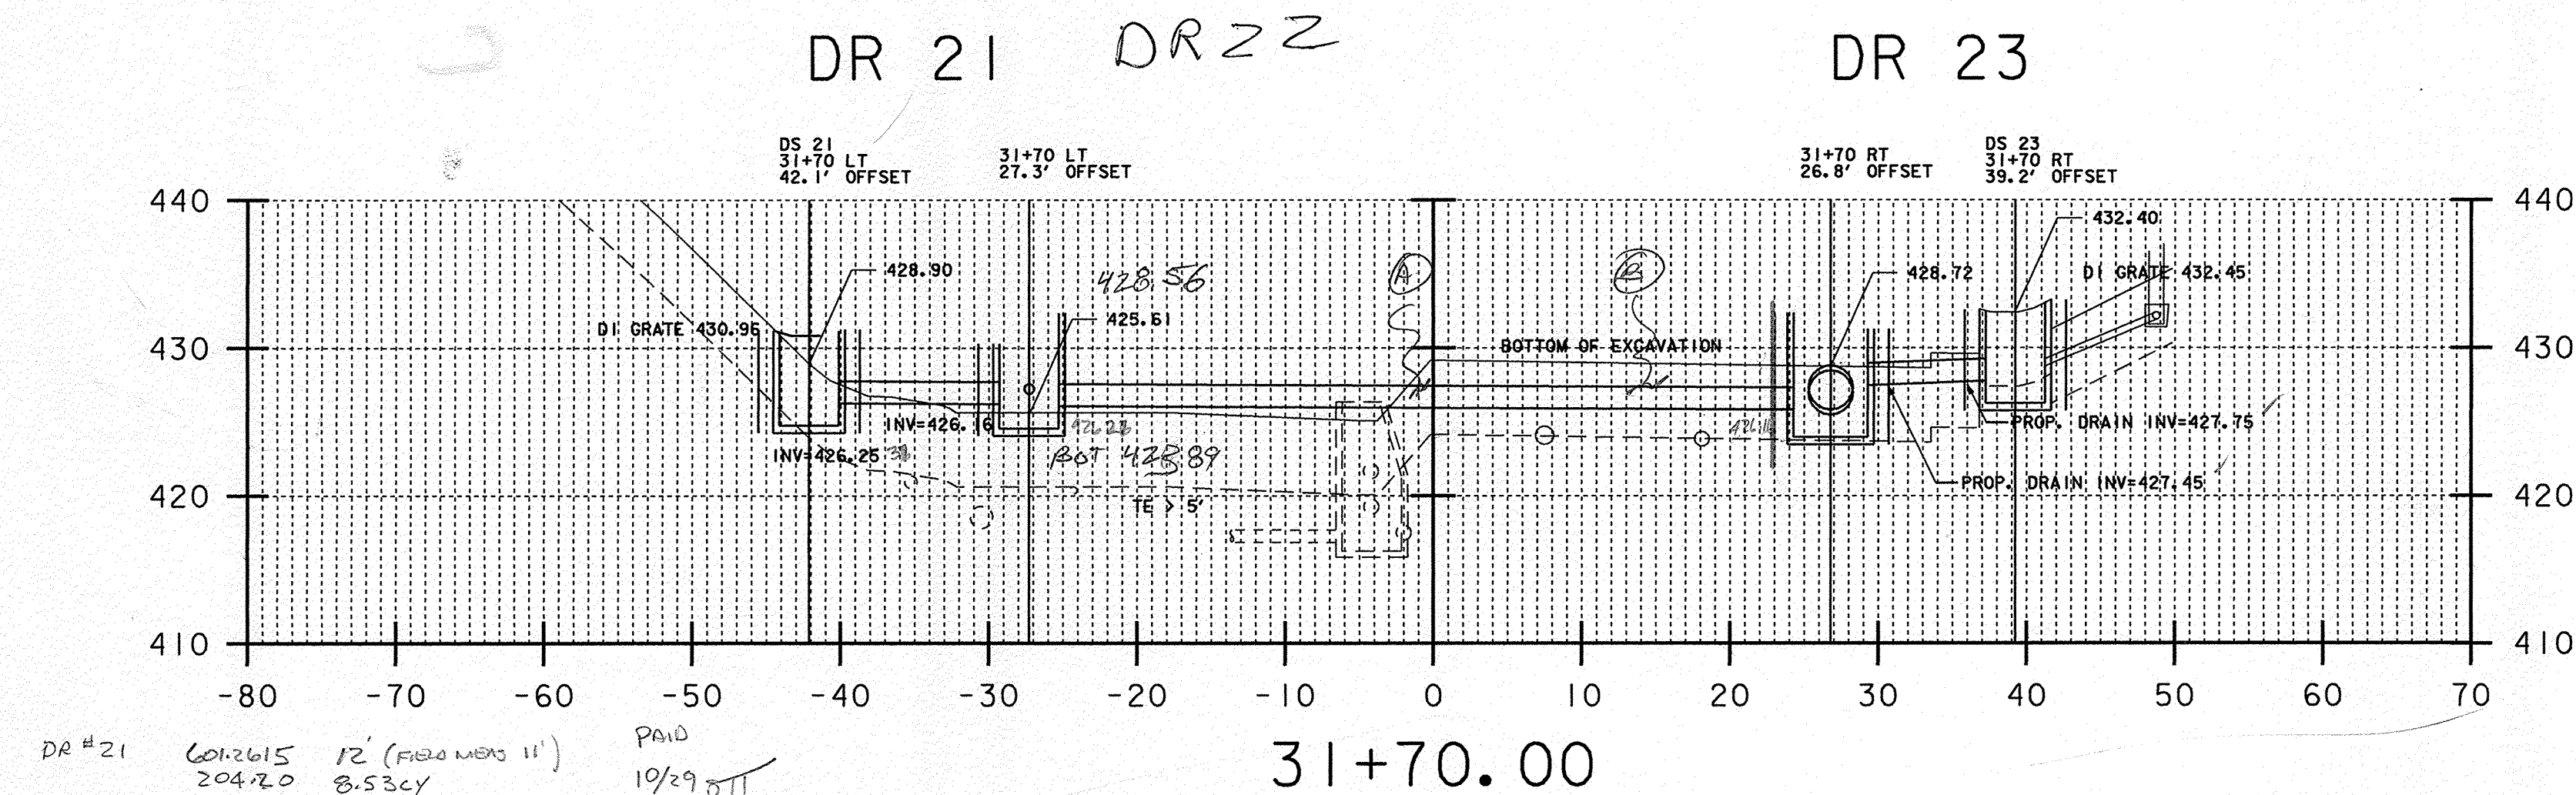

CALCULATED AND DRAWN BY TBG 1/31/08

CALCULATED AND DRAWN BY TBG 1/31/08

DR 21
 PIPE T.E. < 5'
 AREA (FROM CADD) = 1.63 SF * 3.75' = 6.11 CF/27 = 0.23 CY
 DS 21
 STRUCTURE T.E. < 5'
 $(5' + 2.7') / 2 * \pi (3.42')^2 = 141.47 \text{ CF/27} = 5.24 \text{ CY}$
 STRUCTURE T.E. > 5'
 $1.5 [(3.00' + 0.00') / 2] * \pi (3.42')^2 = 82.68 \text{ CF/27} = 3.06 \text{ CY}$
 TOT = 8.30 CY
 DR 21 GRANULAR BACKFILL
 $(3.75' * .88' * 10.0') - [(\pi (1.88')^2 / 2) * 10.0'] = 20.84 \text{ CF/27} = 0.77 \text{ CY}$

DR 23
 PIPE T.E. < 5'
 AREA (FROM CADD) = 7.46 SF * 3.75' = 27.98 CF/27 = 1.04 CY
 DS 23
 STRUCTURE T.E. < 5'
 $5' * \pi (3.42')^2 = 183.73 \text{ CF/27} = 6.80 \text{ CY}$
 STRUCTURE T.E. > 5'
 $1.5 [(1.82' + 1.65 + 2.0') / 3] * \pi (3.42')^2 = 109.13 \text{ CF/27} = 4.04 \text{ CY}$
 TOT = 10.84 CY
 DR 23 GRANULAR BACKFILL
 $(3.75' * .88' * 7.1') - [(\pi (1.88')^2 / 2) * 7.1'] = 14.79 \text{ CF/27} = 0.55 \text{ CY}$

DR 22
 CP#
 2/28/08

STRUCTURE
 $1.91 (\pi * 3.42^2) = 70.15 / 27 = 2.60 \text{ CY}$
 T.E. AREA
 $3 * 3.3 * 3.75 / 27 = .69 \text{ CY}$
 PIPE
 $(3.33 + 2.87 / 2) * 3.75 * 23' / 27 = 9.9 \text{ CY}$
 GRAN BKFL
 $(3.75 * 0.88 * 49') - [(\pi (1.88')^2 / 2) * 49'] = 3.78 \text{ CY}$

DR #	ITEM	PAID	DATE
18" CPEP	601.2615	20 LF	10/1/08
GRAN BKFL	204.30	1.1 CY	10/1/08
TRENCH BENT	204.20	9.9 CY	10/1/08
	601.2615	30 LF	10/28
	204.30	1.74	10/28
	604.20	.75 EA	10/28

PROJECT NAME: HARTFORD
 PROJECT NUMBER: RS 0113(40)

FILE NAME: \$\$\$FILENAME\$\$\$
 PROJECT LEADER: KEN UPMAL
 DESIGNED BY: K. ISHIKURA
 E. ATKINS
 PLOT DATE: 01-FEB-2008
 DRAWN BY: E. ATKINS
 CHECKED BY: K. ISHIKURA
 SHEET 220 OF 239