


DR 24

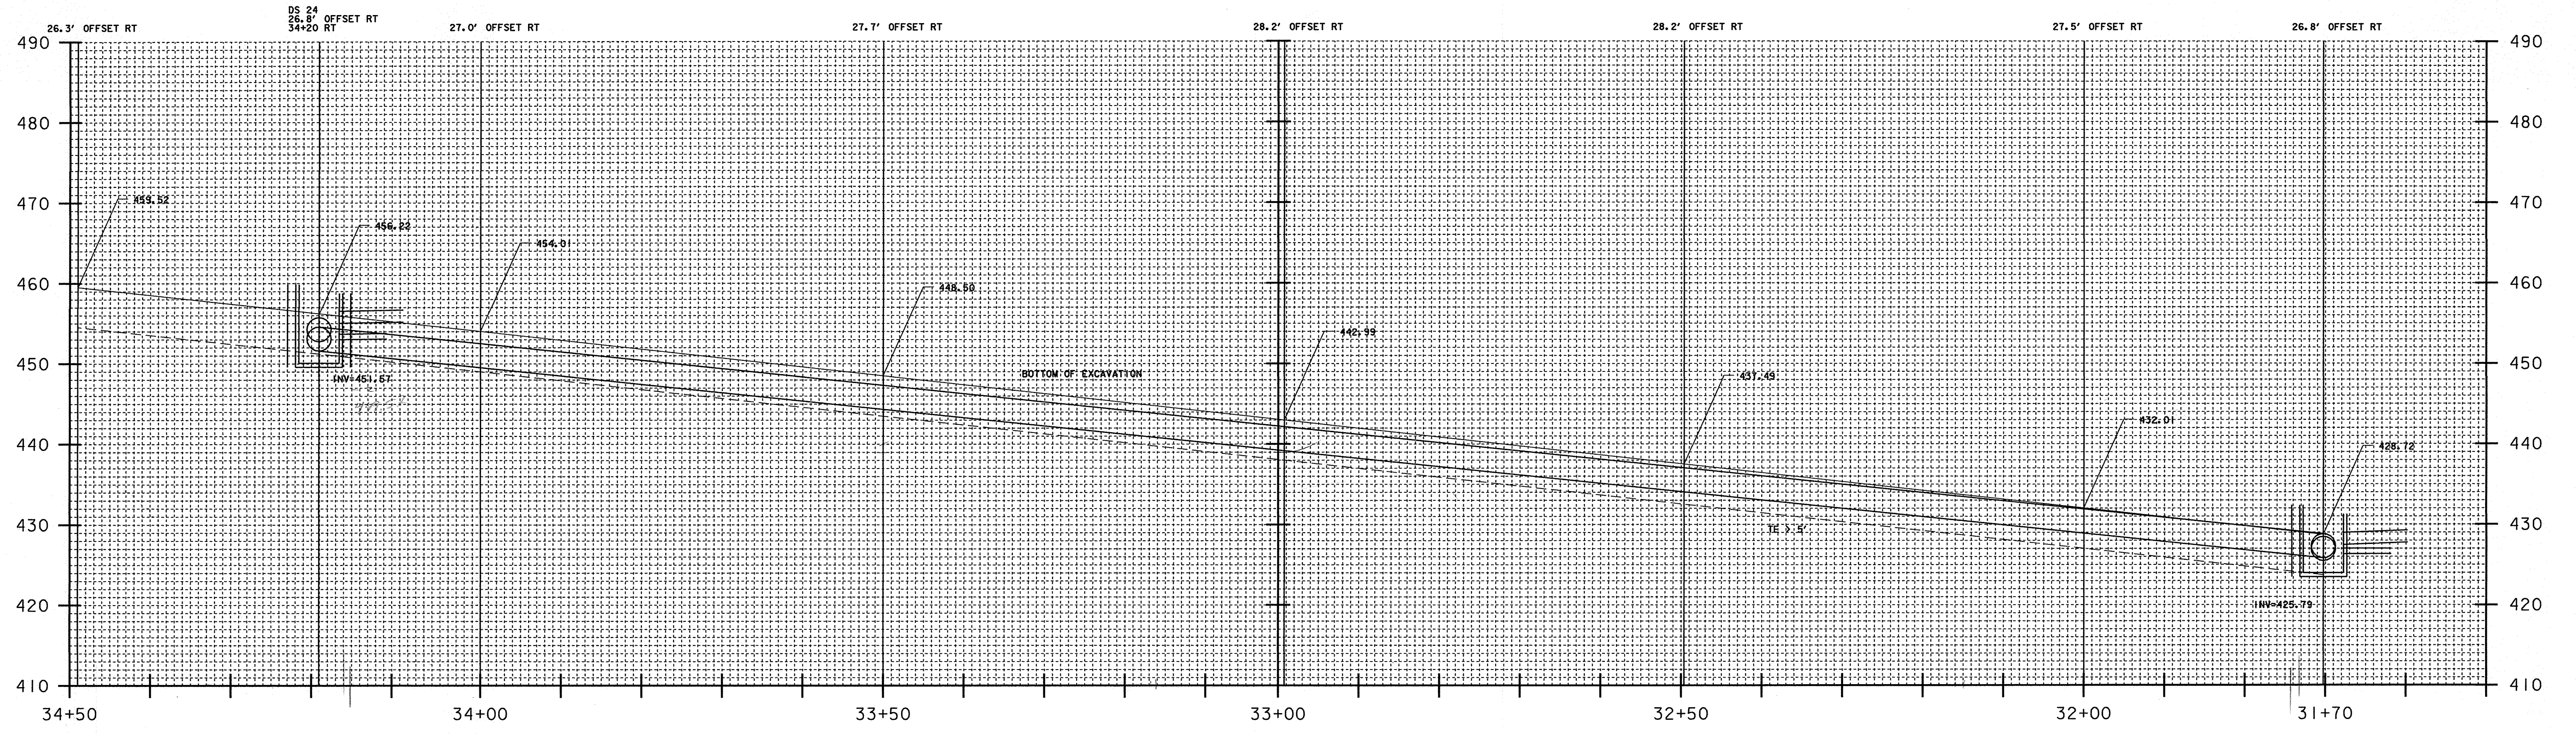

CALCULATED AND DRAWN BY TBG 2/05/08

DR 24

PIPE T.E. < 5'
 AREA (FROM CADD) = 914.71 SF * 5'-10' = 4665.02 CF/27 = 172.78 CY

DS 24

STRUCTURE T.E. < 5'
 5' * PI (4.00')² = 251.33 CF/27 = 9.31 CY

STRUCTURE T.E. > 5'
 $1.5 \left[\frac{(2.08' + 1.22')}{2} \right] * PI (4.00')² = 124.41 CF/27 = 4.61 CY$
 TOT = 13.92 CY

DR 24 GRANULAR BACKFILL
 $5' * 1.55' * 243.0' - \left[\frac{PI (1.55')²}{2} * 243.0' \right] = 1003.87 CF/27 = 37.18 CY$

3' deep x 240' x 5' = 2700 CY
 2945
 3125

186.33 CY
 200.25
 02/26/10

02/21/08

SHEET #11

PROJECT NAME: HARTFORD	PLOT DATE: 06-FEB-2008
PROJECT NUMBER: RS 0113(40)	DRAWN BY: E. ATKINS
FILE NAME: \$\$\$FILENAME\$\$\$	CHECKED BY: K. ISHIKURA
PROJECT LEADER: KEN UPMAL	SHEET 220 OF 239
DESIGNED BY: K. ISHIKURA	
E. ATKINS	