


DS-61 SAUNDER AVE
 STA 25+44 ~ 26+19 RT
 NEW 18" X 72' OF CPEP (SL)

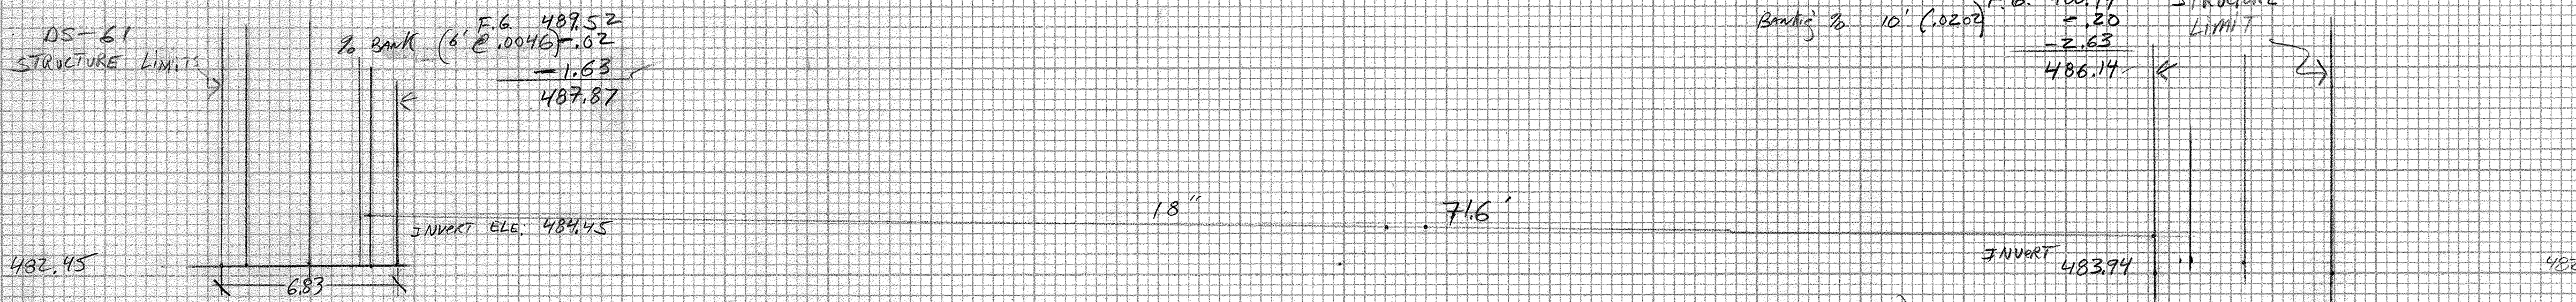

T.E DS-61 STRUCTURE

$$\frac{1}{2} \pi r^2 \times \text{length} = \frac{1}{2} \pi (3.42)^2 \times 71.6 = 199.06$$

$$\frac{1}{2} \pi r^2 \times \text{length} = \frac{1}{2} \pi (3.42)^2 \times 71.6 = 15.43$$

$$\frac{199.06 - 15.43}{27} = 6.67 \text{ cy}$$

Banking 1/2 10' (.0202) F.G. 488.97
 = .20
 = 2.63
 486.14

STRUCTURE LIMIT

6.B Length width (1/2 pipe depth)
 $71.6 \times 3.83 \times .92 = 252.49 = 9.34$

- 6B pipe $\frac{I r^2}{2} = \frac{71.6 \times 3.14 \times (.92)^2}{2} = 95.15 = 3.52$

5.82 cy

T.E pipe 68.5 FT

Avg depth $\frac{487.87 + 486.14}{2} = 487.005$

Avg depth $\frac{484.45 + 483.74}{2} = 484.095$


Length $\frac{487.005 - 484.095}{.0202} = 143.56$

Width 3.83

$143.56 \times 3.83 \times .92 = 500.86 = 18.55 \text{ cy}$

TBC 12/16/07
 CP# 12/07/07

DS-13 25+21.6 RT ~ 25+22.2 RT
 NEW 18" X 14' CPEP S.L.

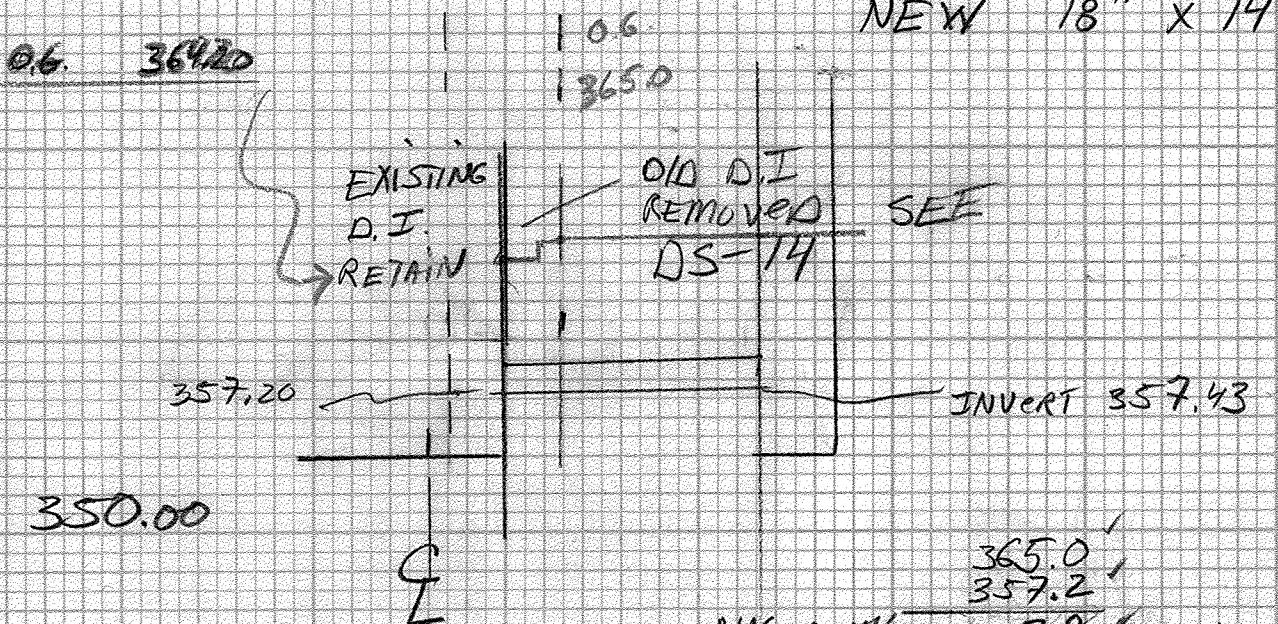

Pipe T.E

Avg depth $\frac{365.0 + 357.2}{2} = 361.1$

Avg depth $\frac{365.00 + 359.43}{2} = 362.215$

Length $\frac{361.1 - 362.215}{.0202} = -55.2$


Width 3.75

$55.2 \times 3.75 \times 10 = 2070$

$15 \times 2.69 \times 3.75 \times 10 = 1500$

$\frac{2070 - 1500}{27} = 21.11 \text{ cy}$

12.55 cy
 2070/100 = 20.7
 20.7 - 8.15 = 12.55

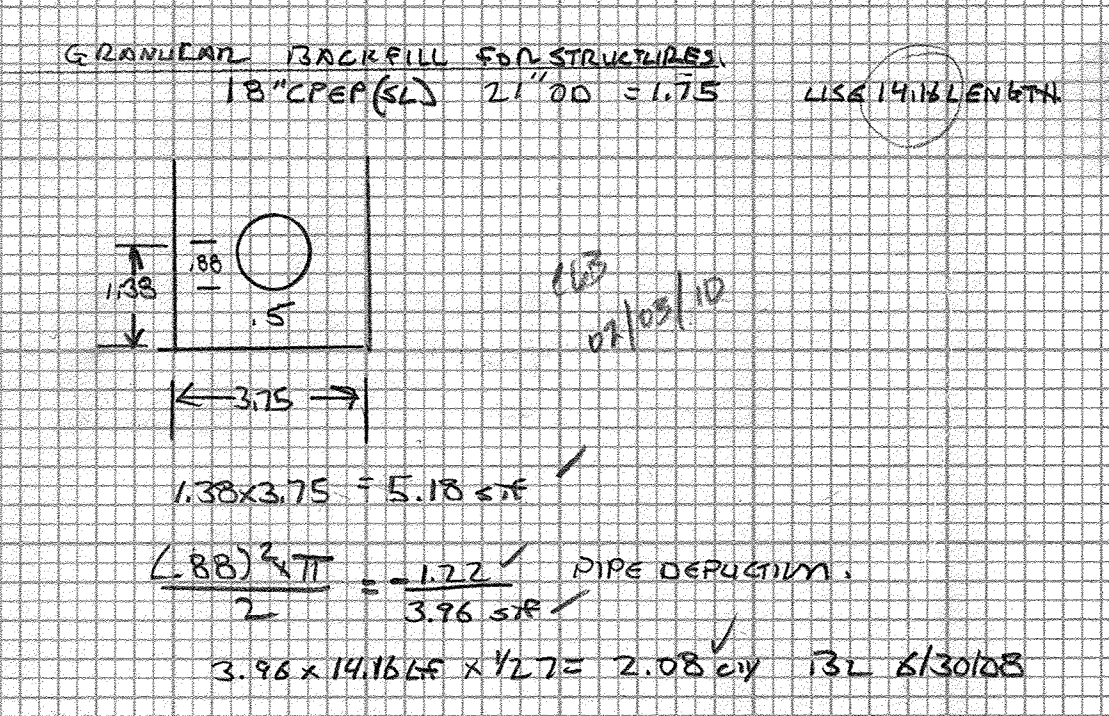

ORIGINAL SURVEY NO.	DATE
FLORIDA SURVEYING	
NOTE BOOK	
AREAS CIRCLED	

FINAL SURVEY NO.	DATE
FLORIDA SURVEYING	
NOTE BOOK	
AREAS CIRCLED	

HARTFORD RS 0113(40)