


PRECAST WALL PLAN LAYOUT - BARNES AVENUE
 1/2" = 1'-0"

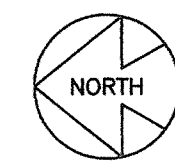


ELEVATIONS FOR PAD AT PRECAST CONCRETE PANELS							
PAD MARK	ELEV. TOP OF PAD	PAD MARK	ELEV. TOP OF PAD	PAD MARK	ELEV. TOP OF PAD	PAD MARK	ELEV. TOP OF PAD
P1	395.21	P9	385.17	P17	381.24	P25	374.43
P2	394.33	P10	387.29	P18	380.36	P26	373.85
P3	393.45	P11	386.52	P19	379.48	P27	372.86
P4	392.57	P12	385.64	P20	378.60	P28	372.19
P5	391.69	P13	384.76	P21	377.73	P29	371.44
P6	390.81	P14	383.88	P22	376.85	P30	370.94
P7	389.93	P15	383.00	P23	376.03	P31	370.23
P8	389.05	P16	382.12	P24	375.20	P32	369.52

NOTE: PAD ELEVATIONS ADJUSTED TO PROVIDE PROPER COVER OVER UNDER-DRAIN PIP.

ELEVATION OF PRECAST WALL PANELS - BARNES AVENUE
 1/2" = 1'-0"

* NOT REVIEWED

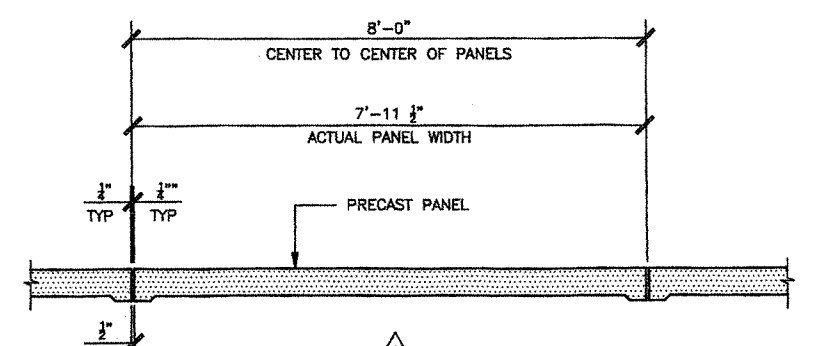

TYP. PANEL JOINT DETAIL
 1/2" = 1'-0"

GRISWOLD
 S.T. Griswold & Co., Inc.
 125 Innovation Ave
 PO Box 519
 Ferrisburgh, VT 05455
 Tel: 802-526-0855
 Fax: 802-526-0856
Architectural Precast Division

NPCA
 CERTIFIED PLANNING

NOTE:
 This shop drawing represents ST Griswold's interpretation of the professional design and specifications and our contract requirements for this project.
 Prior to manufacture of panels from this drawing, all dimensions, method of construction, and placing conditions must be checked, noted and approved by ST Griswold Client.

GENERAL NOTES:
 1) All rebar and control joints are approved to be 3/8"
 2) All angles within an anchor are 90°
 3) All rebar must be as specified by others
 4) All bar markings to be supplied by others
 5) All bar markings to be supplied by others
 6) All bar markings to be supplied by others

Approval Stamp:
 The undersigned has reviewed this drawing and by returning it to ST Griswold has indicated approval for fabrication and

Approved
 Approved as noted
 Resubmit for record
 Make and Resubmit

By: _____ Date: _____
 (Signature) (Date)
 For: _____
 (Name)
 Company: _____

* Please make note that revisions may affect pricing and lead time.

No.	DATE	REVISION
1	6/3	REVISED PER APPROVAL NOTATIONS

McFarland Johnson
 40 FARRELL STREET
 SOUTH BURLINGTON, VT 05403
 Tel: (802) 862-5381
 Fax: (802) 862-7450

TOWN OF HART FORD
COUNTY OF WINDSOR
U.S. ROUTE 5 (MAJOR COLLECTOR)
HARTFORD
 VERMONT
 PRECAST WALL PANELS - BARRIER

DRAWN	APPROVED	PROJ. No.
GAB		17185.00
CHECKED	SCALE	DATE
RED	AS NOTED	4/28/08

PC-1