


**UPPER WALL PROFILE**



**LOWER WALL PROFILE**

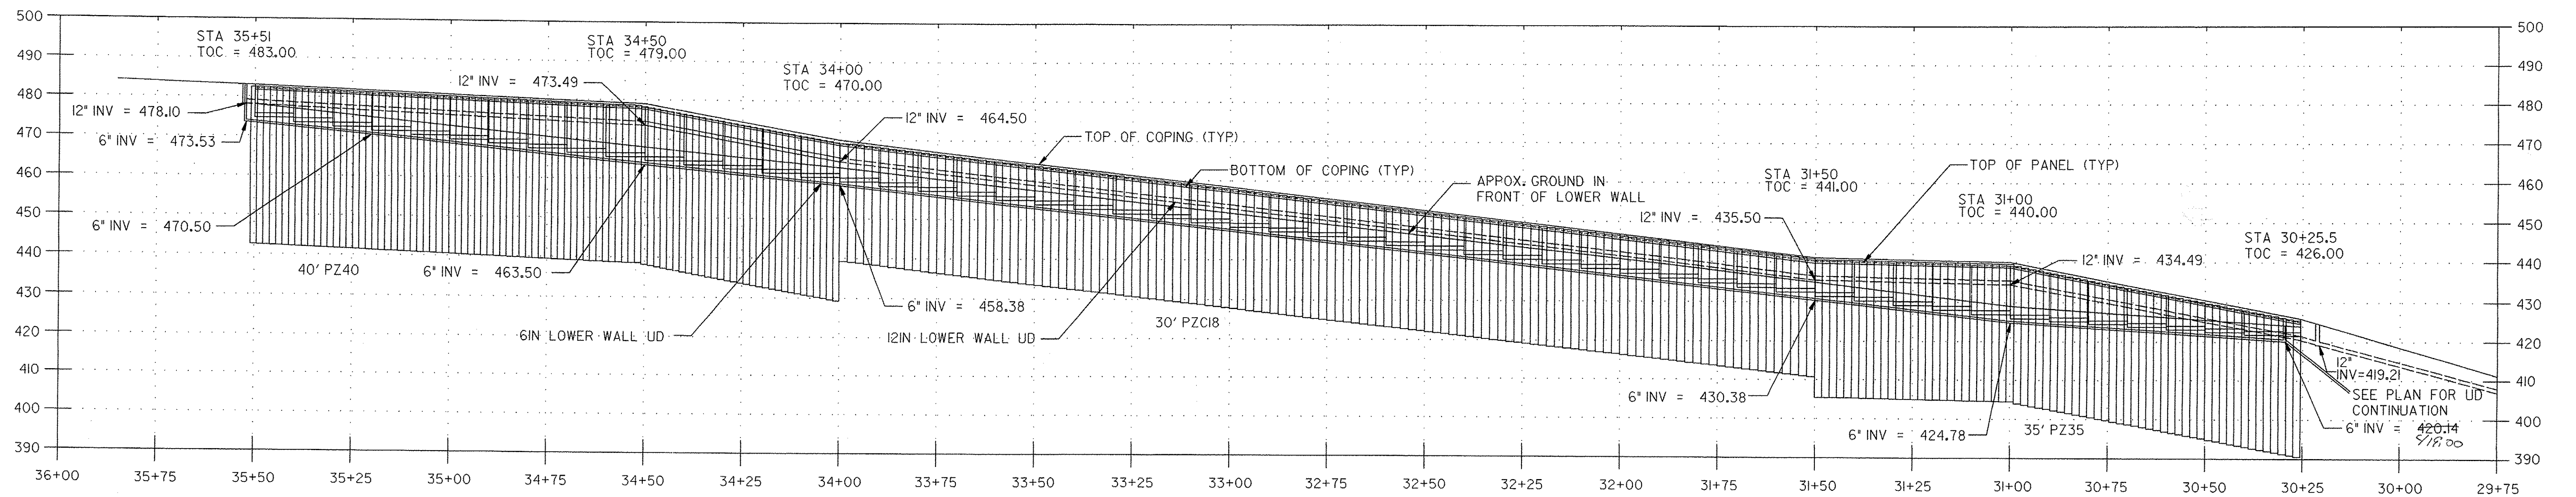

PROJECT NAME:	HARTFORD
PROJECT NUMBER:	RS 0113(40)
FILE NAME:	Lower wall elevation view.dgn
PROJECT LEADER:	D. HOWEY
DESIGNED BY:	D. HOWEY
PLOT DATE:	3/13/2008
DRAWN BY:	G. BARRETT
CHECKED BY:	D. WOTRING
SHEET	3 OF 14