


31+70.00

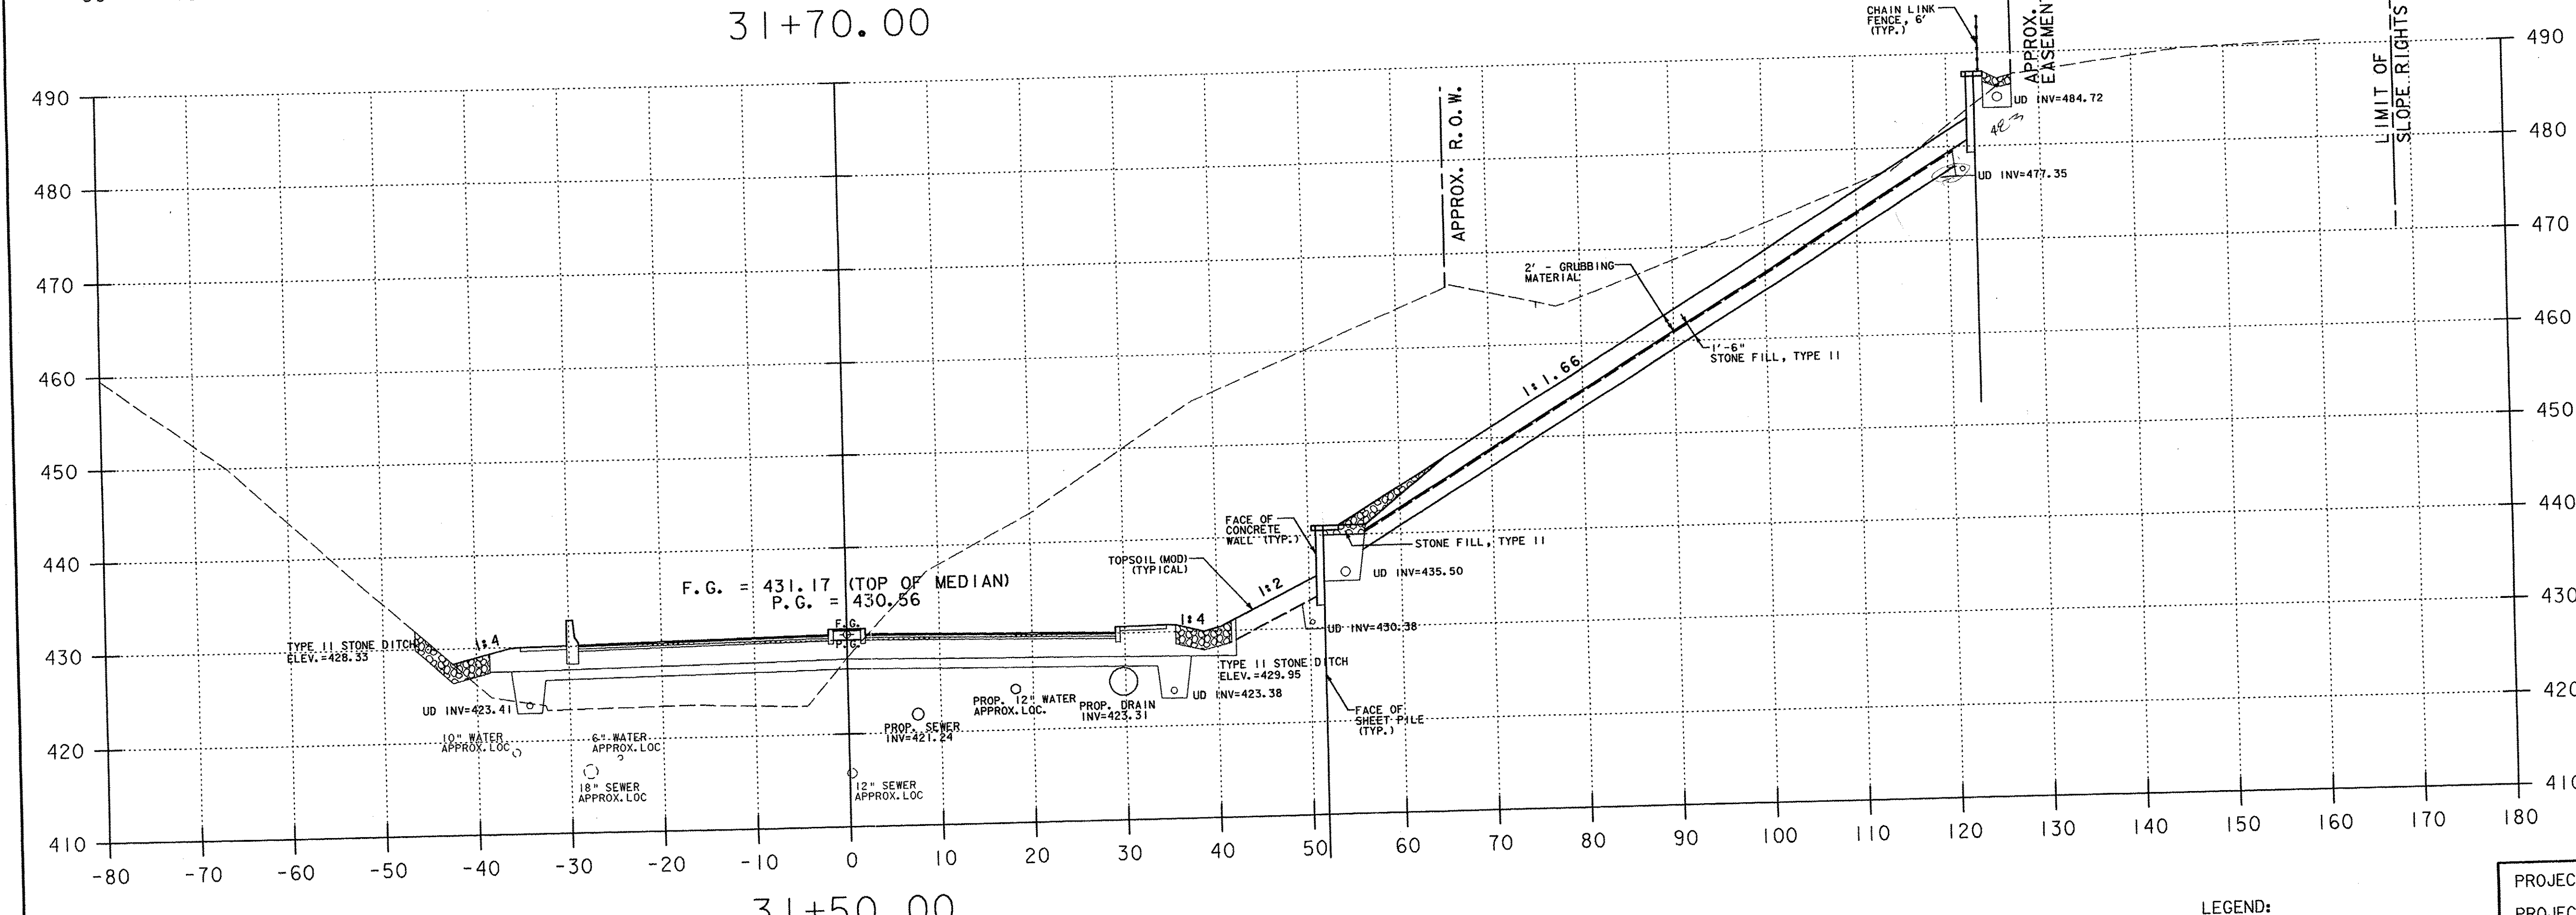

31+50.00

- NOTES:
- REFER TO ROADWAY LAYOUT AND UTILITY LAYOUT SHEETS FOR PROPOSED ABANDONMENT, REMOVAL, OR PROTECTION REQUIREMENTS OF EXISTING UTILITIES IN CONFLICT WITH PROPOSED WORK.
 - THE WALL SHOWN ON THE SECTIONS IS FOR PRESENTATION ONLY. SEE U.S. RTE. 5 SHEET PILE WALL PLAN AND PROFILE SHEETS AND DETAIL SHEETS FOR CONSTRUCTION REQUIREMENTS.

LEGEND:
 F.G. FINISHED GRADE
 P.G. PROFILE GRADE

U.S. ROUTE 5 HARTFORD AVENUE

PROJECT NAME:	HARTFORD	PLOT DATE:	3/13/2008
PROJECT NUMBER:	RS 0113(40)	DRAWN BY:	T. DUGUAY
FILE NAME:	...z86c027xsl.DGN	CHECKED BY:	D. WOTRING
PROJECT LEADER:		SHEET	5 OF 14
DESIGNED BY:	D. HOWEY		