


M:\CL\1070\12-2-08\COMPLETED FILES 3-13-08\ACAD COPY of 286-c027\walldet.dwg

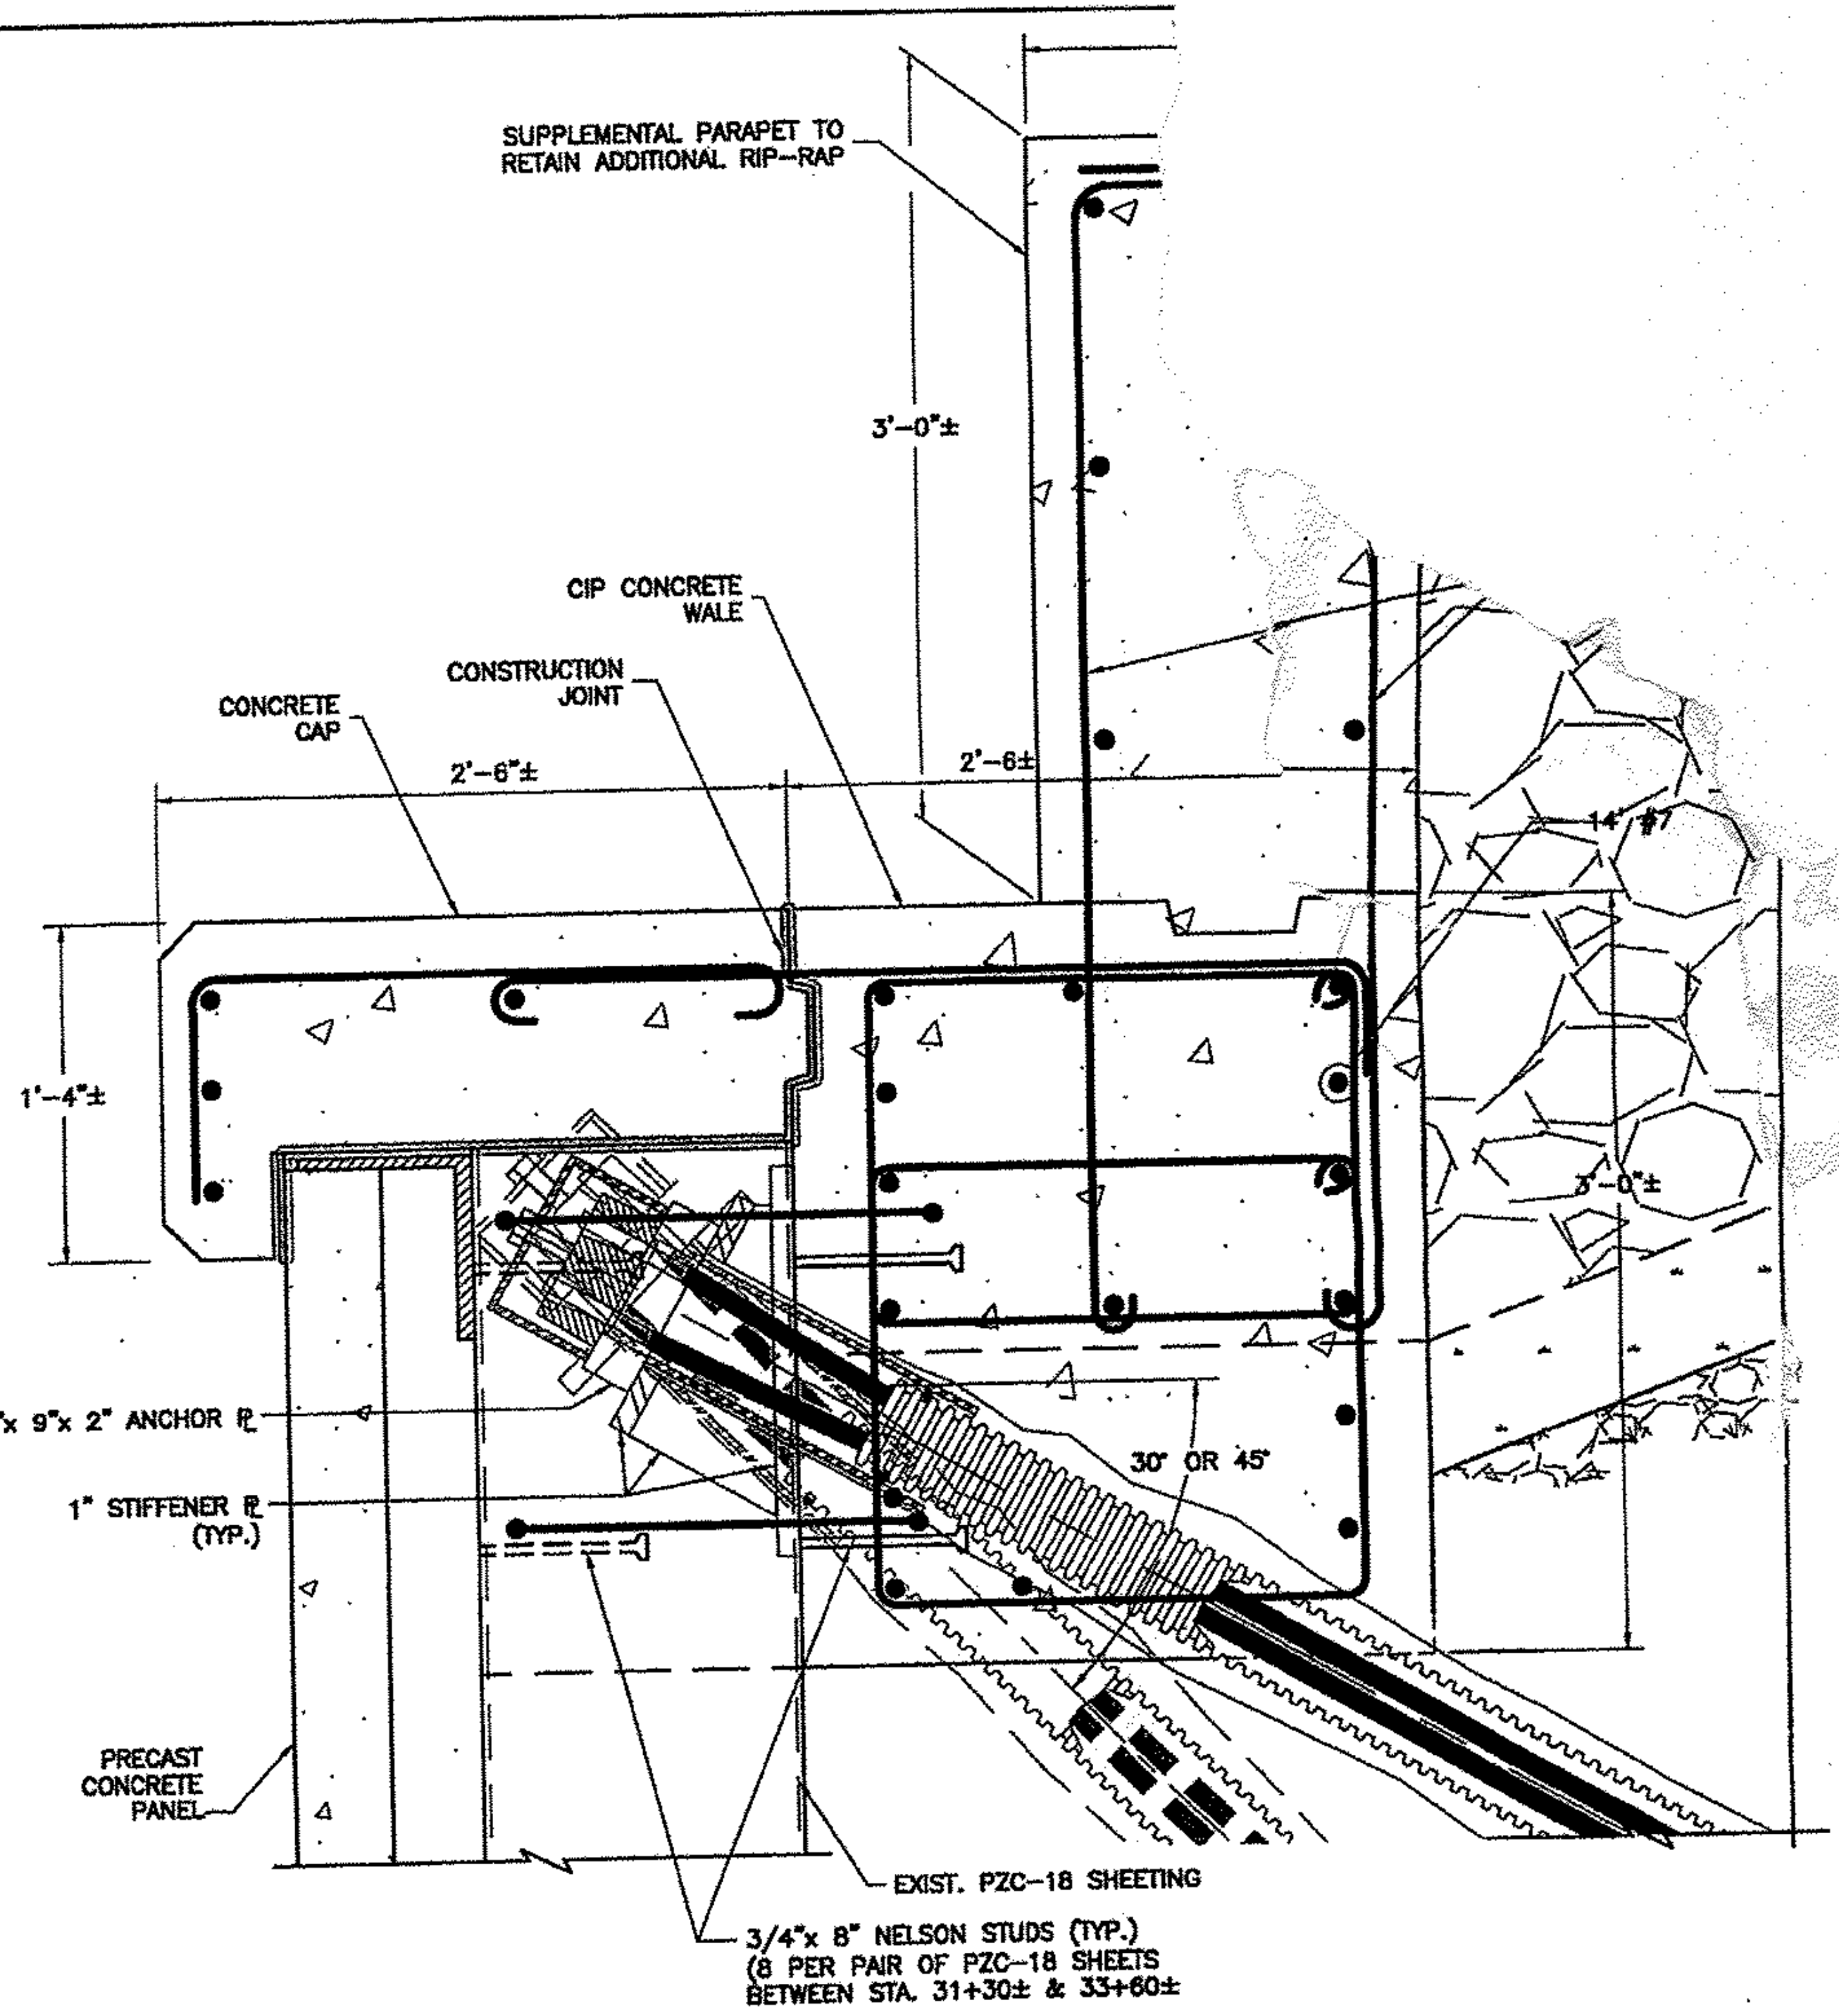

TYPICAL SECTION A-A




GEOTECHNICAL ENGINEERS • ENVIRONMENTAL CONSULTANTS
 984 SOUTHFORD ROAD • MIDDLEBURY CONNECTICUT 06762
 TELEPHONE: (203)758-8836 FACSIMILE: (203)758-8842

DRAWN BY: SMC

REVIEWED BY: WJF

US ROUTE 5
 HARTFORD, VERMONT
 STATE PROJECT NO. RS 0113(40)

TIEBACK DETAIL SKETCH

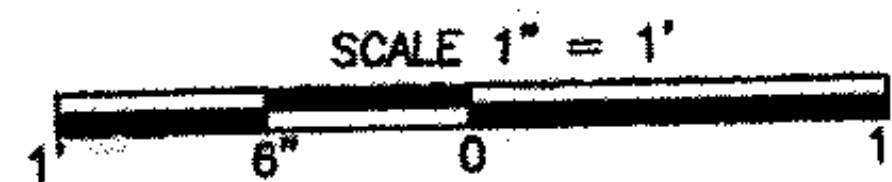

PROJECT NO. 1070-01.5

DATE: 12/11/08

FIGURE NO. SK-2