


TYPICAL SECTIONS & DESIGN DATA

ITEM 406.25 BITUMINOUS CONCRETE PAVEMENT
LEVELING COURSE, TYPE III OR IV (SEE TABLE BELOW)
AS DIRECTED BY THE ENGINEER
1" WEARING COURSE, TYPE III

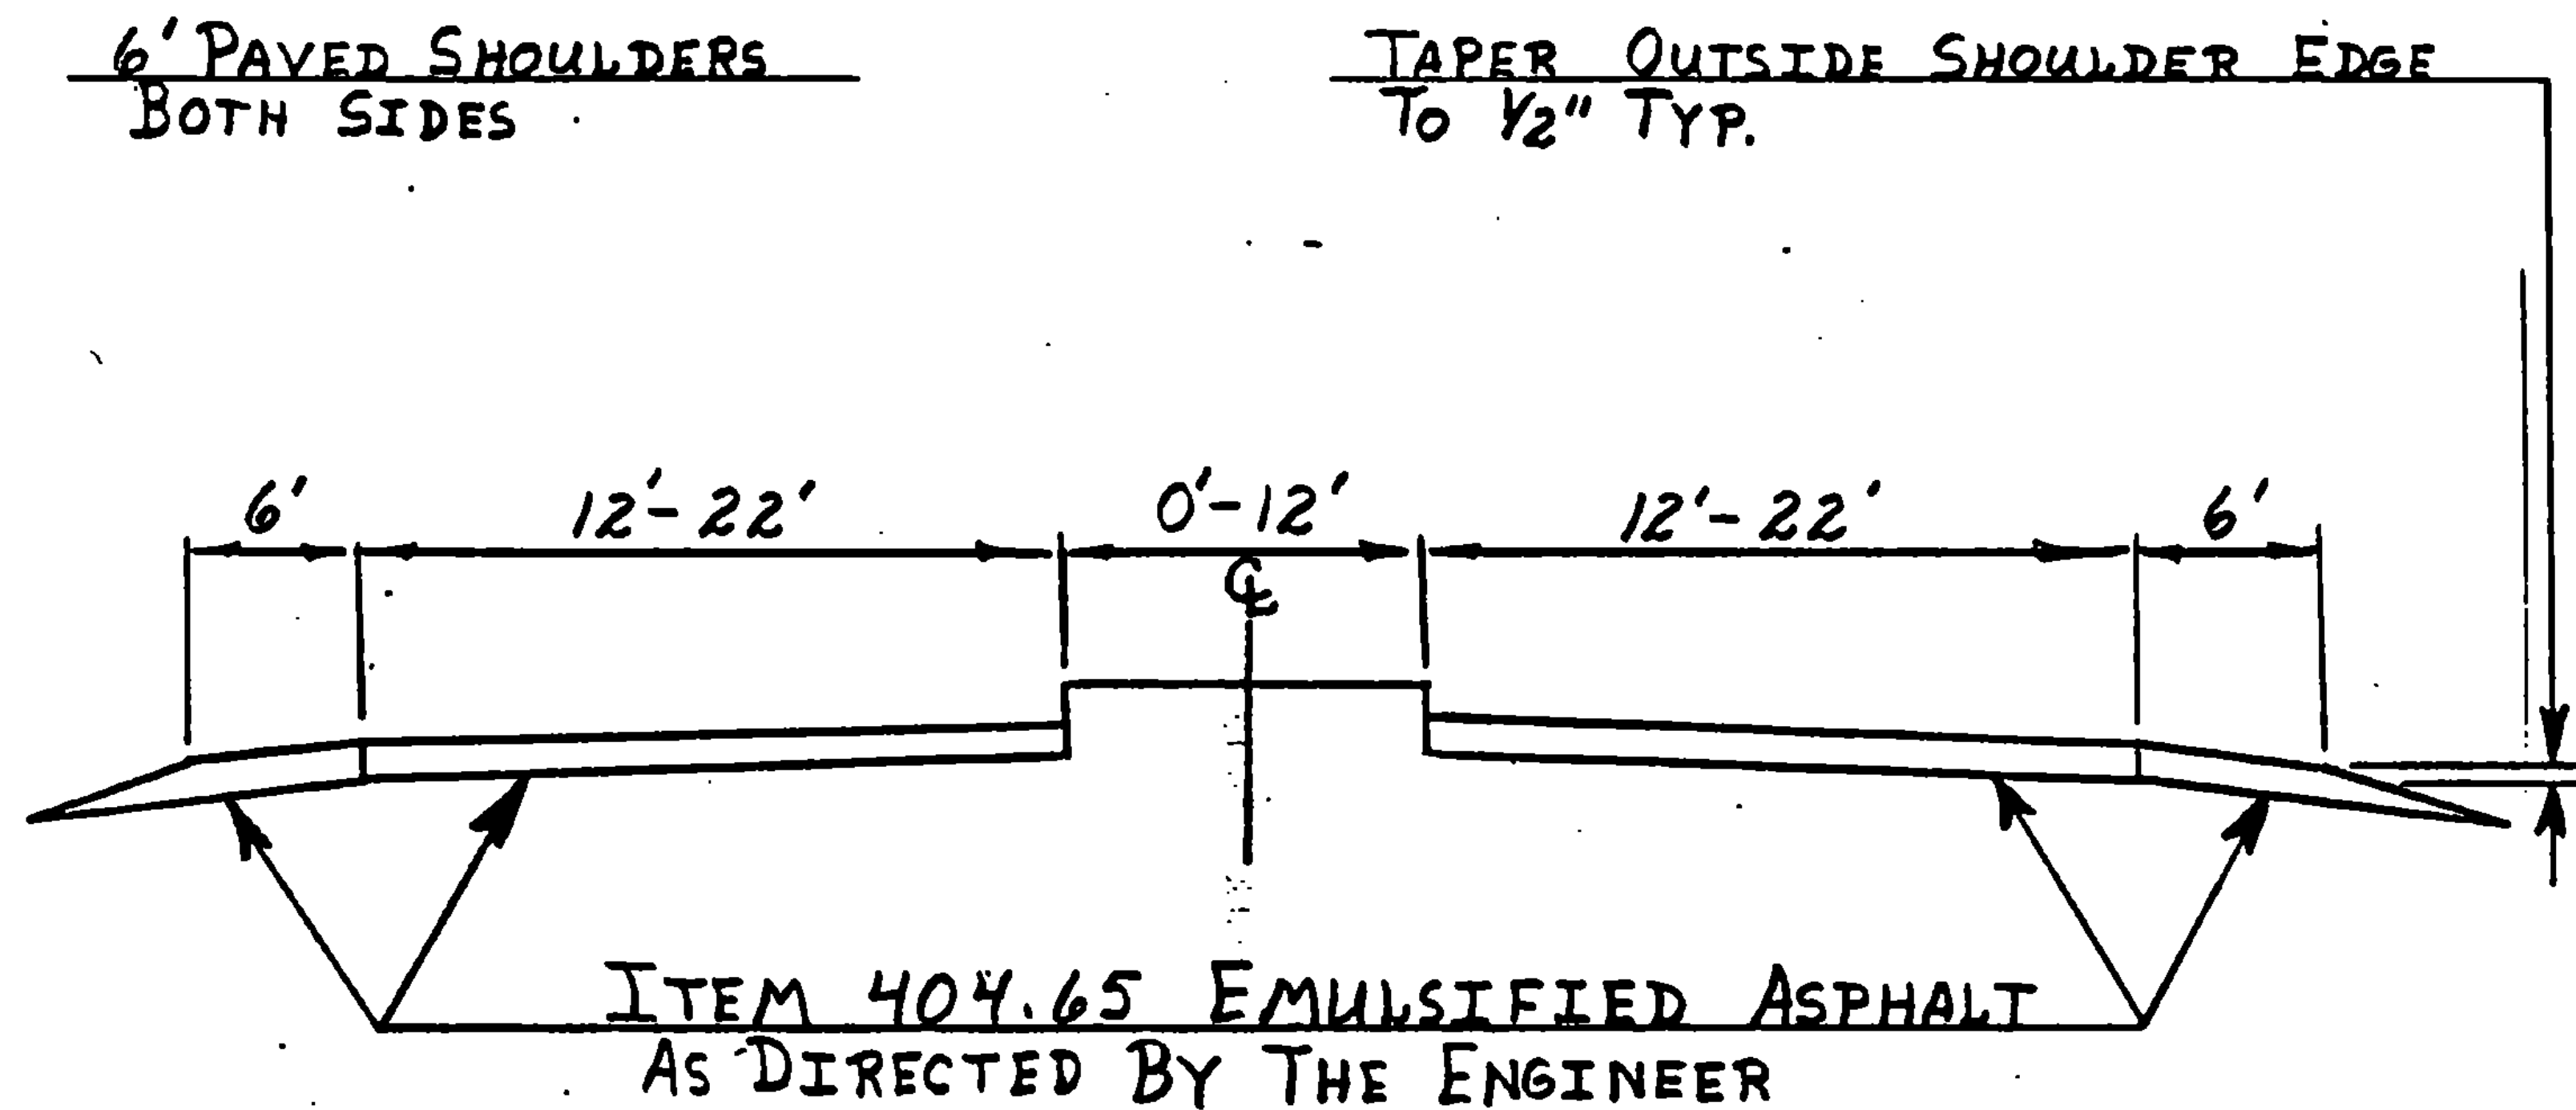

DISTANCE	WIDTH PAVED SHOULDER	WIDTH TRAVELED WAY	WIDTH MEDIAN	WIDTH PAVED SHOULDER	LEVEL TONNAGE/MT.
MM 1.11-1.26	6	44	4' UNPAVED	6	500
MM 1.27-1.31	6	36	12' UNPAVED	6	409
MM 1.31-1.35	6	24	0-12' PAVED	6	341