


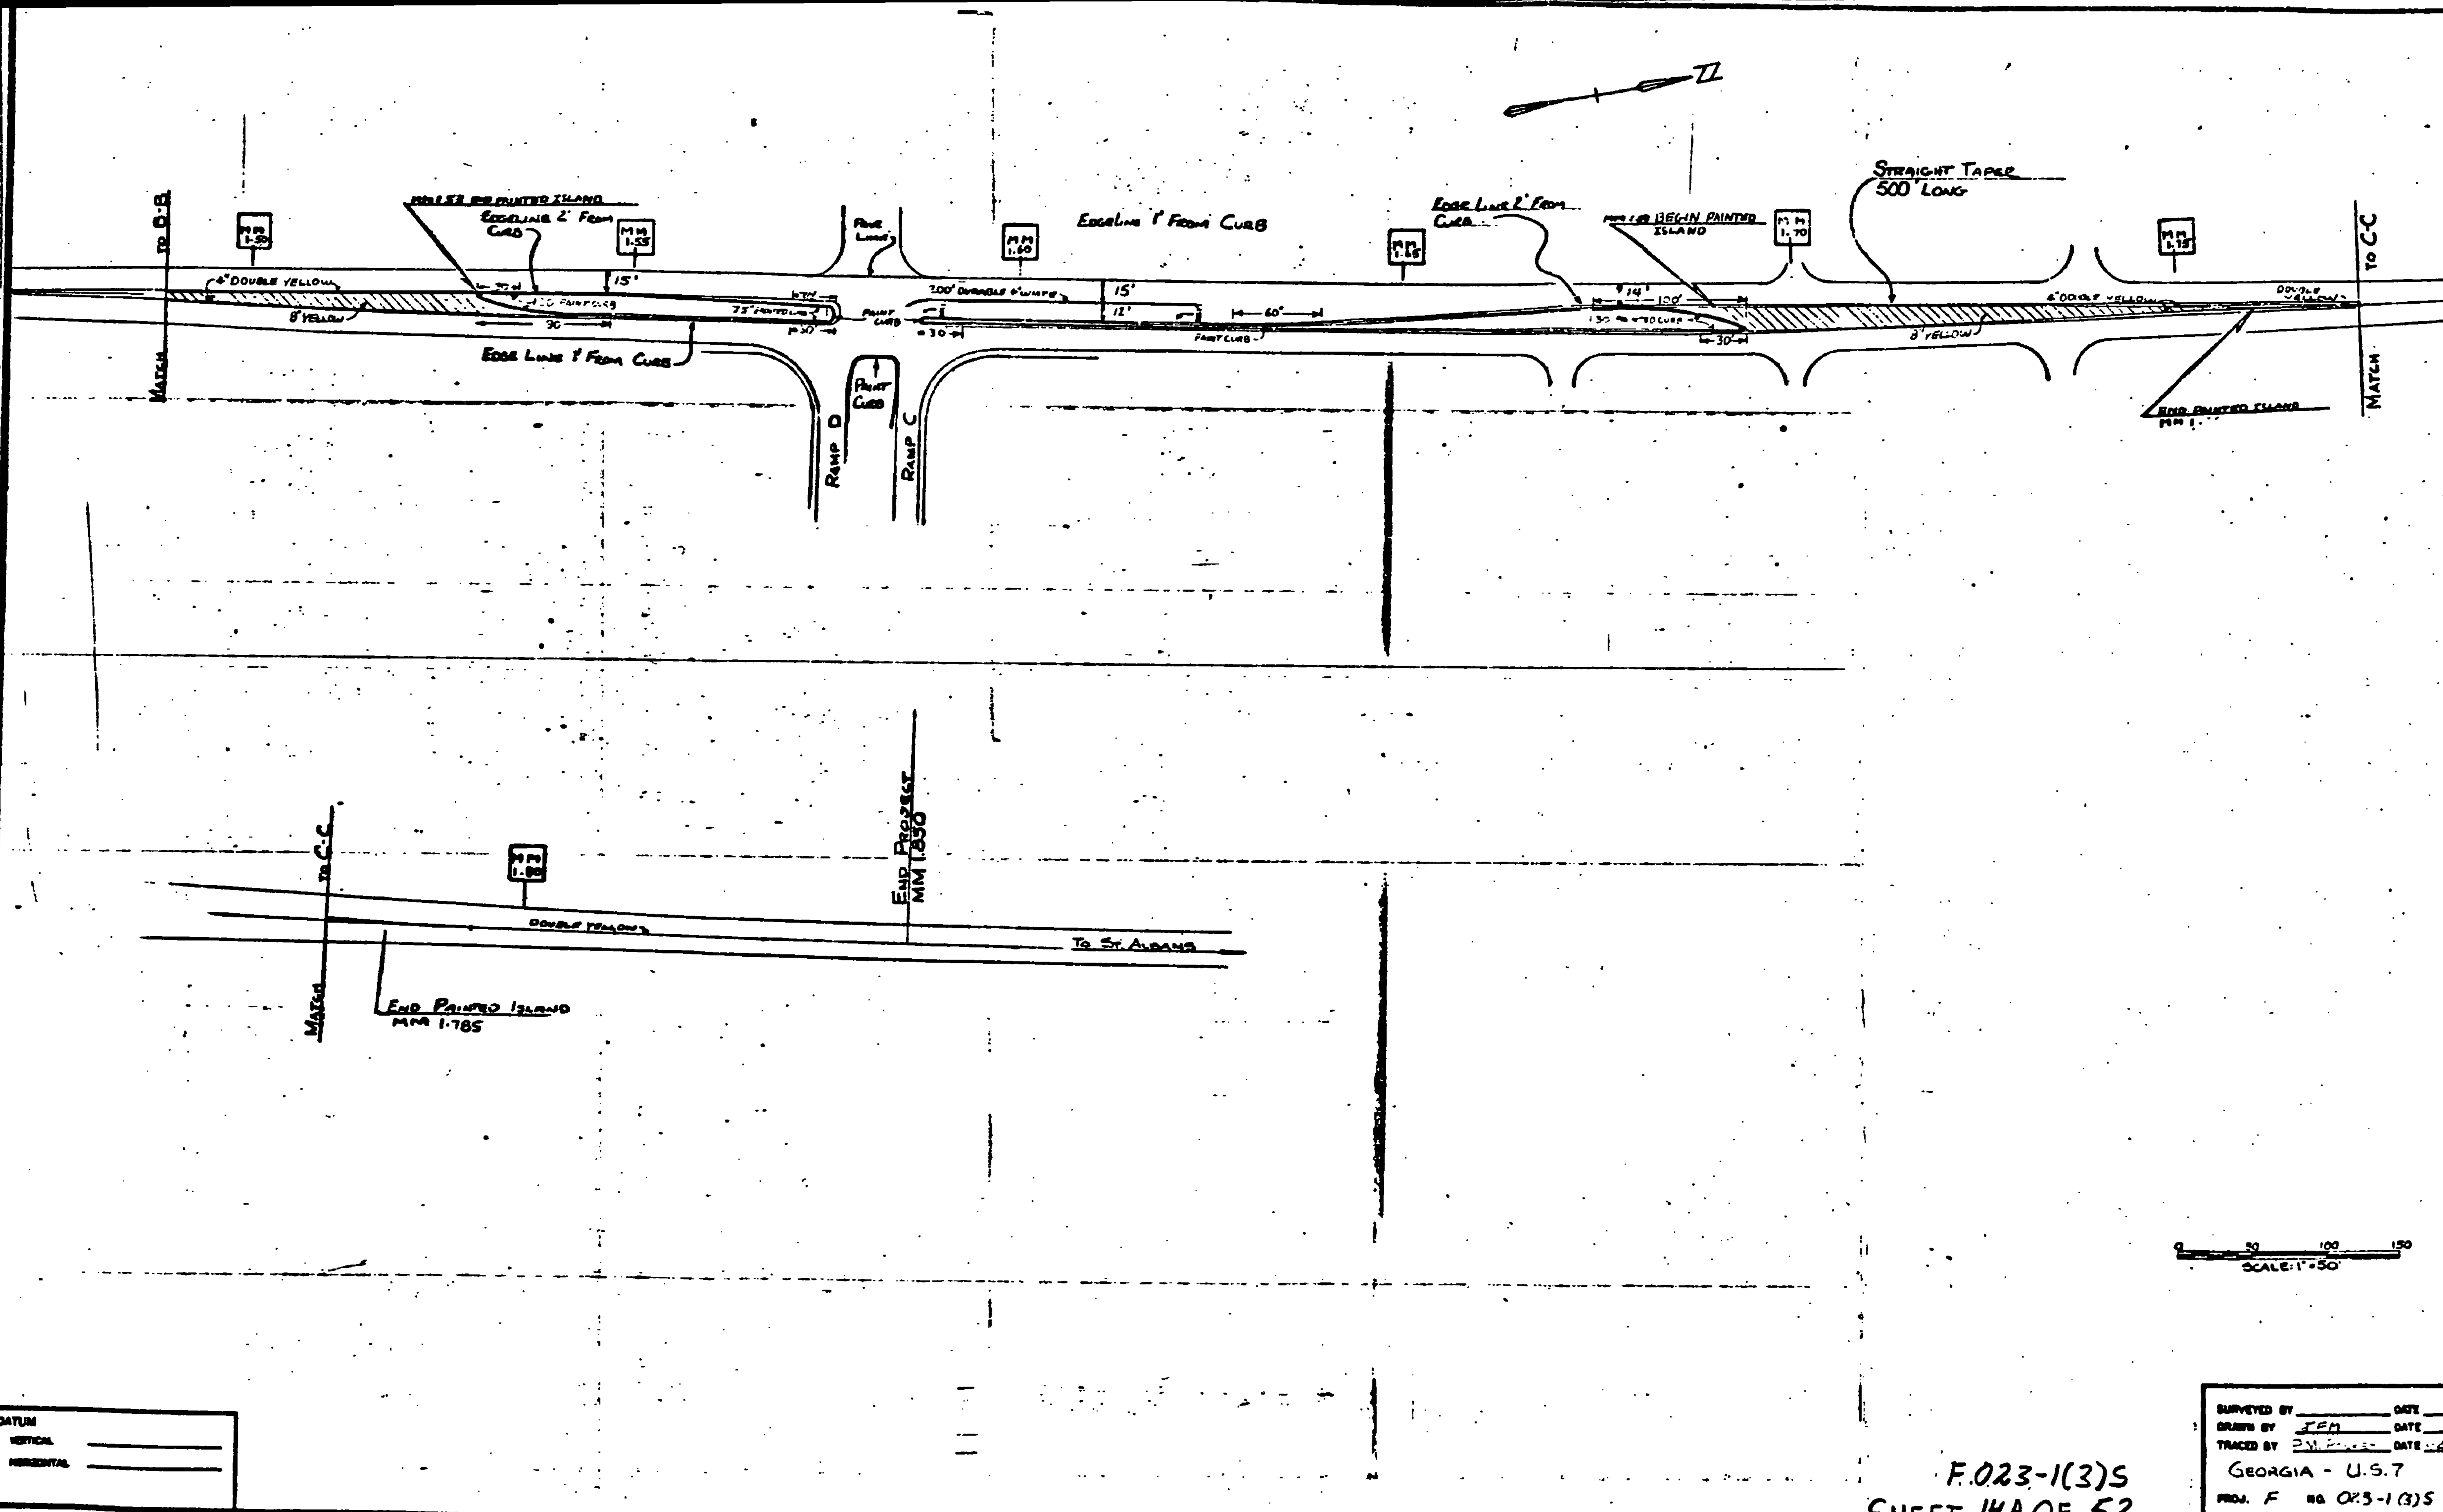

DATUM	_____
VERTICAL	_____
HORIZONTAL	_____

F.023-1(3)S
 SHEET 14A OF 52

SURVEYED BY	_____	DATE	_____
DRAWN BY	JEM	DATE	_____
TRACED BY	_____	DATE	_____
GEORGIA - U.S. 7			
PROJ. F	NO. 023-1(3)S		
SHEET	14A		