


PROJECT DESCRIPTION AND LOCATION

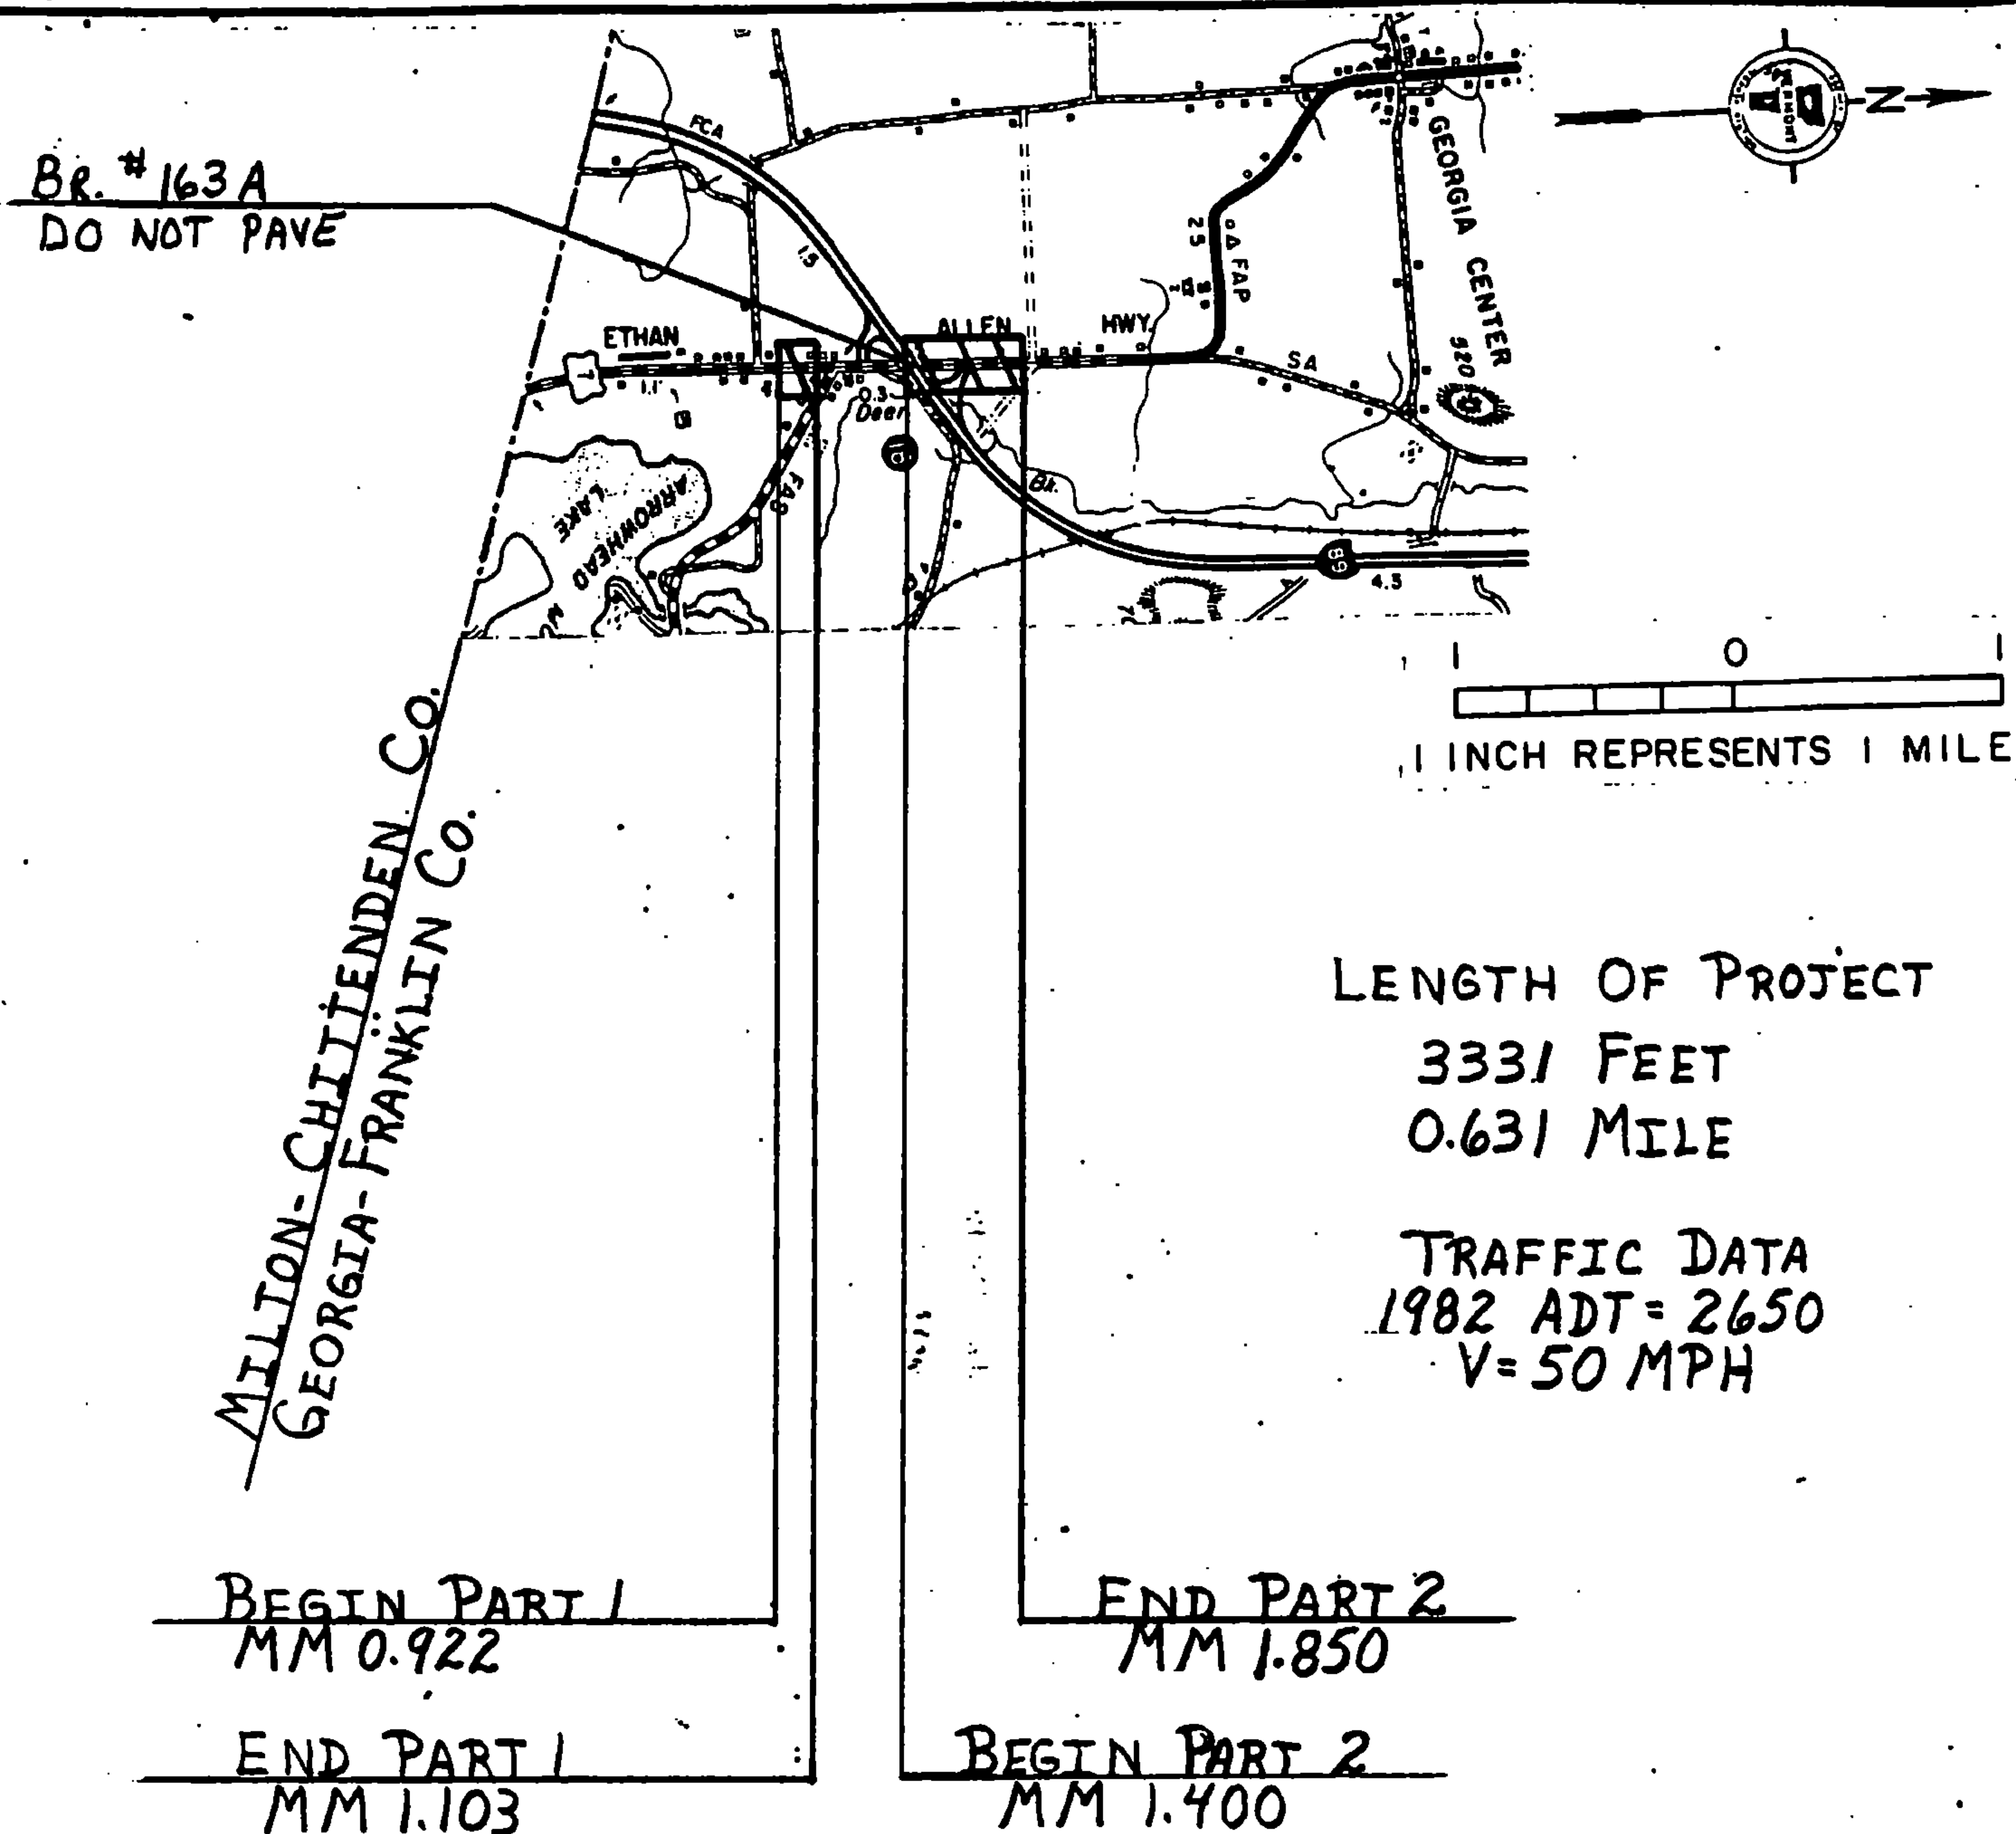

THIS PROJECT IS DIVIDED INTO TWO PARTS - PART 1 BEGINS AT A POINT ON U.S. RTE 7 APPROX. 1 MILE NORTH OF THE MILTON-GEORGIA TOWN LINE AT MM 0.922 AND EXTENDS TO MM 1.103. PART 2 BEGINS AT MM 1.400 AND EXTENDS TO MM 1.850.