



SPECIAL MARKING DETAILS

Painted Island Detail

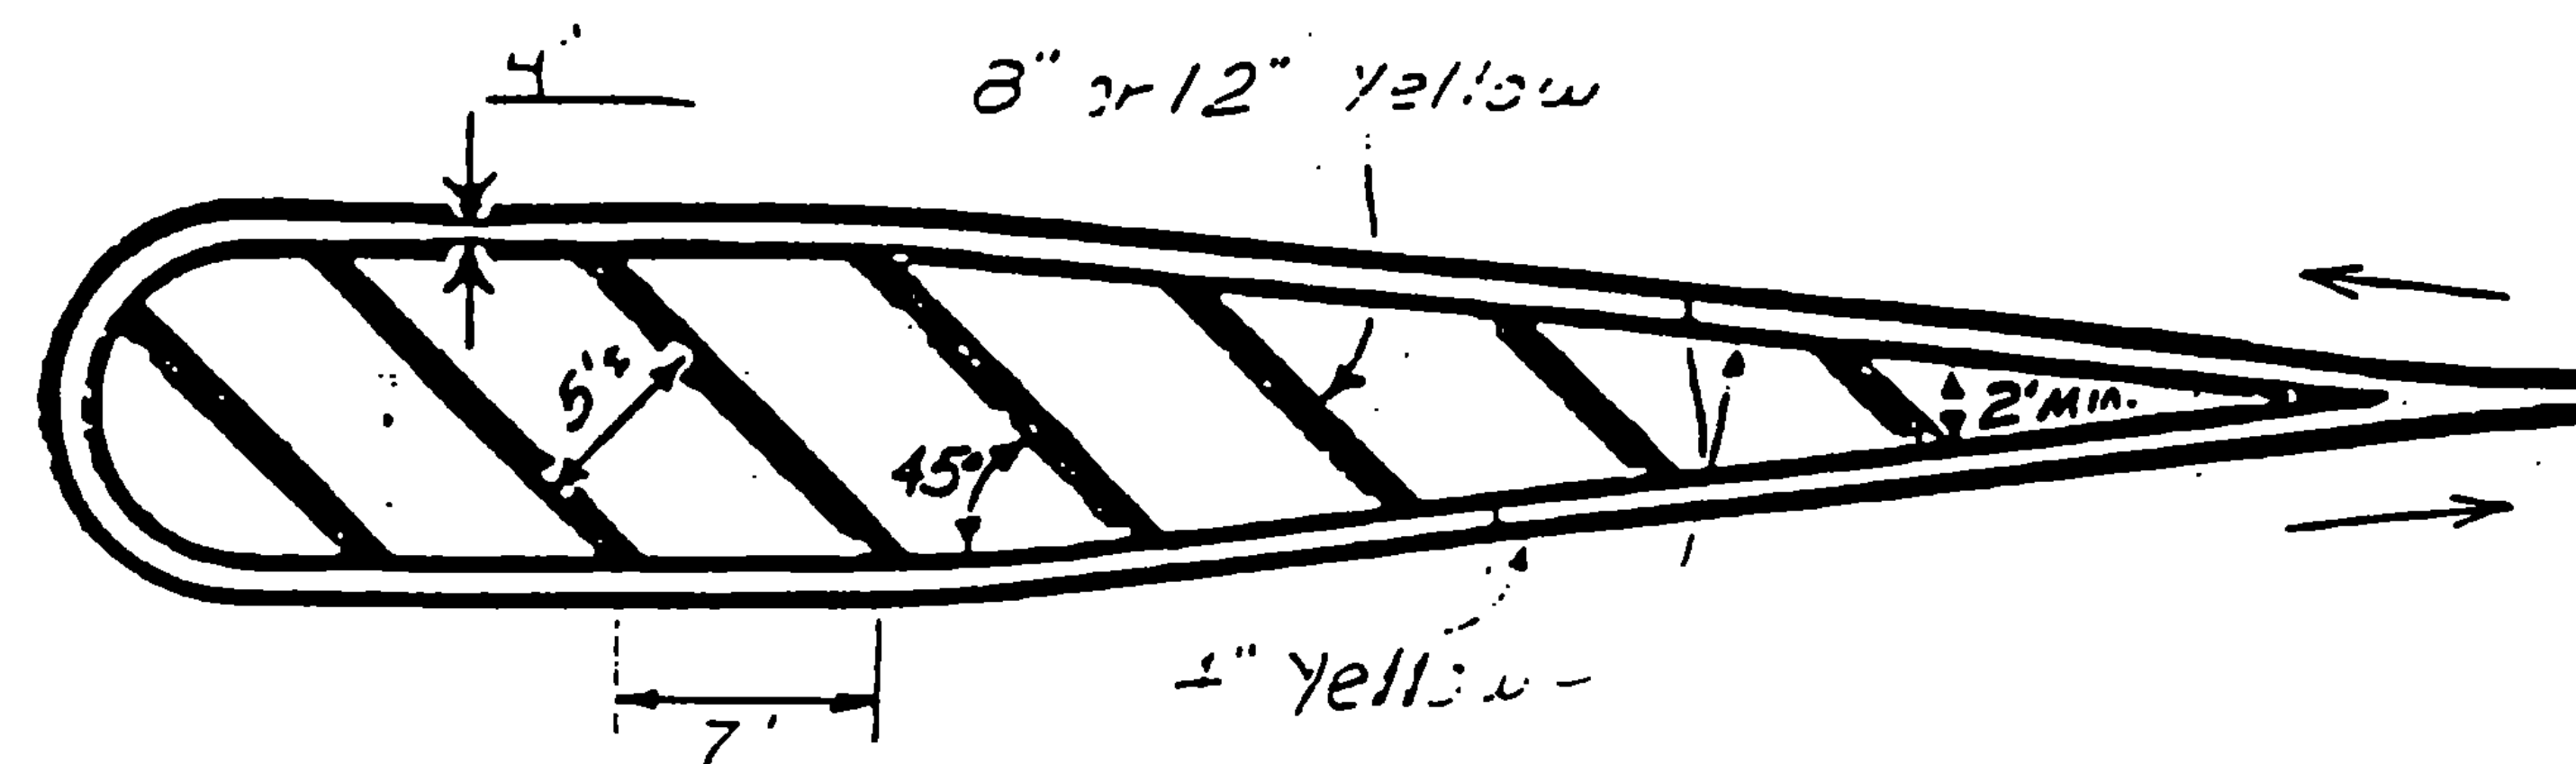


Not to Scale

Gore Marking Detail - Exit

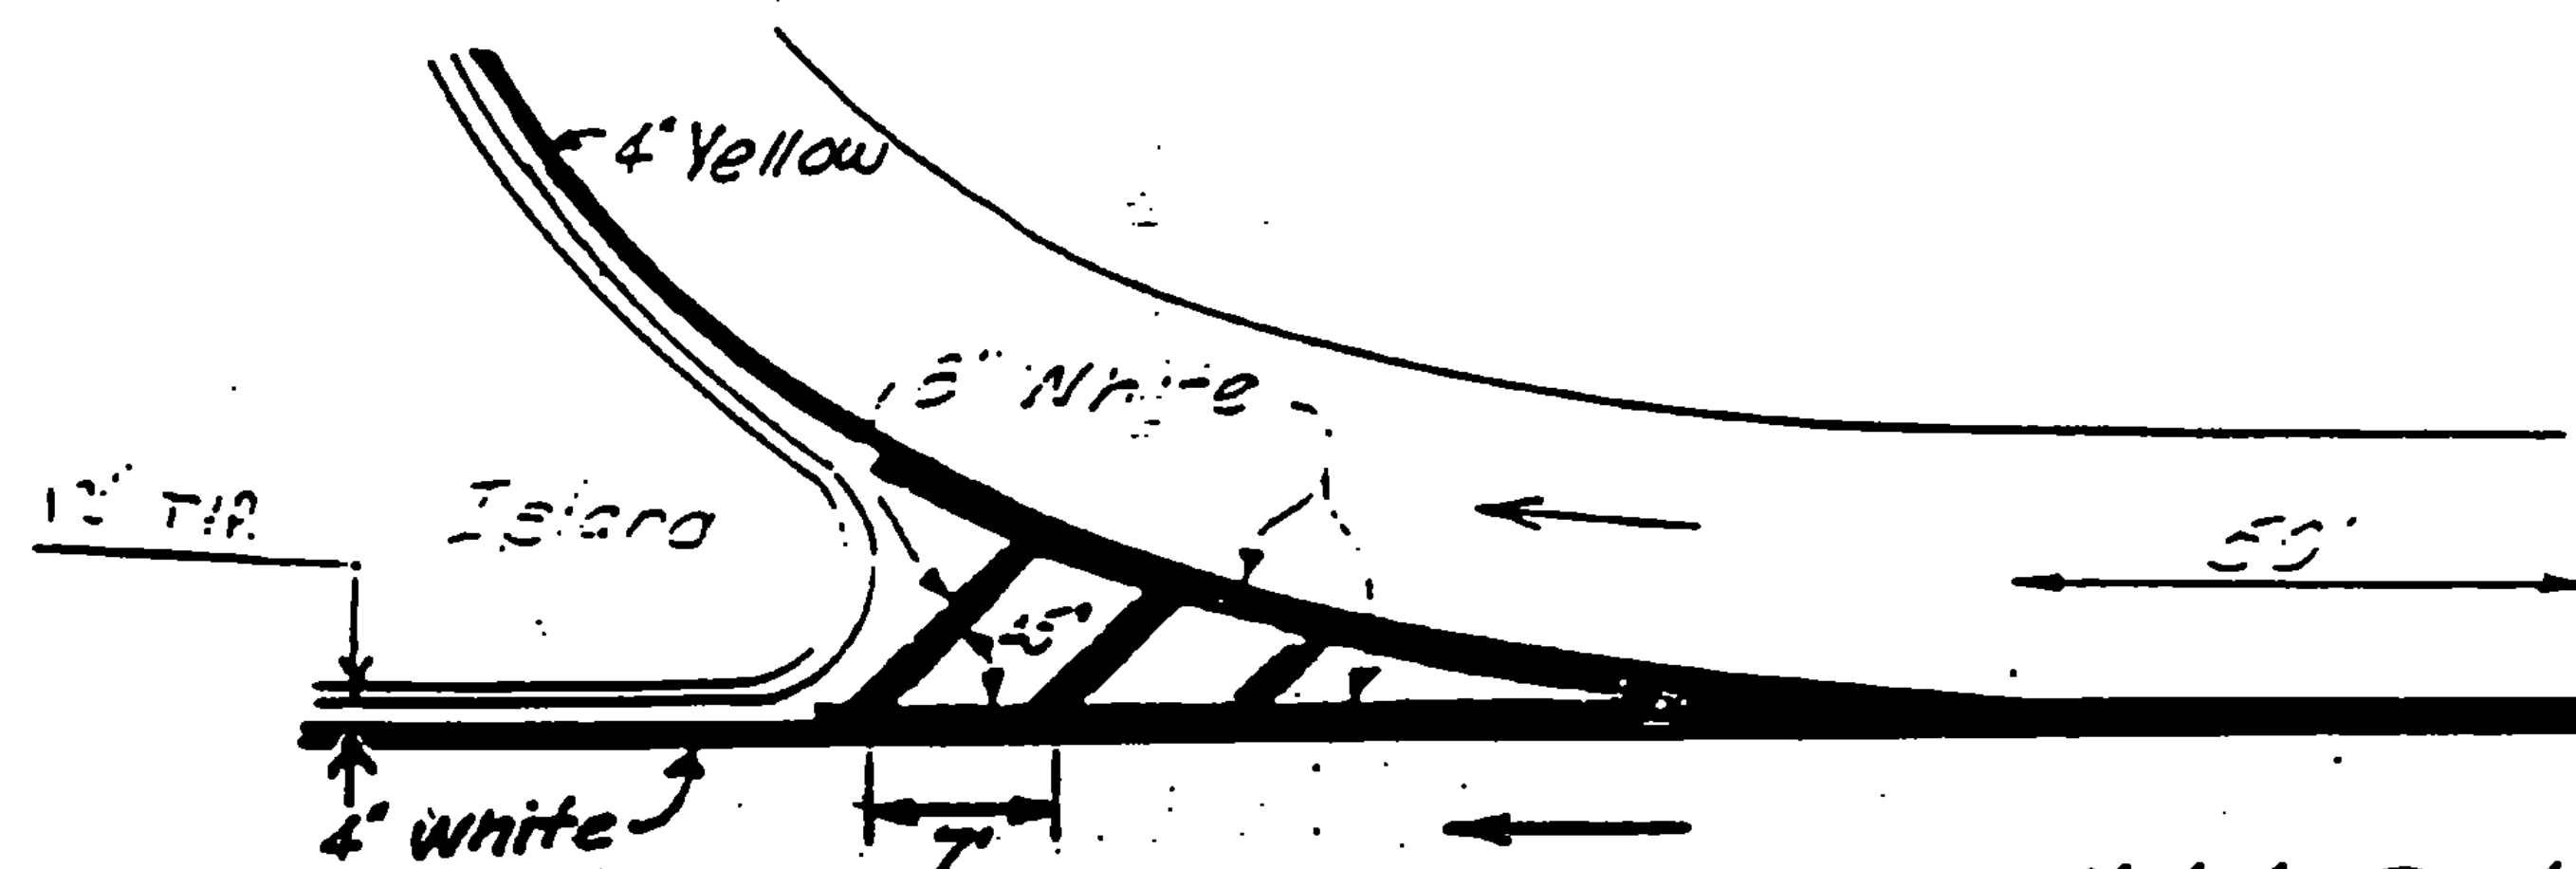

Not to Scale

Turn Lane and Painted Curb Detail

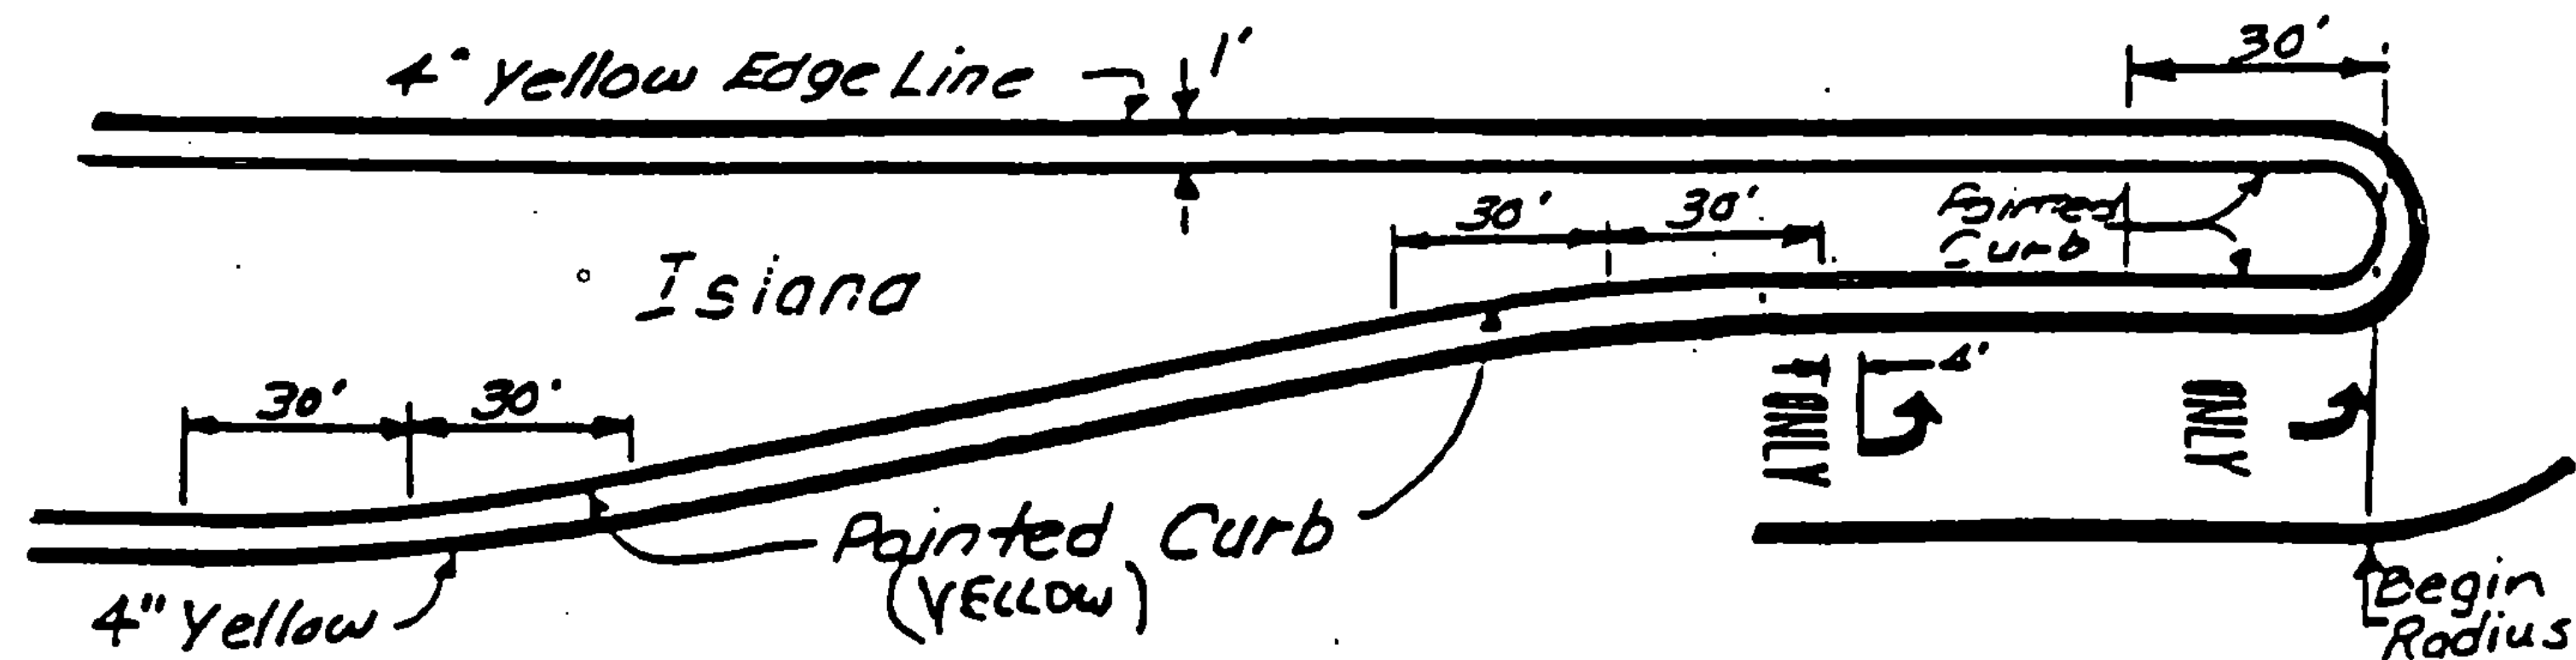

Not to Scale