


TYPICAL SECTIONS & DESIGN DATA

ITEM 406.25 BITUMINOUS CONCRETE PAVEMENT
LEVELING COURSE, TYPE III OR IV (41' WIDE @ 559 TONS/ML)
AS DIRECTED BY THE ENGINEER
1" WEARING COURSE, TYPE III

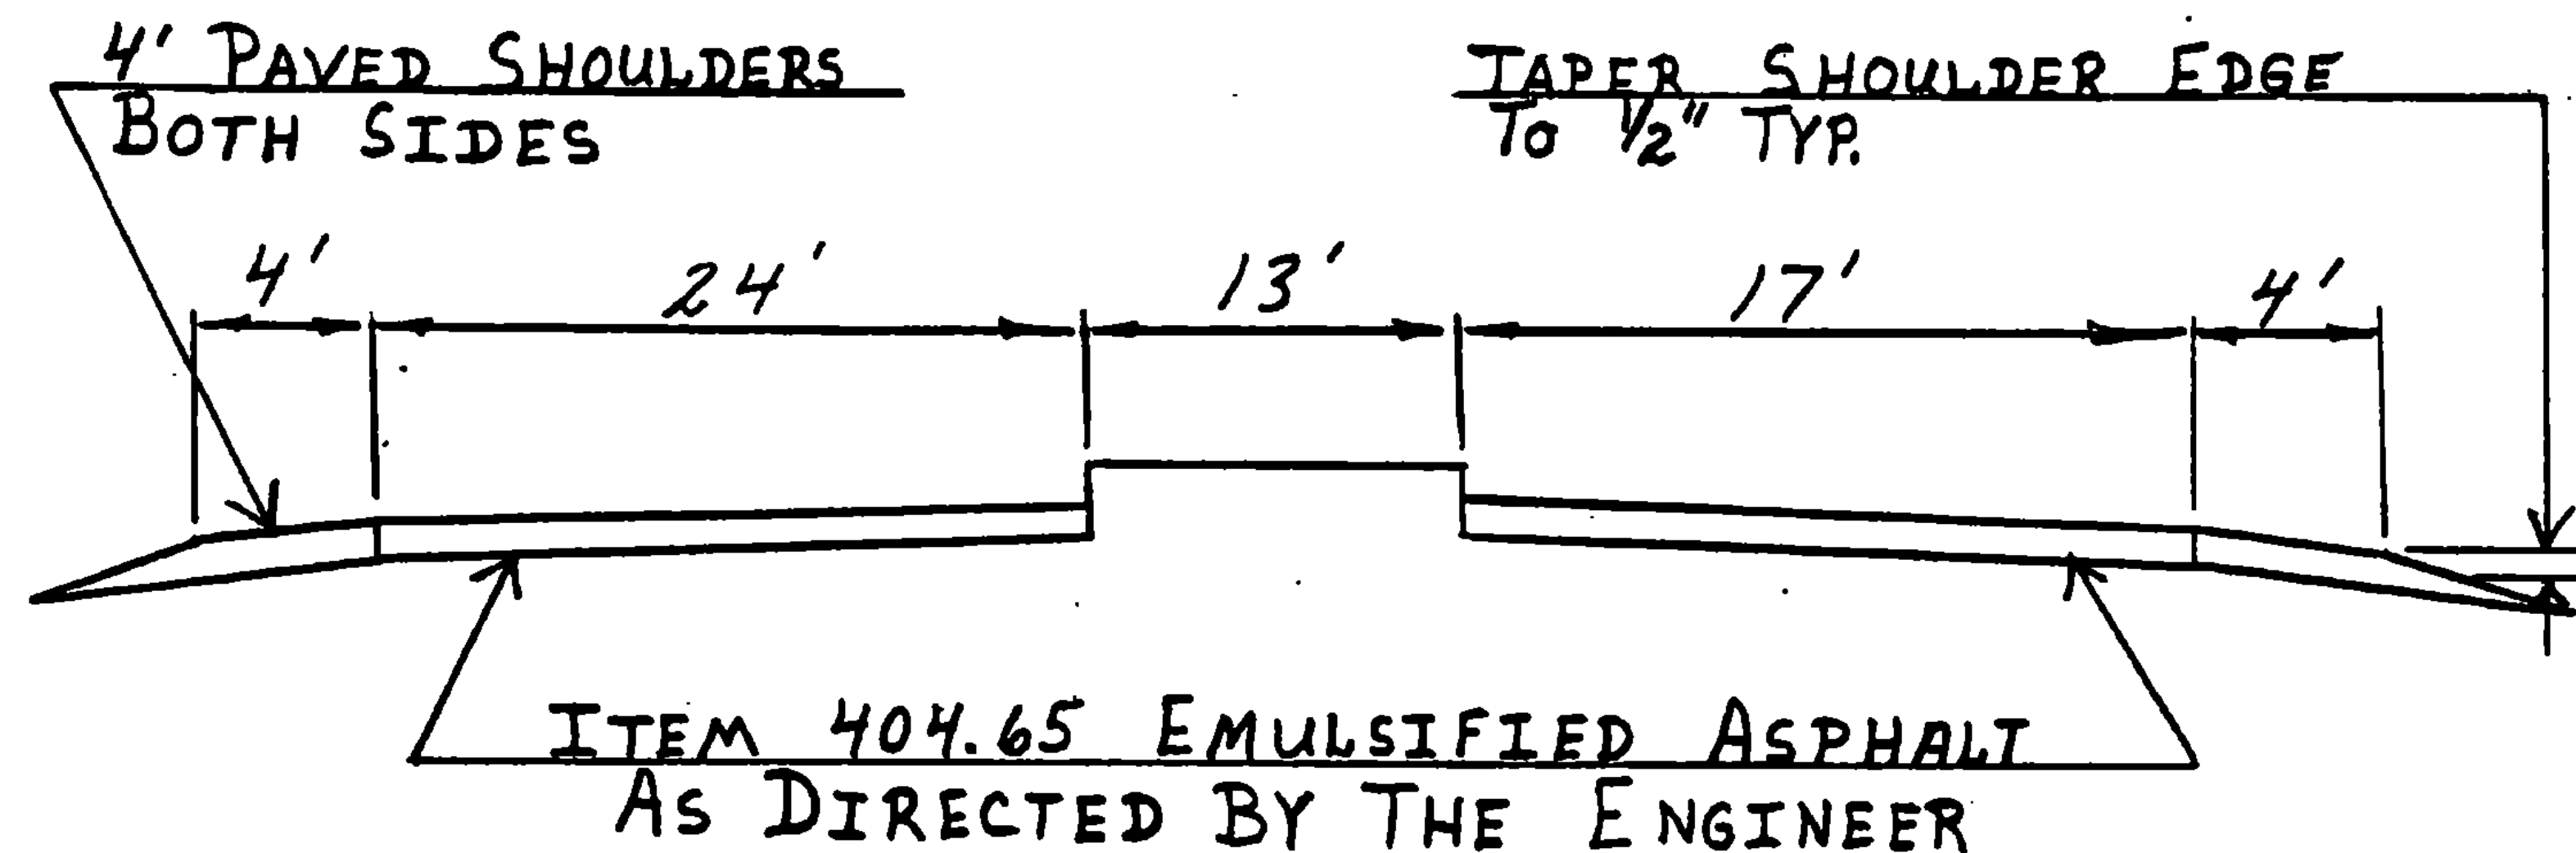

ST. ALBANS MM 0.000~0.085

PROJECT ST. ALBANS

NO. RS 0297(7)

SHEET 24 OF 52 SHEETS