


STOP BAR DETAILS

13.

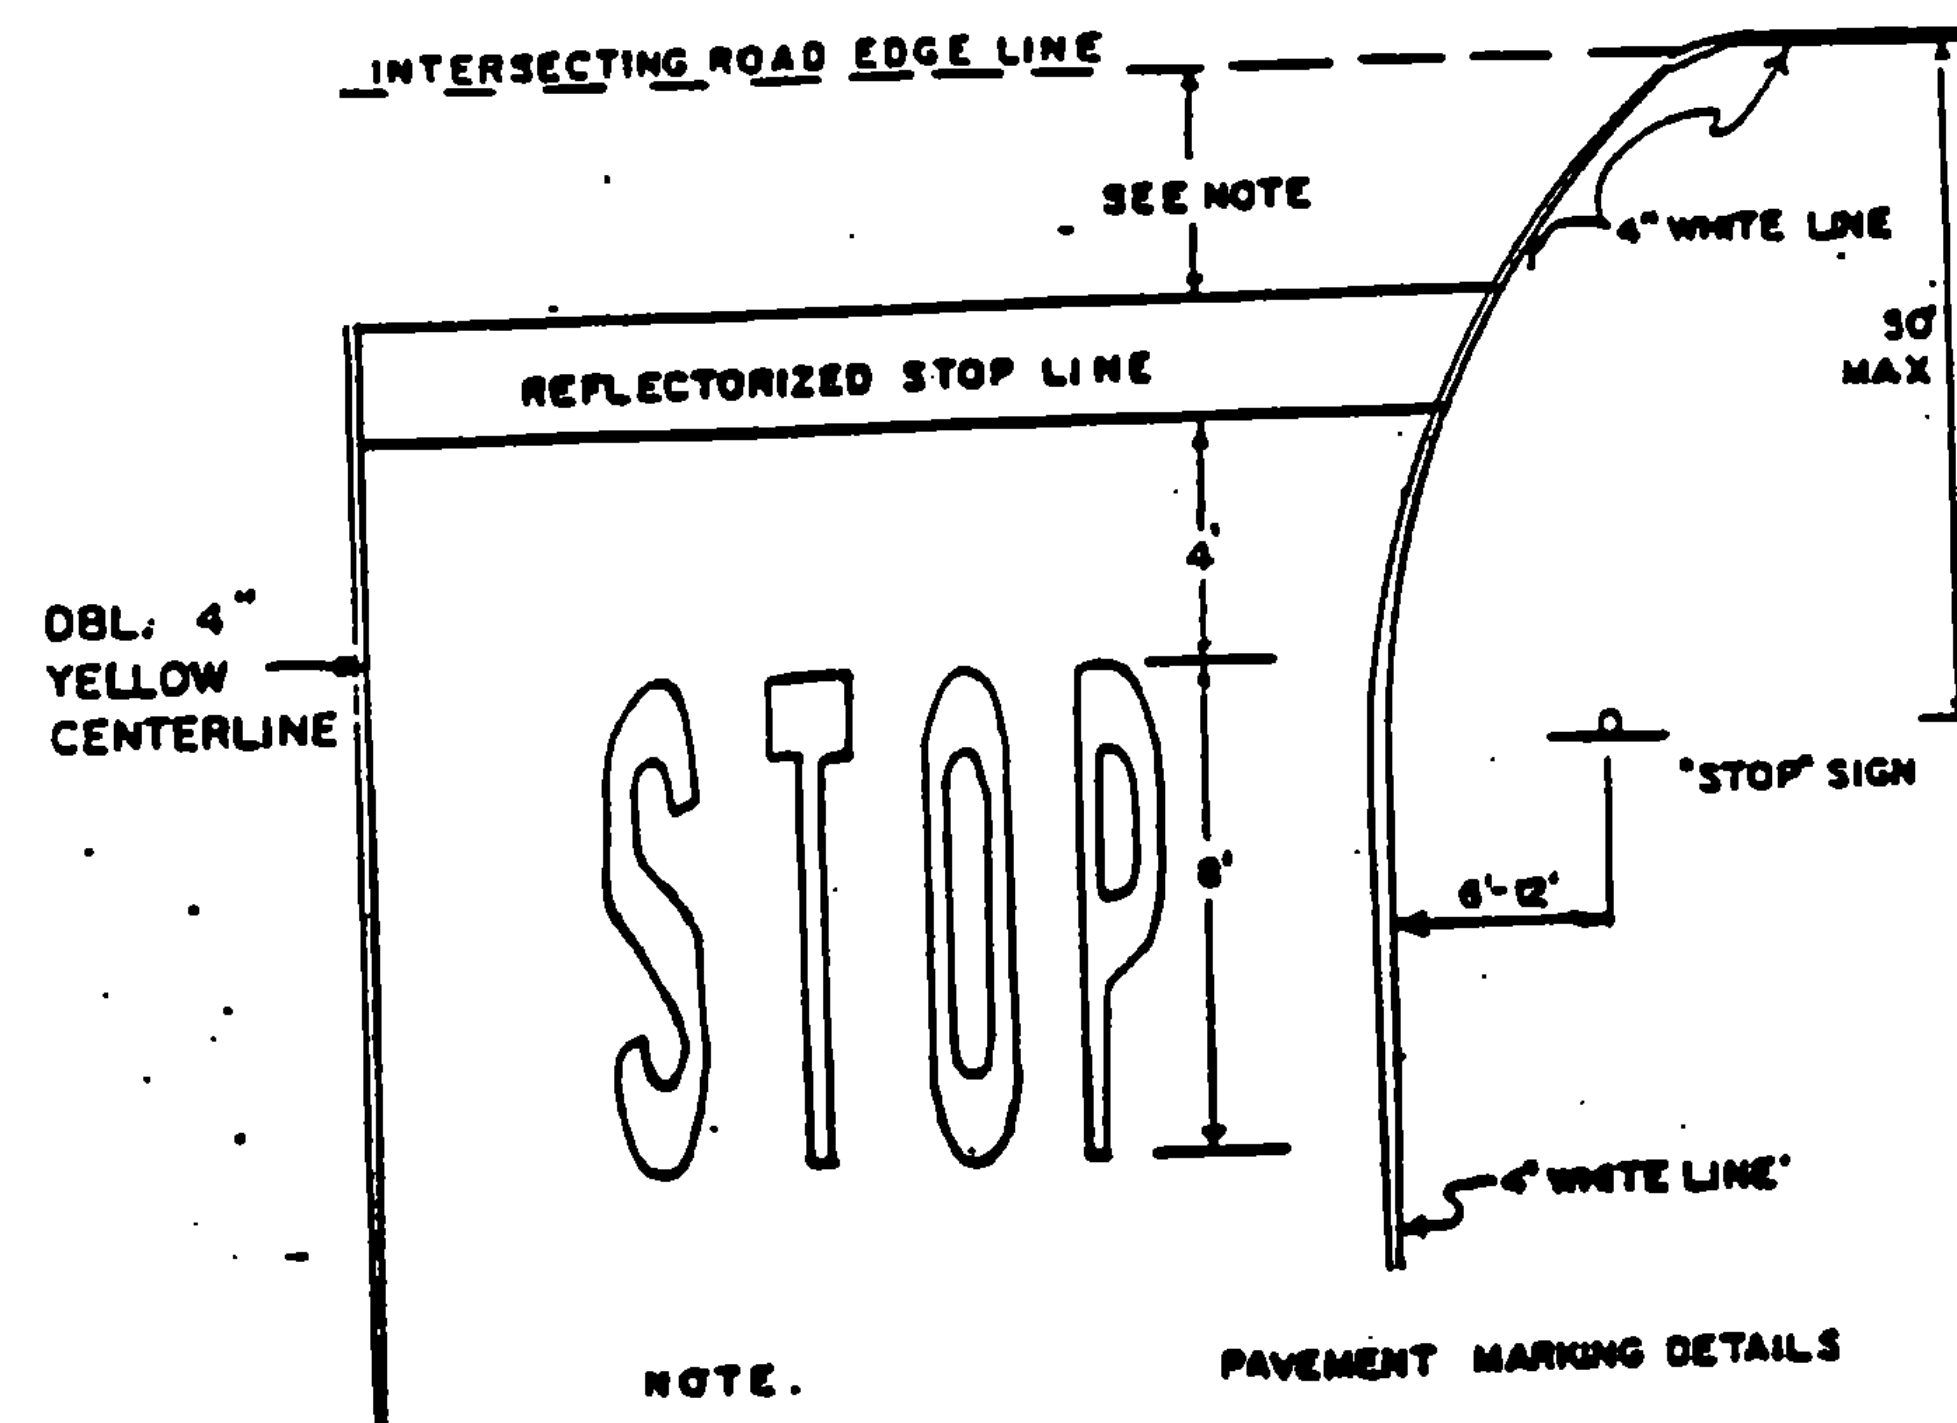

NOTE.
1. THE STOP LINE SHOULD BE PLACED AT THE DESIRED STOPPING POINT, IN NO CASE MORE THAN 30 FEET OR LESS THAN 4' FROM THE NEAREST EDGE OF THE INTERSECTING ROADWAY, OR EDGE OF CROSSWALK.

NOT TO SCALE

AHEAD

NOTE:
SEE STANDARD E-50
FOR LETTERING DETAIL.

16'
16'

STOP AHEAD SIGN

STOP

No. RS 0297(7)

PROJECT ST. ALBANS

SHEET 31 OF 52 SHEETS