



PROJECT DESCRIPTION AND LOCATION

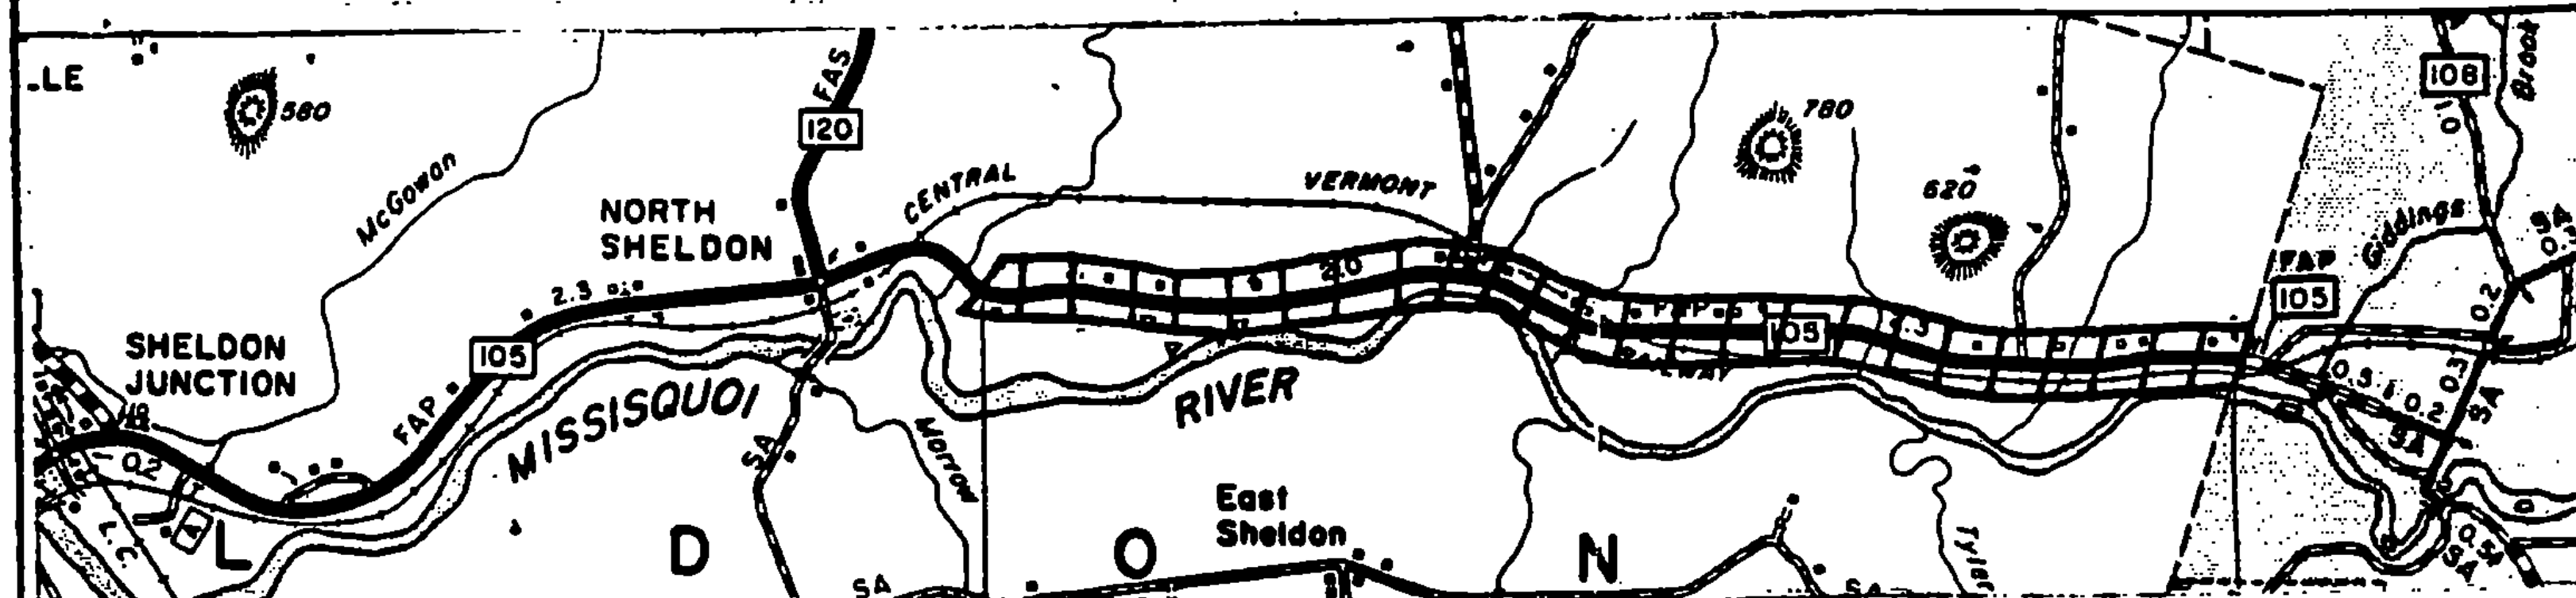

1 INCH REPRESENTS 1 MILE

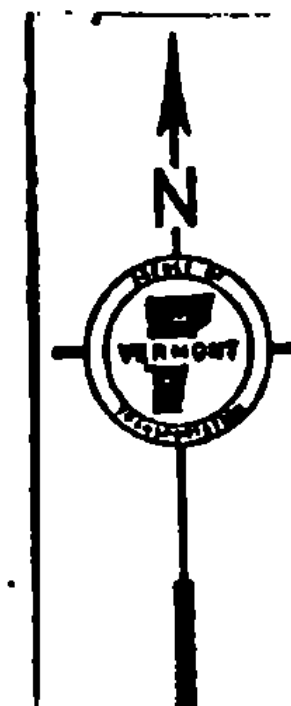

BEGIN PROJECT
MM 7.400

END PROJECT
MM 11.030

T/L END PROJECT SHELDON MM 11.030
ENOSBURG MM 0.000

SEGMENT #2

BEGINNING AT A POINT ON VT. RTE. 105, APPROX. .56 MI. EAST OF THE JCT. OF VT. RTE. 120+105 AT MM 7.400, THENCE EASTERLY A DISTANCE OF 3.630 MI. TO THE SHELDON-ENOSBURG TOWN LINE AT MM 11.030.

LENGTH OF SEGMENT 2
3.630 MILES
19166 FEET

PROJECT ST. ALBANS - SHELDON

NO. HMA 2625

SHEET 33 OF 52 SHEETS