


TYPICAL SECTIONS & DESIGN DATA

ITEM 406.25 BITUMINOUS CONCRETE PAVEMENT
AS DIRECTED BY THE ENGINEER

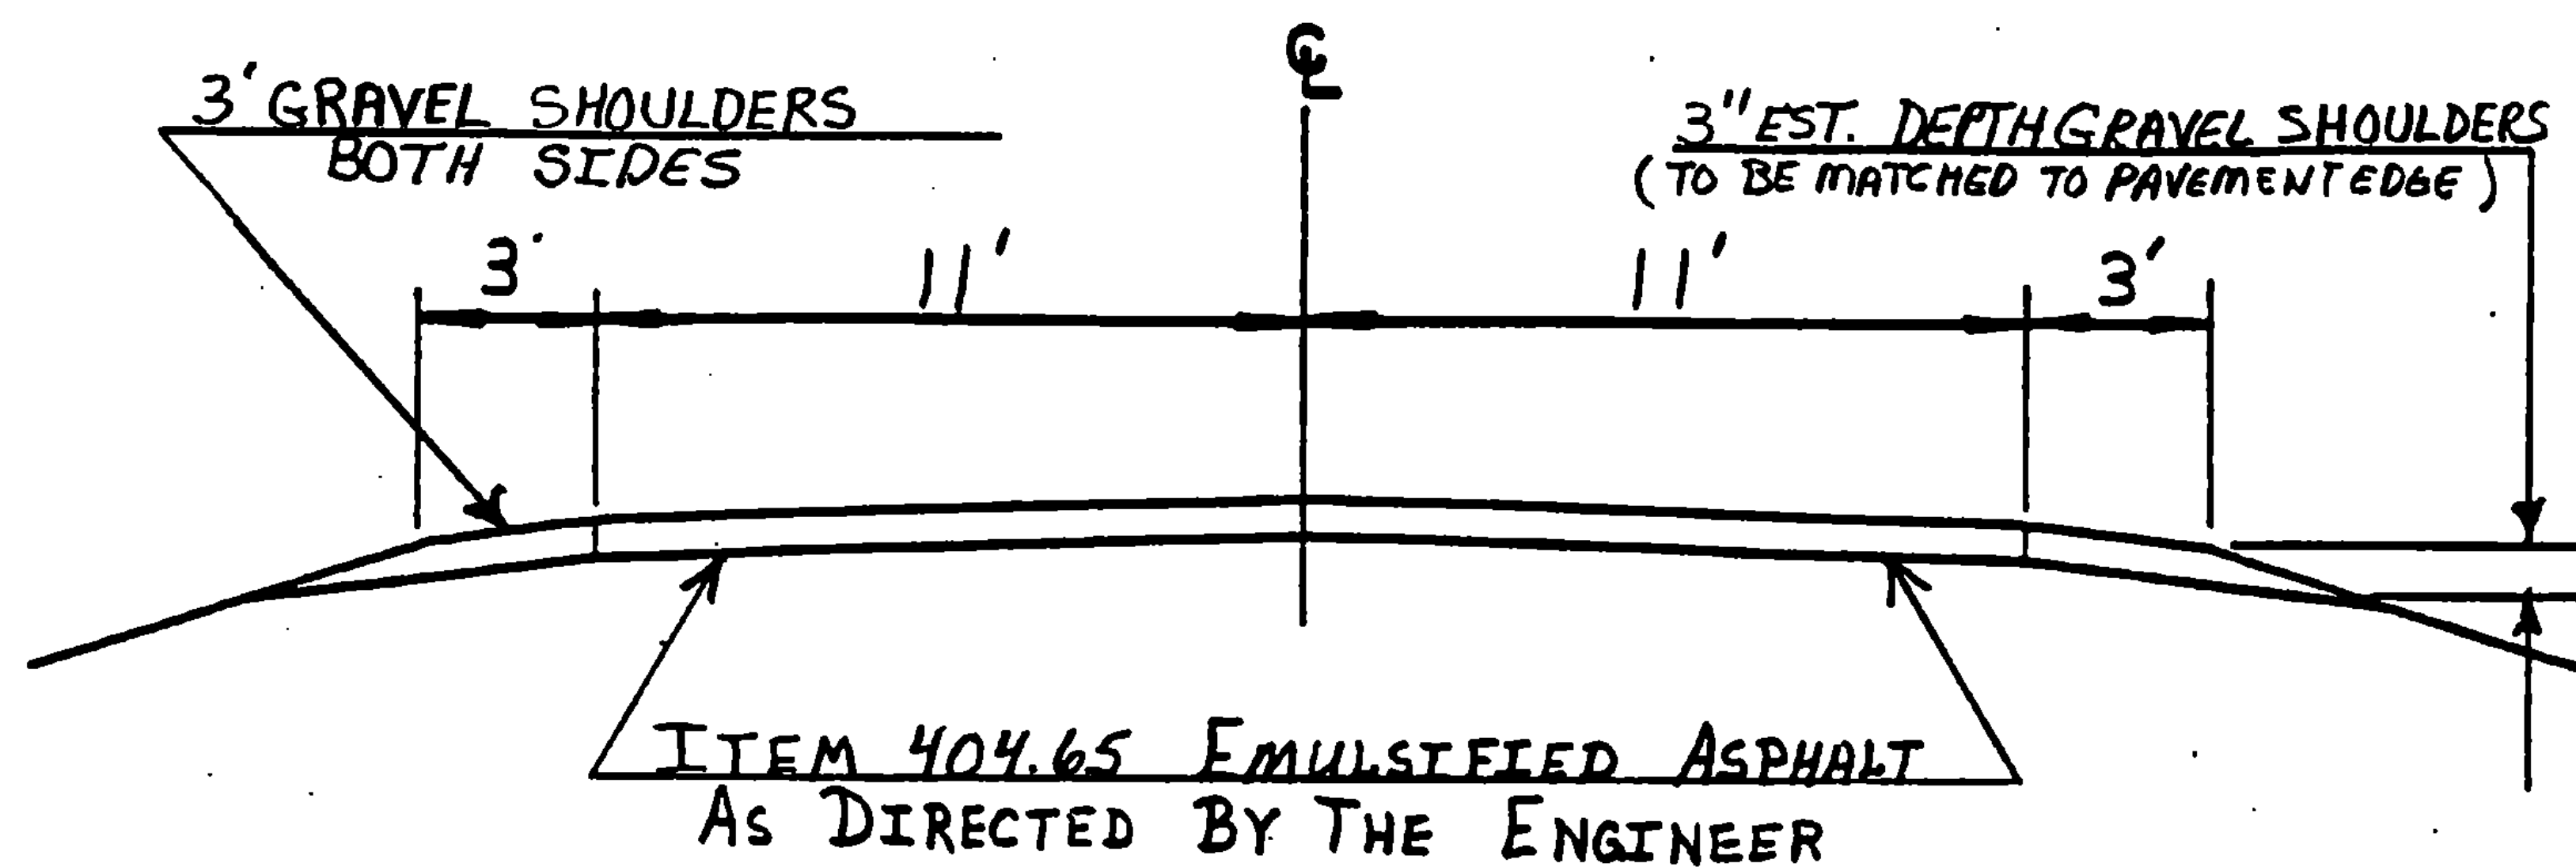

LOCATION	WIDTH	LEVEL T/M	WEARING DEPTH	COURSE TYPE
0.000~1.663 (ST. ALBANS)	22'	250	1.25"	III
1.663 (ST. ALBANS)~1.943 (SWANTON)	22'	300	1.25"	III
1.943 (SWANTON)~0.960 (SHELDON)	22'	250	1.00	IV
7.400~11.030 (SHELDON)	22'	250	1.00	IV

TRAFFIC DATA
1982 ADT 3253
V=50 MPH