


STOP BAR DETAILS

13.

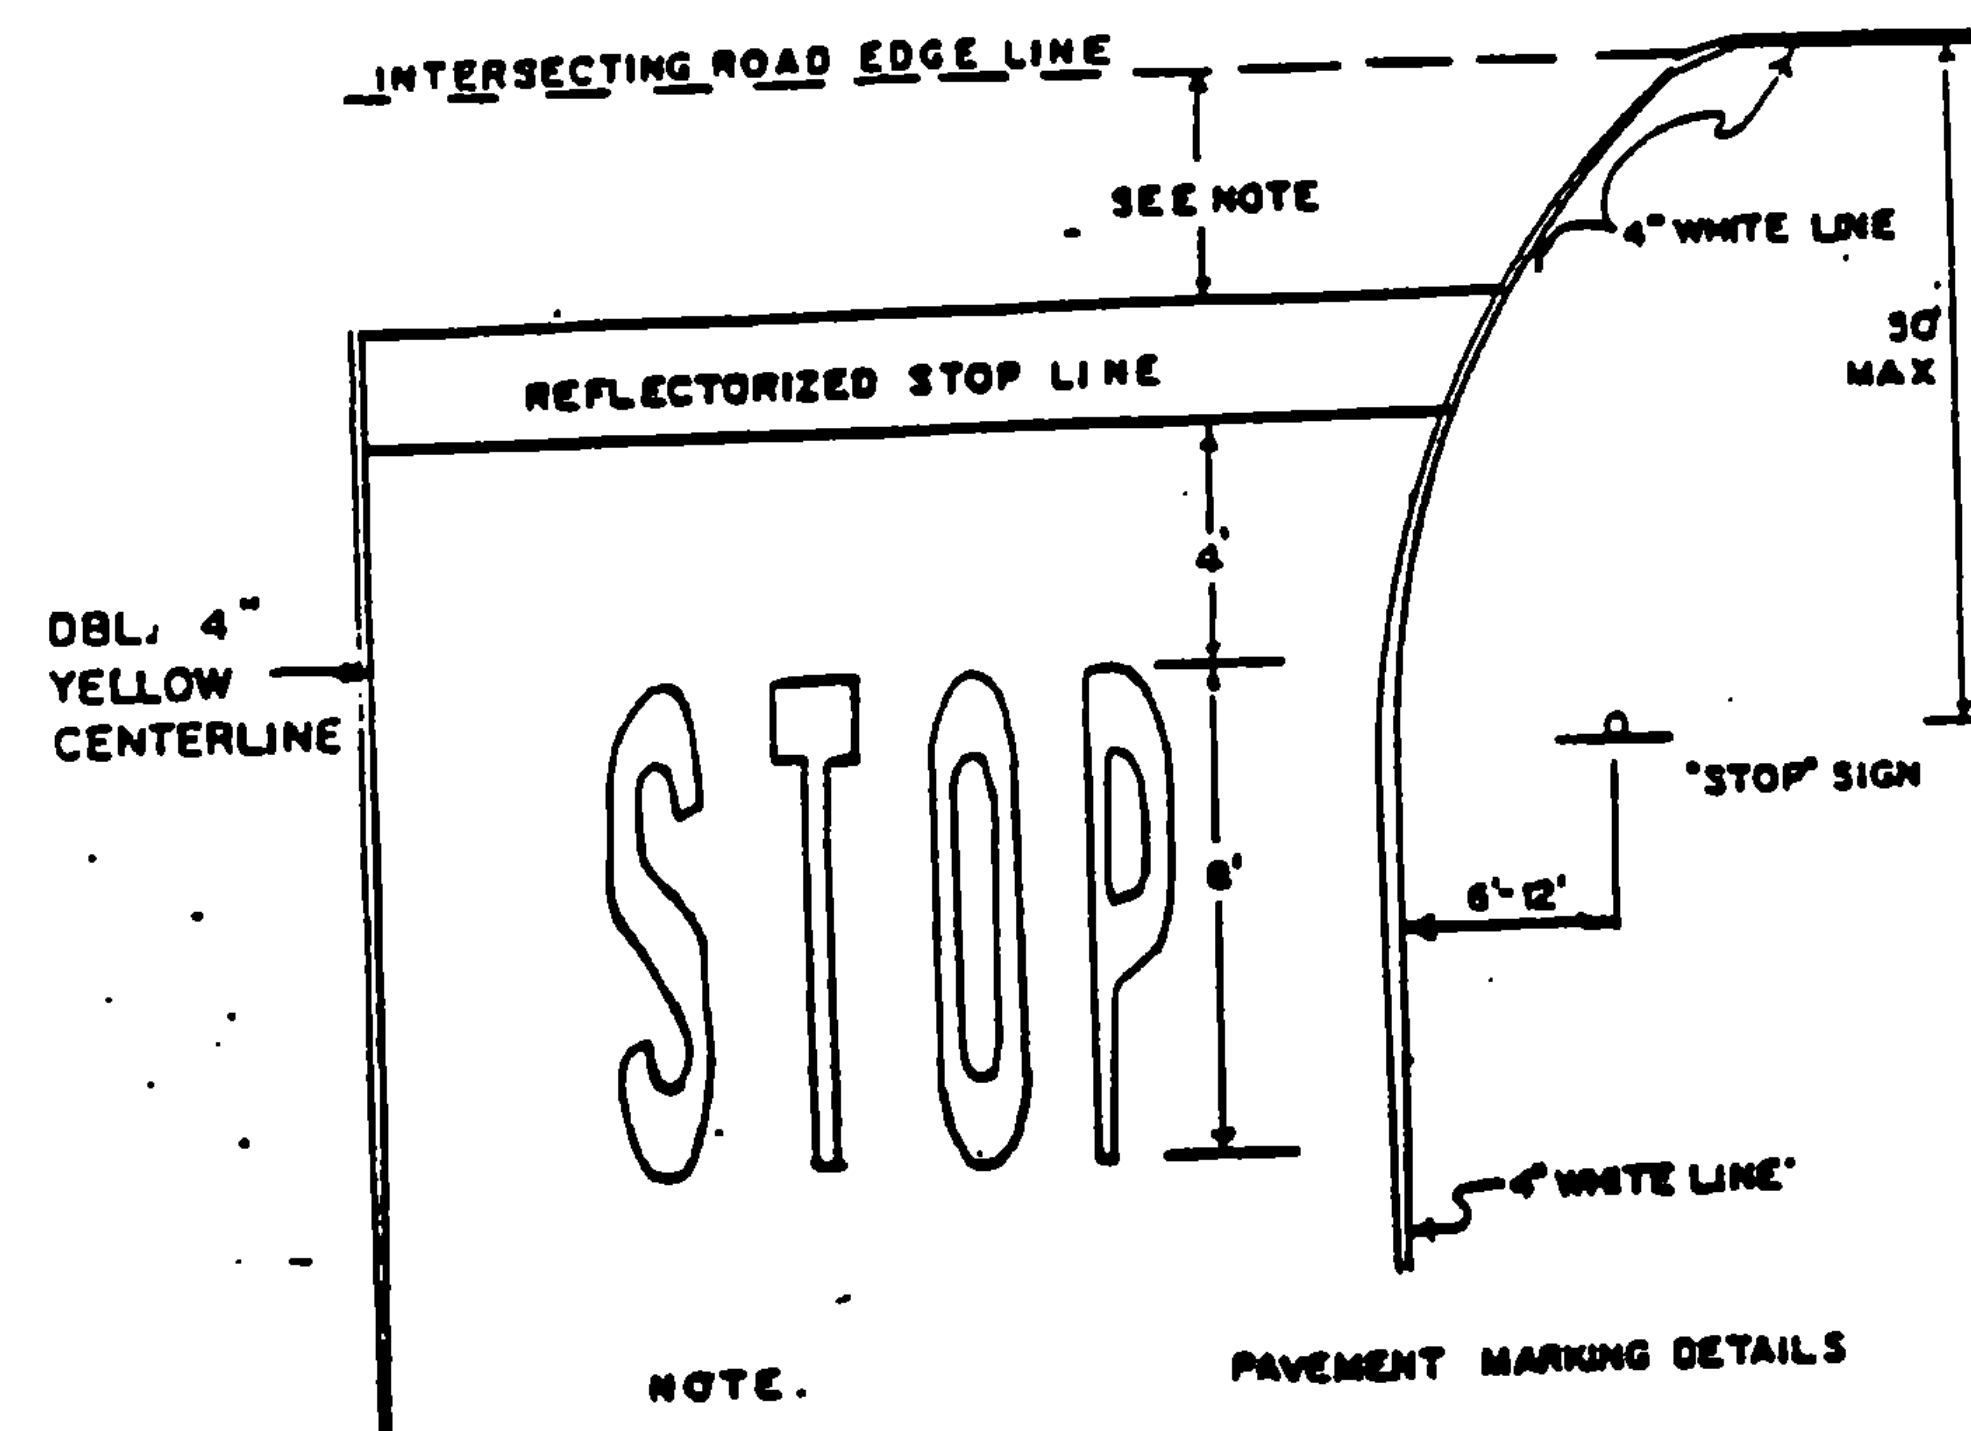

NOTE.
PAVEMENT MARKING DETAILS
1. THE STOP LINE SHOULD BE PLACED AT THE DESIRED STOPPING POINT. IN NO CASE MORE THAN 30 FEET OR LESS THAN 4' FROM THE NEAREST EDGE OF THE INTERSECTING ROADWAY, OR EDGE OF CROSSWALK.

AHEAD

NOTE:
SEE STANDARD E-50
FOR LETTERING DETAIL.

STOP

STOP AHEAD SIGN

ST. ALBANS-SHELDON
HMA 2625
SHEET 39 OF 52