


PROJECT DESCRIPTION AND LOCATION

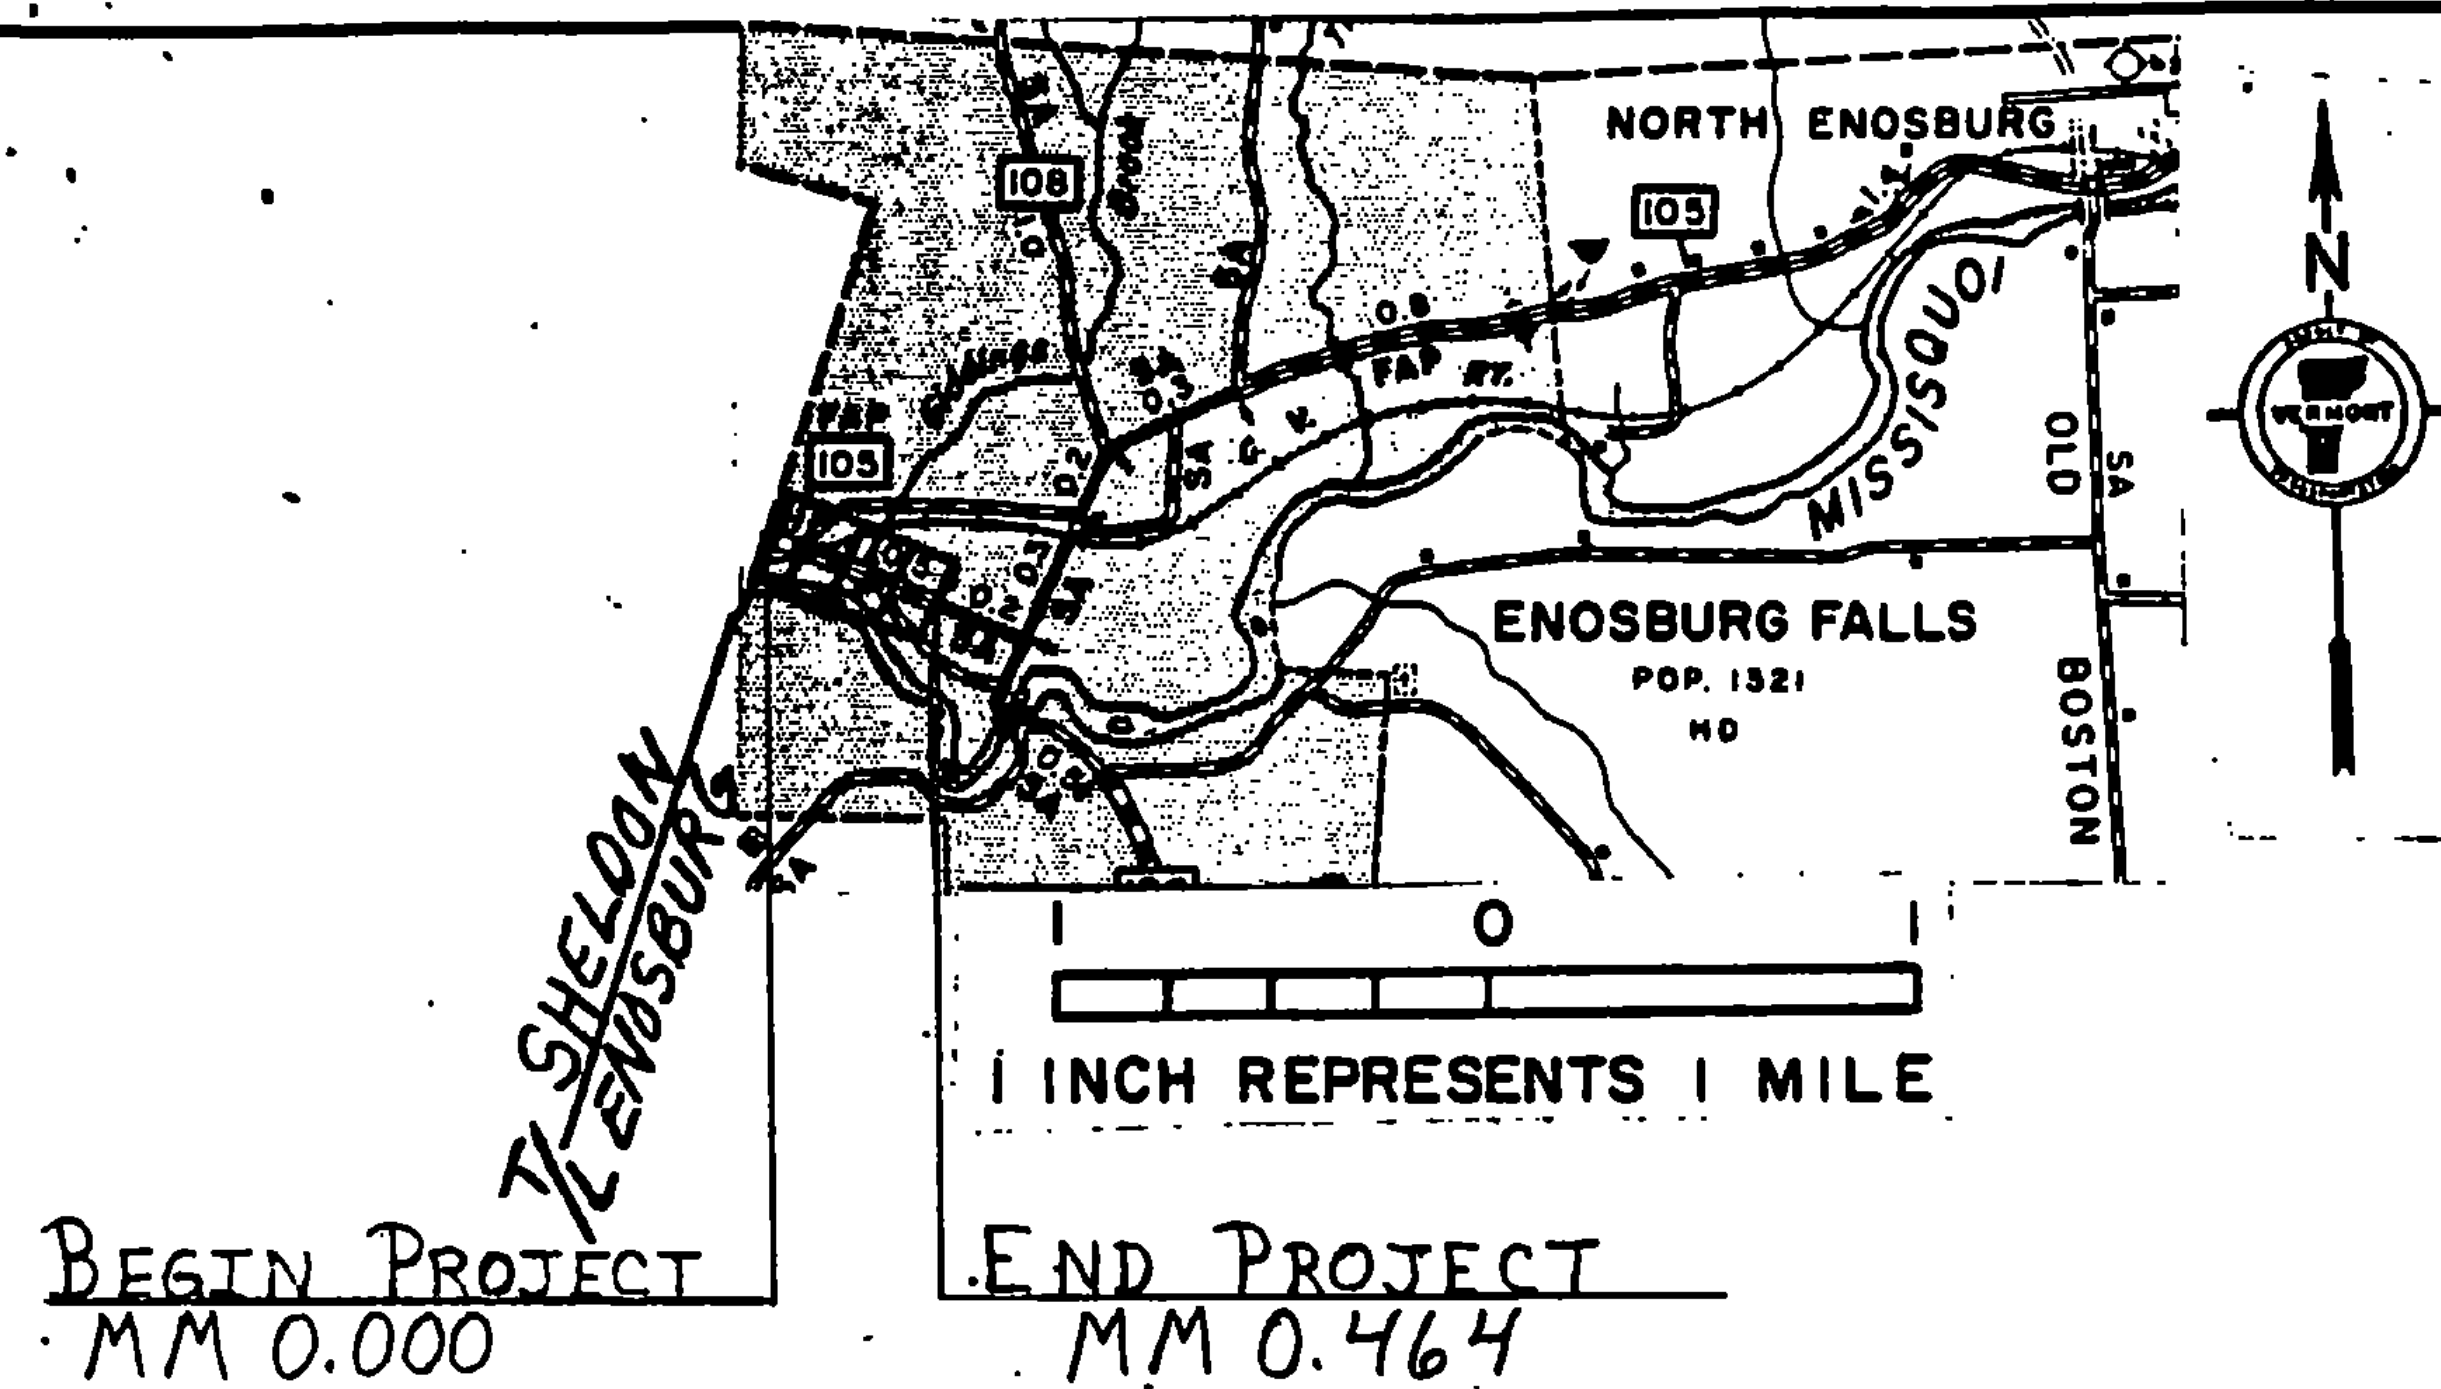

BEGINNING AT A POINT ON VT. RTE. 105 ON THE SHELDON-ENOSBURG TOWN LINE, MM 0.000, AND PROCEEDING EASTERLY A DISTANCE OF 0.4 MILES TO MM 0.464 (THE JCT. OF PEARL ST. AND VT. RTE. 105).

TRAFFIC DATA
1982 AADT 2970
V=35 MPH

LENGTH OF PROJECT
0.464 MILES
2450 FEET

PROJECT ENOSBURG

NO. F 034-1(18)S

SHEET 40 OF 52 SHEETS