

STATE OF VERMONT AGENCY OF TRANSPORTATION





PROPOSED IMPROVEMENT BRIDGE PROJECT TOWN OF ST. JOHNSBURY COUNTY OF CALEDONIA

VT ROUTE 2B (URBAN MINOR ARTERIAL) BRIDGE NO. 6

PROJECT LOCATION: LOCATED IN THE TOWN OF ST. JOHNSBURY ON VT ROUTE 2B, APPROXIMATELY 0.353 MILES WESTERLY OF THE INTERSECTION OF US ROUTE 2 AND VT ROUTE 2B AND EXTENDING APPROXIMATELY 175 FEET.

PROJECT DESCRIPTION: WORK TO BE PERFORMED UNDER THIS PROJECT INCLUDES REPLACEMENT OF THE EXISTING 3 SPAN STEEL GIRDER BRIDGE WITH A NEW BURIED GALVANIZED STEEL STRUCTURAL PLATE ARCH WITH MSE WINGWALLS INCLUDING RELATED ROADWAY AND RAIL TRAIL WORK.


LENGTH OF STRUCTURE: 47.95 FEET
LENGTH OF ROADWAY: 127.05 FEET
LENGTH OF PROJECT: 175.00 FEET

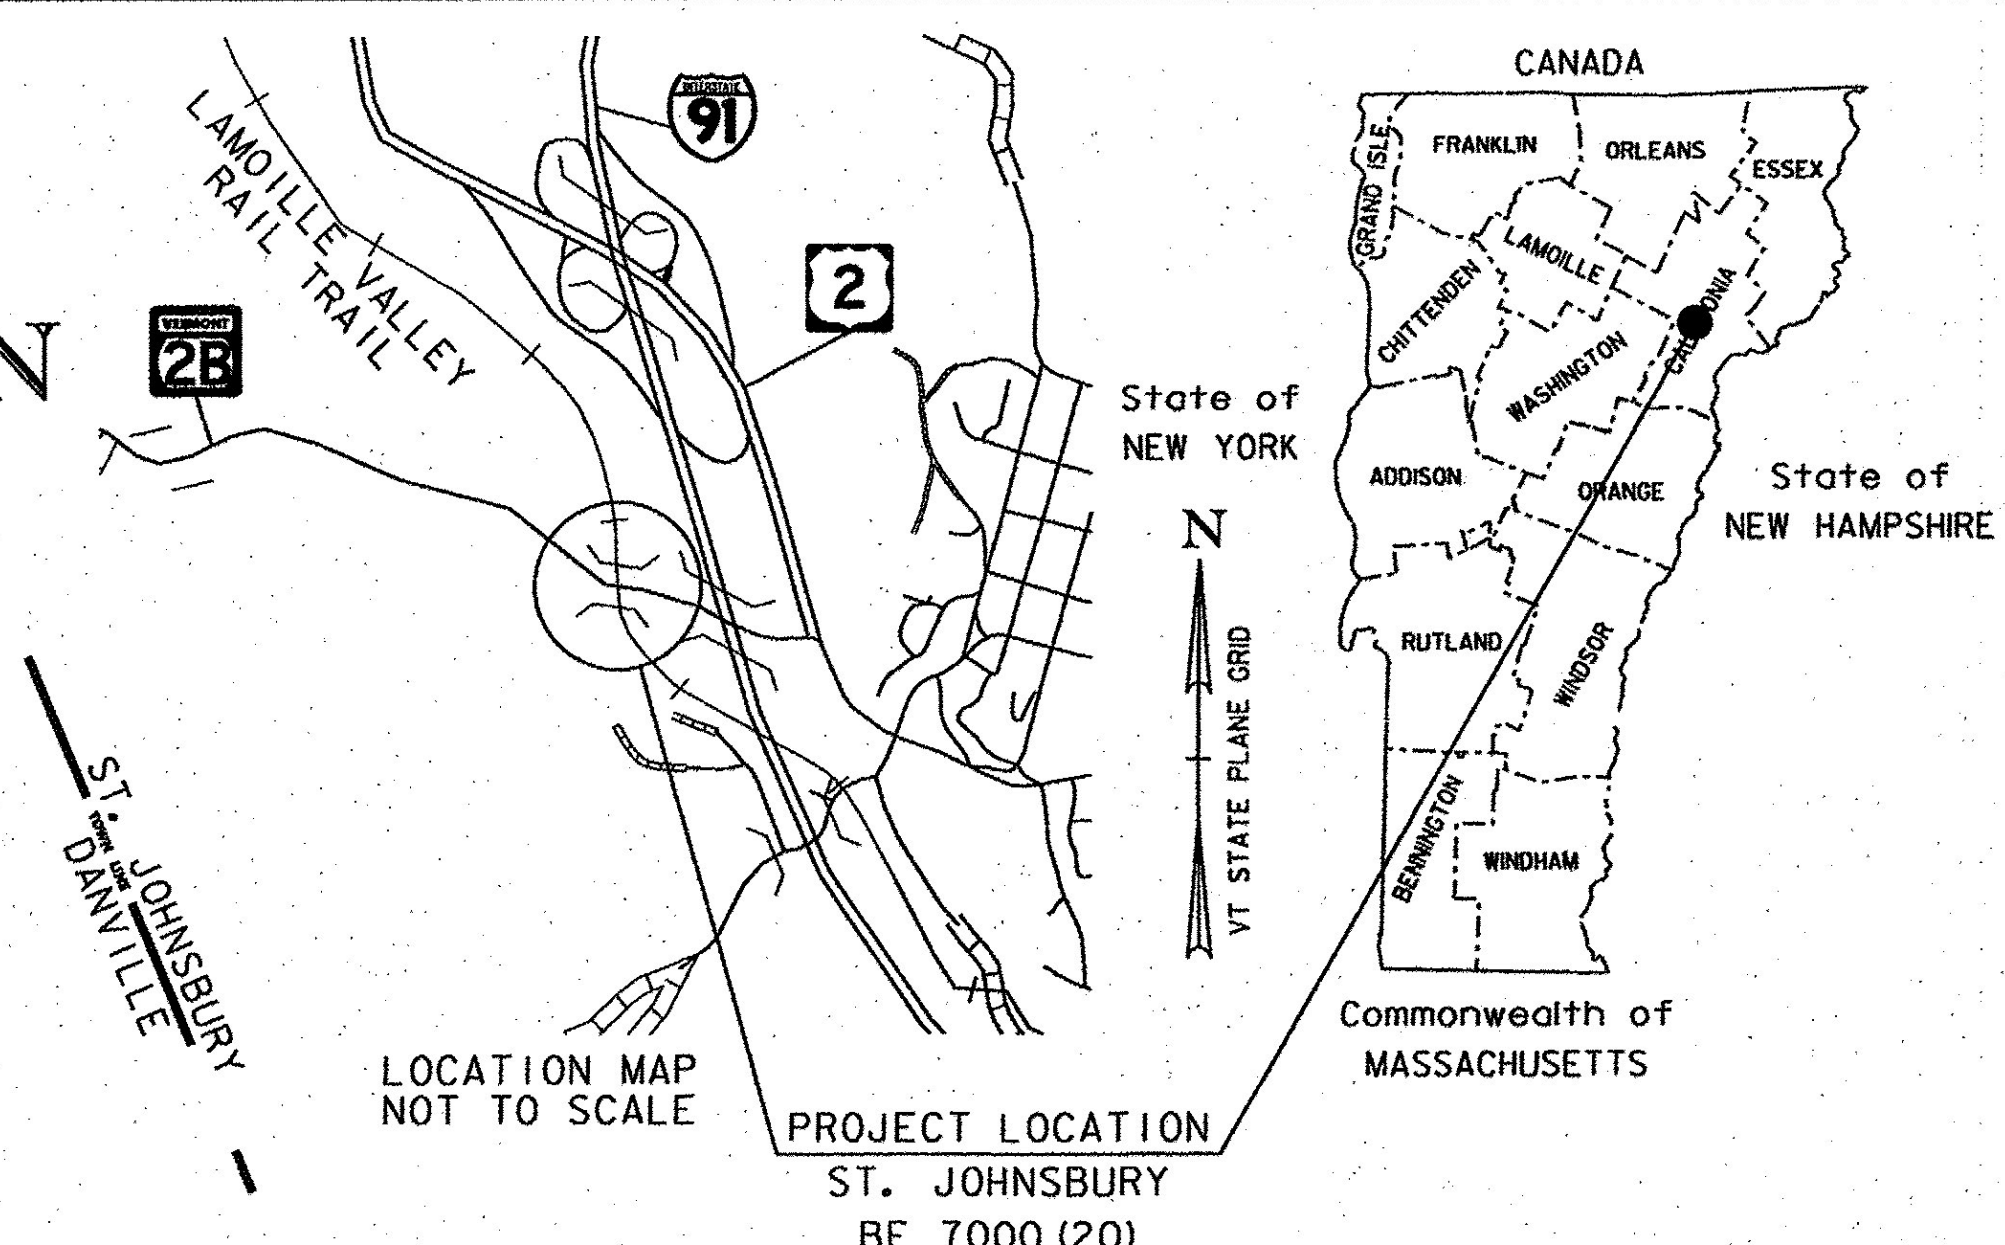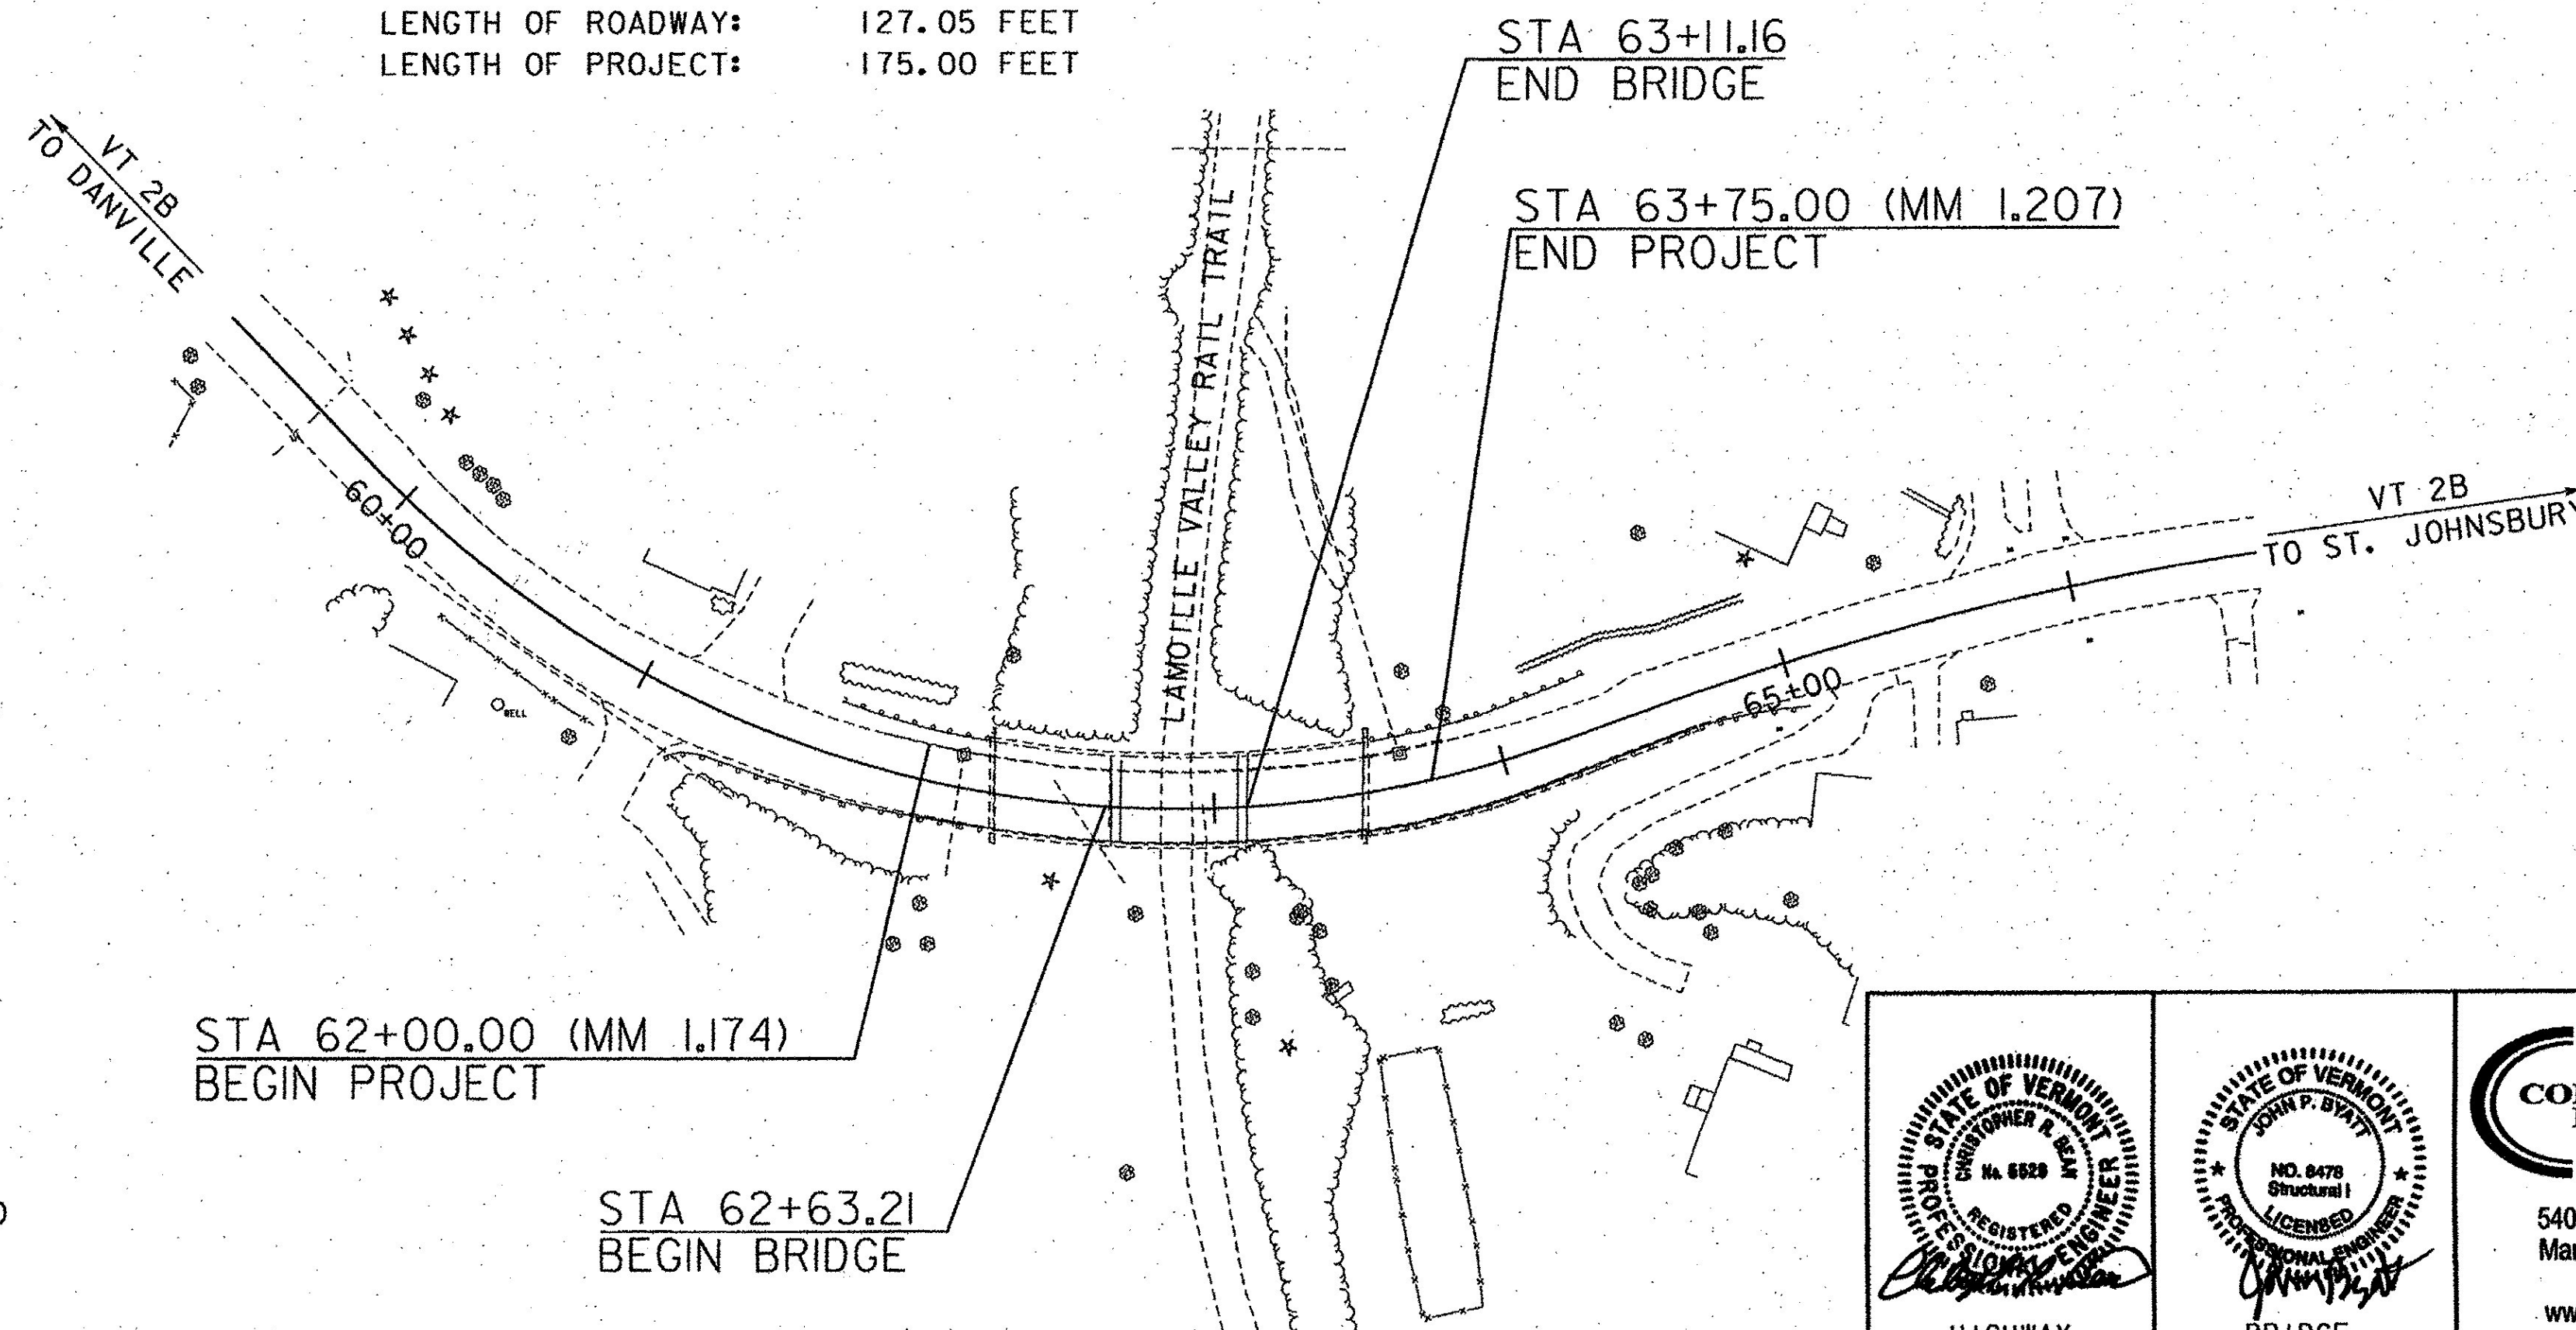

RECORD PLANS	
CONTRACTOR:	J.P. SICARD, INC. - BARTON, VT
RESIDENT ENGINEER:	JAY STRONG
CONSTRUCTION BEGAN:	MAY 10, 2017
CONSTRUCTION COMPLETE:	SEPTEMBER 22, 2017
RECORD PLANS BY:	JAY STRONG & AARON WEAVER
I HEREBY CERTIFY THAT ALL THE CONSTRUCTION REQUIRED BY THIS SET OF DRAWINGS HAS BEEN ACCOMPLISHED AS INDICATED HEREIN.	
BY:	<i>Jay Strong</i> RESIDENT ENGINEER
DATE:	7/27/2016
NOTE: Any further information concerning final quantities, amounts or other details relative to this project may be found by contacting Vtrans Records Management.	

CONSTRUCTION IS TO BE CARRIED ON IN ACCORDANCE WITH THESE PLANS AND THE STANDARD SPECIFICATIONS FOR CONSTRUCTION DATED 2011, AS APPROVED BY THE FEDERAL HIGHWAY ADMINISTRATION ON JULY 20, 2011 FOR USE ON THIS PROJECT, INCLUDING ALL SUBSEQUENT REVISIONS AND SUCH REVISED SPECIFICATIONS AND SPECIAL PROVISIONS AS ARE INCORPORATED IN THESE PLANS.

QUALITY ASSURANCE PROGRAM : LEVEL 2
SURVEYED BY : VTRANS
SURVEYED DATE : 03/26/2013 & 7/22/2014
DATUM
VERTICAL NAVD88
HORIZONTAL NAD 83 (96)

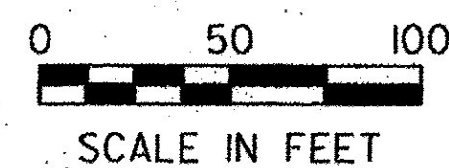

<p>STATE OF VERMONT PROFESSIONAL ENGINEER No. 6628 ROADWAY & BRIDGE</p>	<p>STATE OF VERMONT PROFESSIONAL ENGINEER No. 8478 Structural LICENSED</p>	<p>CONSULTING ENGINEERS</p> <p>540 Commercial Street Manchester, NH 03101 (603) 868-8223 www.cldengineers.com</p>	DIRECTOR OF PROJECT DELIVERY
			APPROVED: <i>Wendy Pelletier</i> DATE 7/27/2016
			PROJECT MANAGER : WENDY PELLETIER, P.E.
			PROJECT NAME : ST. JOHNSBURY
			PROJECT NUMBER : BF 7000 (20)
			SHEET 1 OF 70 SHEETS