

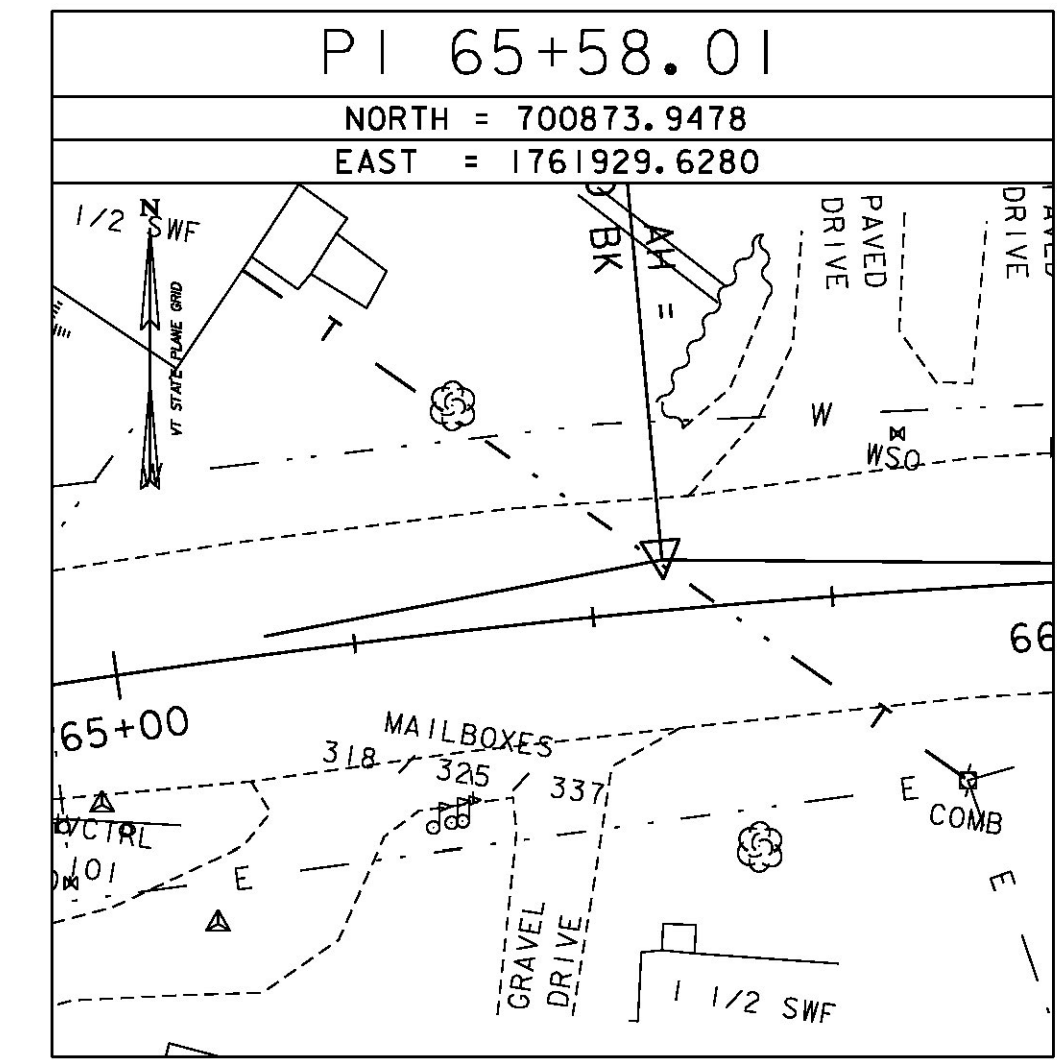
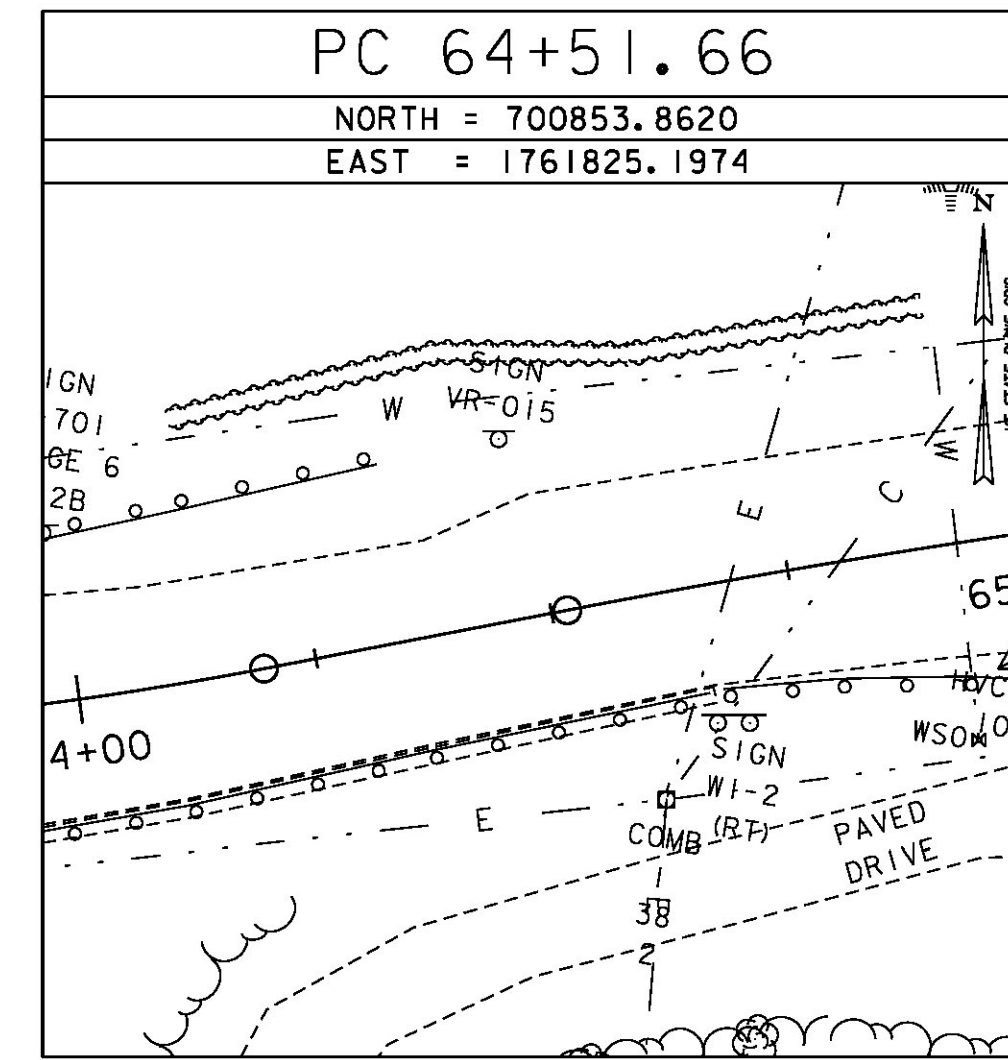
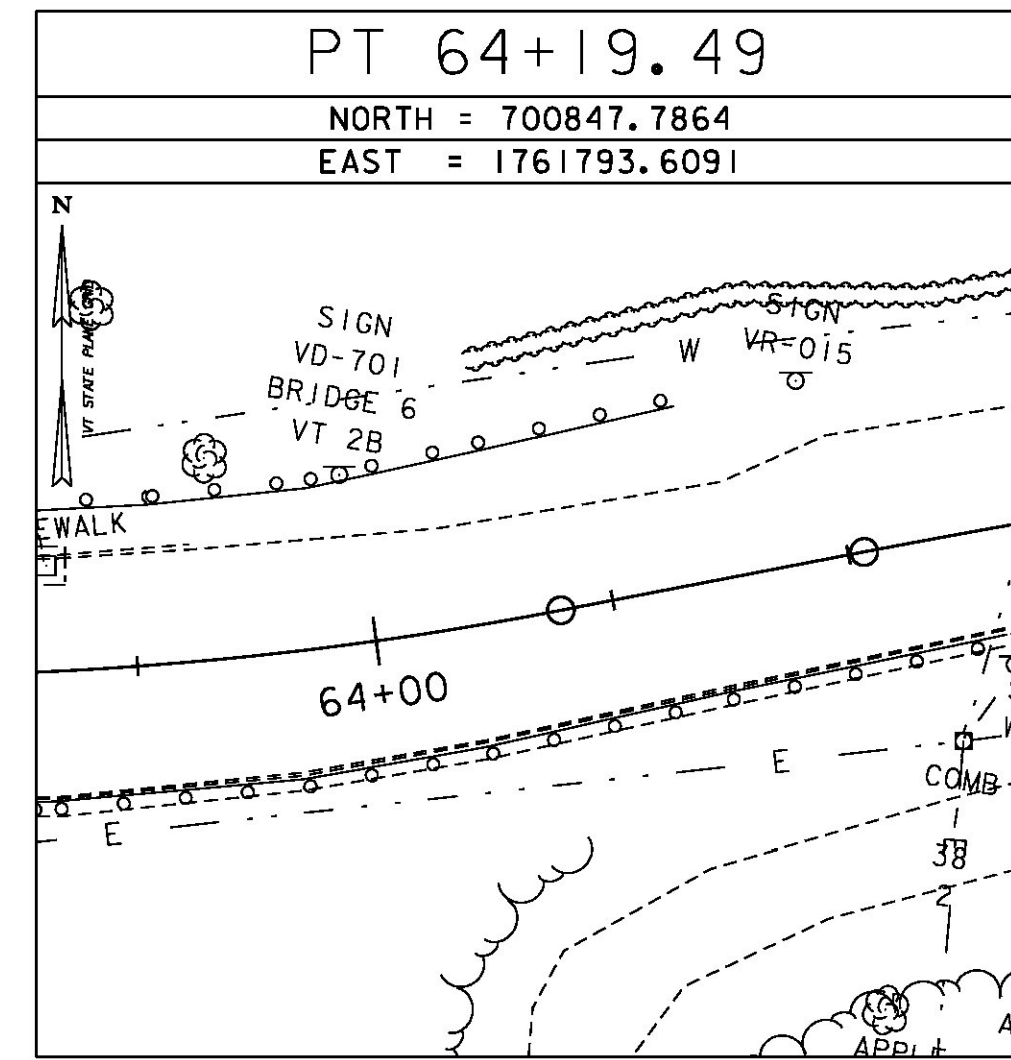
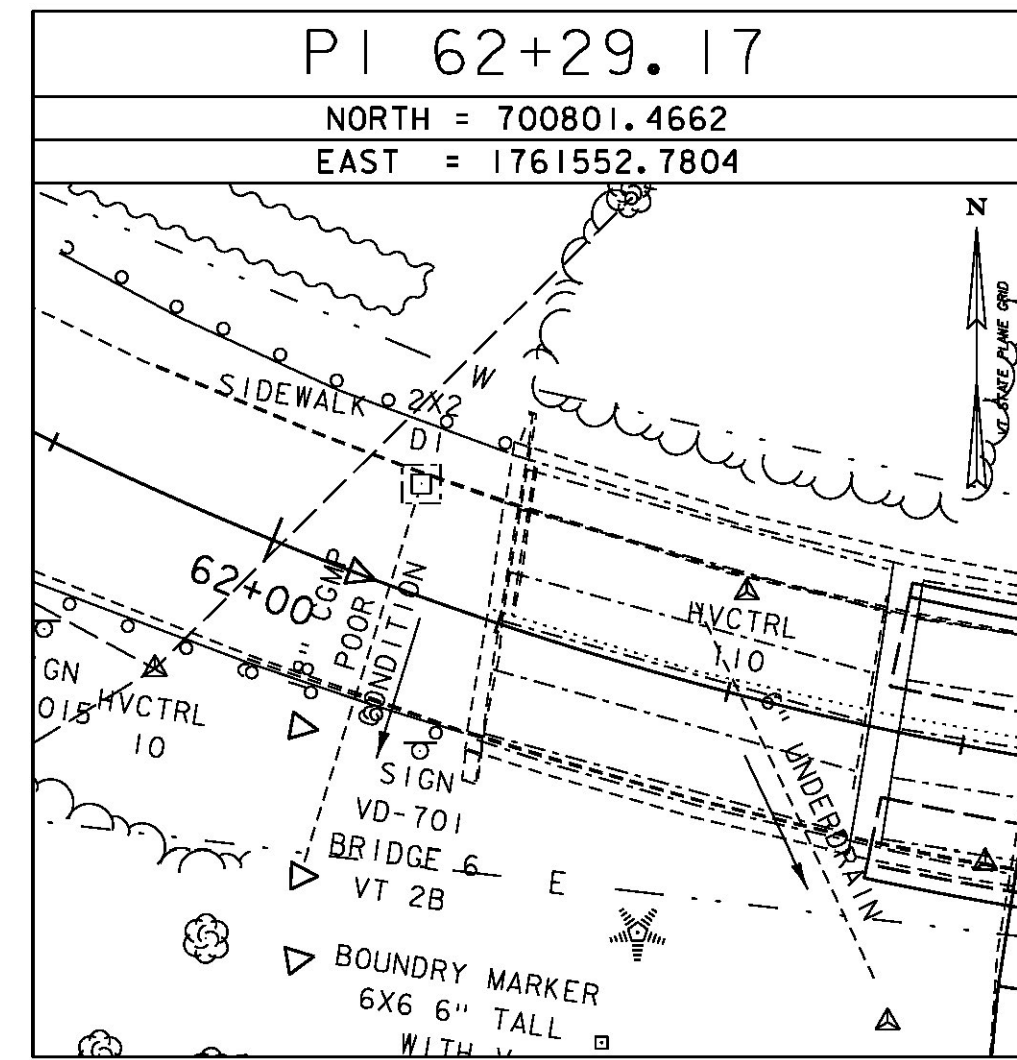 
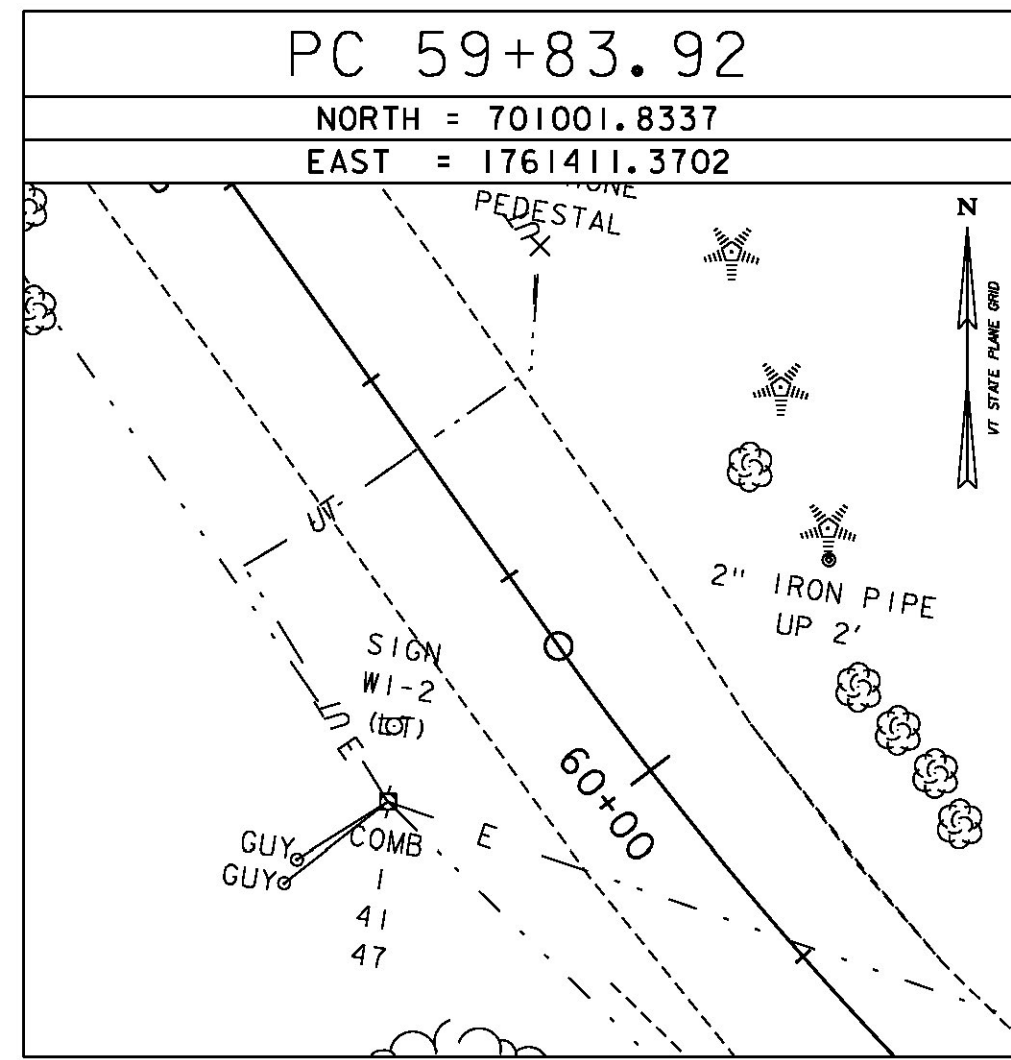 
 








ALIGNMENT TIES



ALIGNMENT TIES

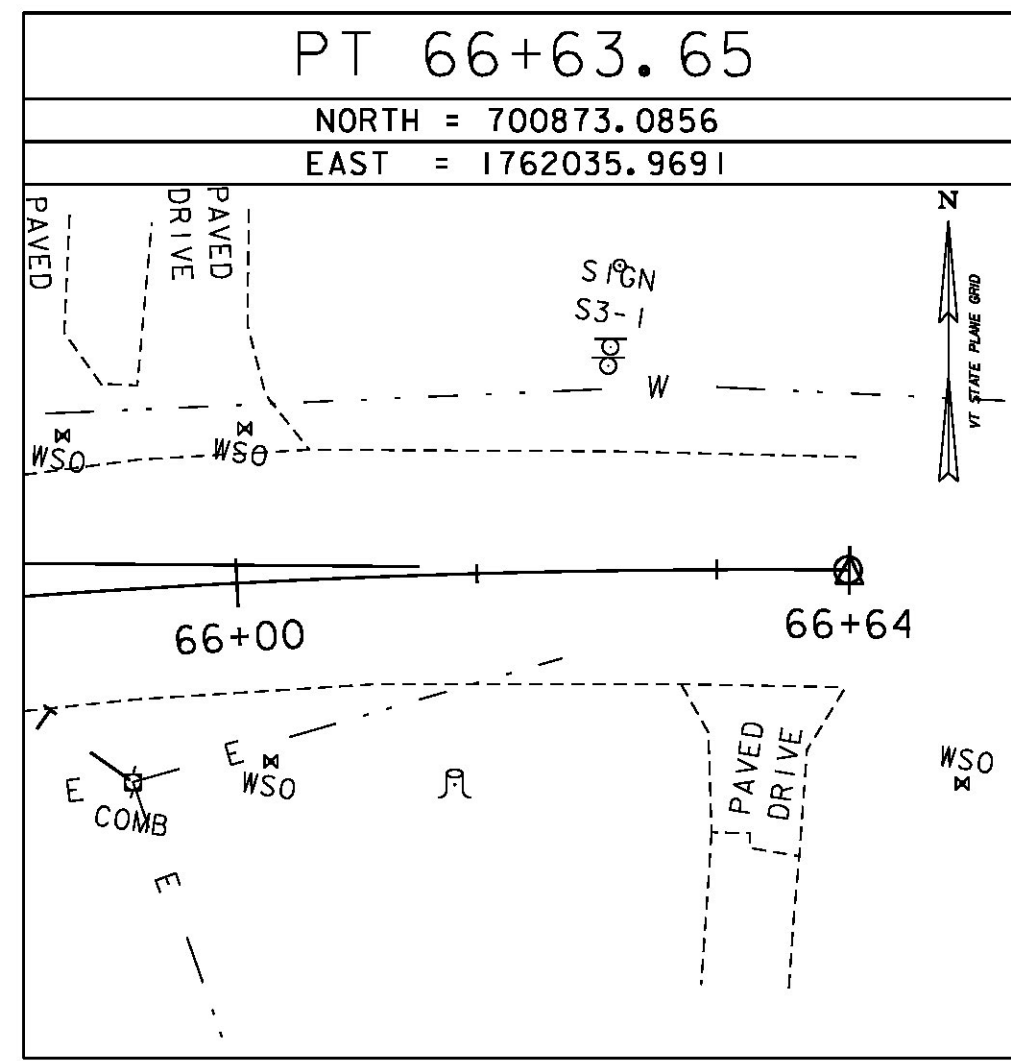

  ALIGNMENT TIES

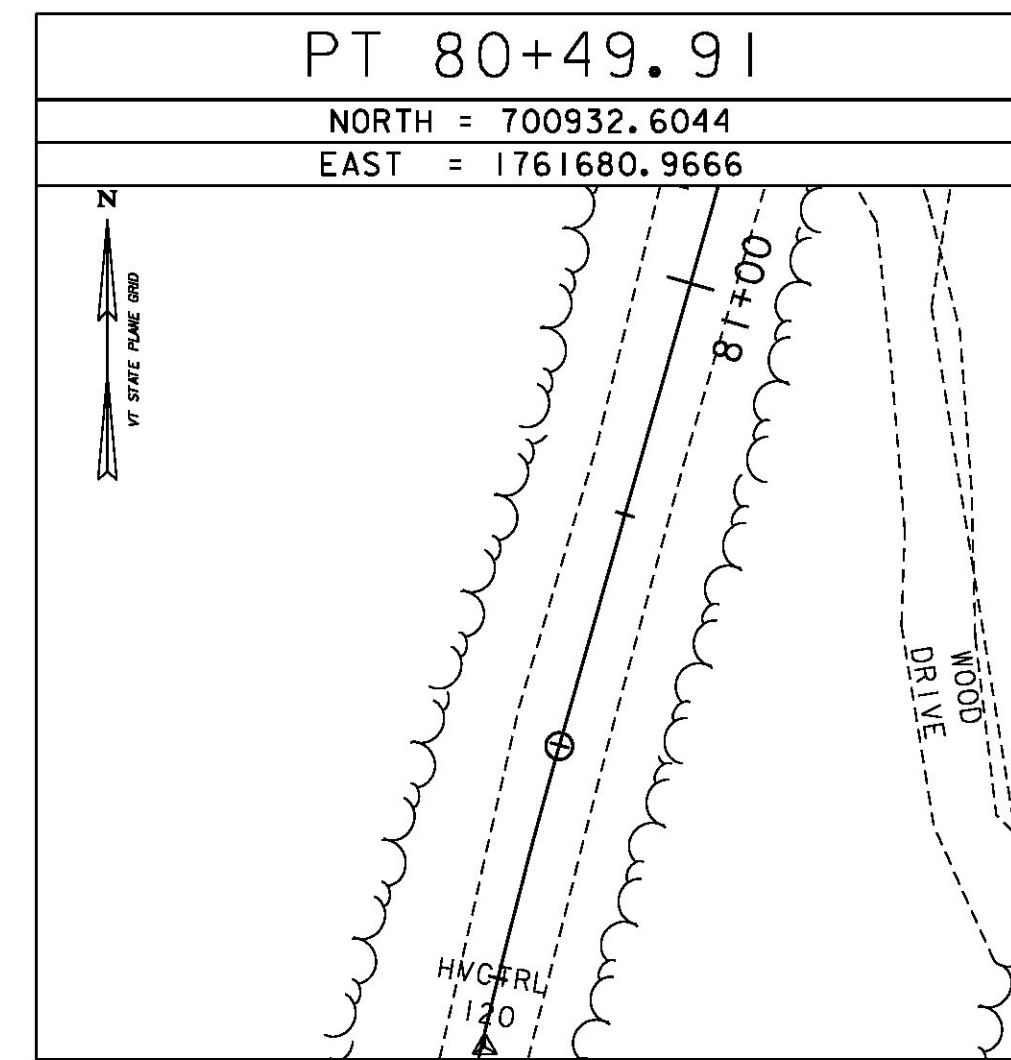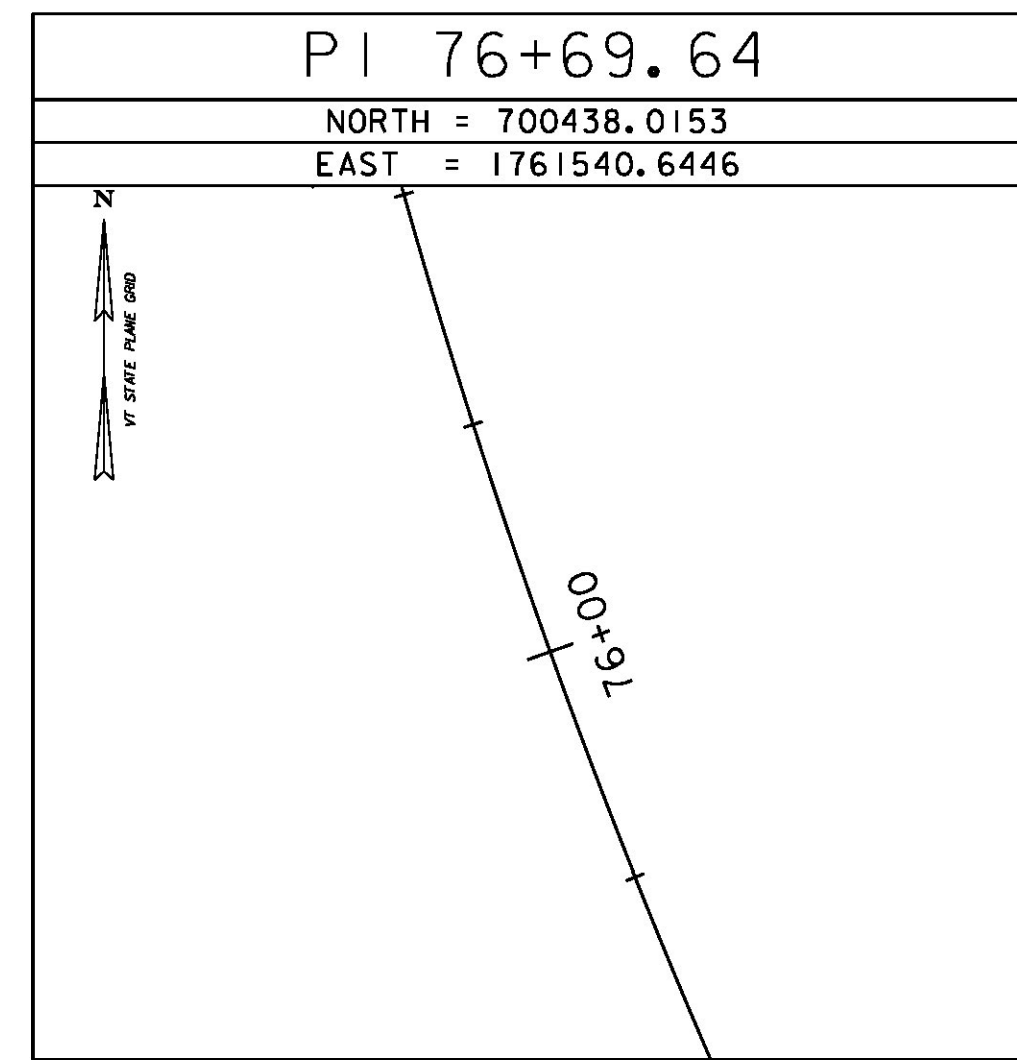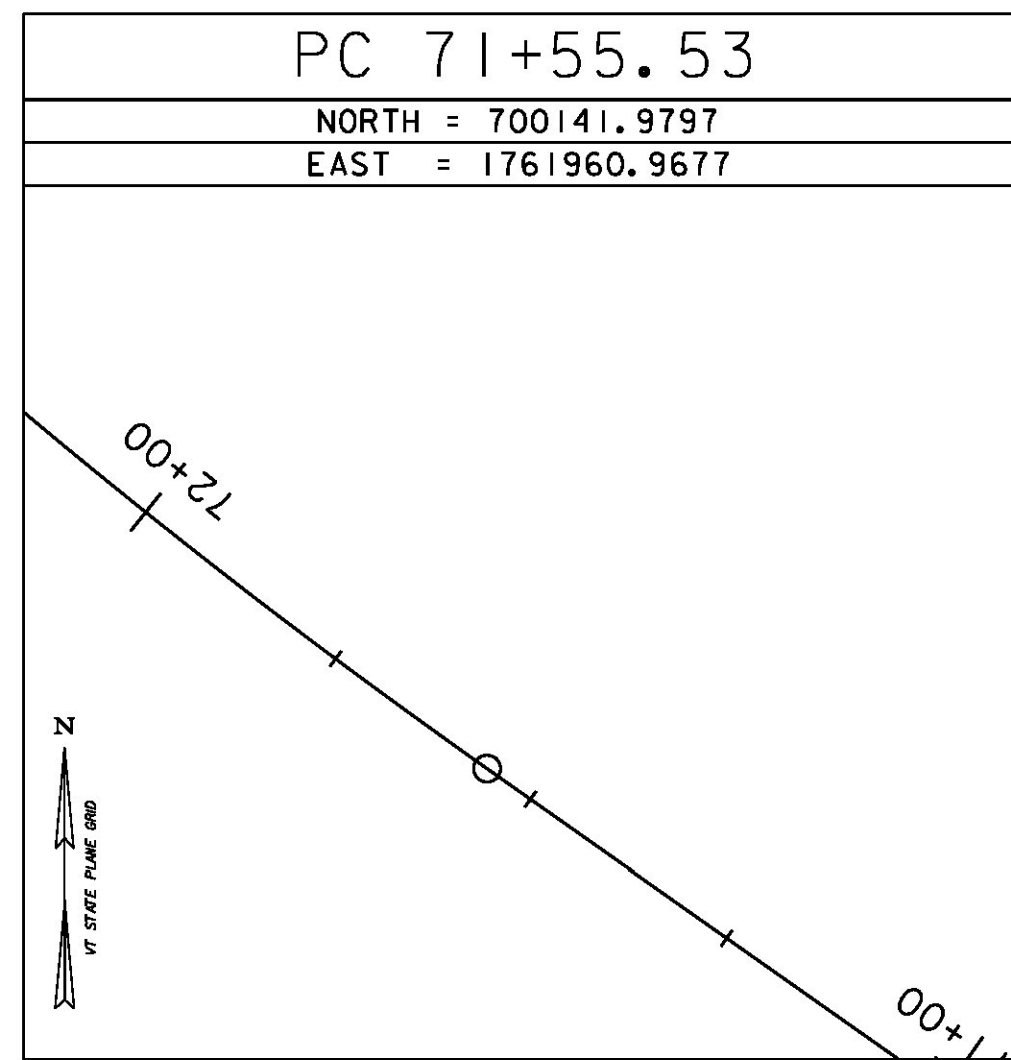

CLD_14-016 MODEL: TIE_02

PROJECT NAME: ST. JOHNSBURY
PROJECT NUMBER: BF 7000(20)
FILE NAME: 86e048/cos/z86e048+tie.dgn
PLOT DATE: 10/26/2016
PROJECT LEADER: J. BYATT
DRAWN BY: W.GORDON
DESIGNED BY: M. HALEY
CHECKED BY: P. SHEDD
TIE SHEET 2
SHEET 16 OF 70

