


TEMPORARY 4 INCH WHITE LINE, PAINT  
DURABLE 4 INCH WHITE LINE  
61+00 TO 65+75 LT & RT

TEMPORARY 4 INCH YELLOW LINE, PAINT  
DURABLE 4 INCH YELLOW LINE  
61+00 TO 65+75 LT & RT

REMOVING SIGNS  
AS SHOWN - 8

ERECTING SALVAGED SIGNS  
AS SHOWN - 2

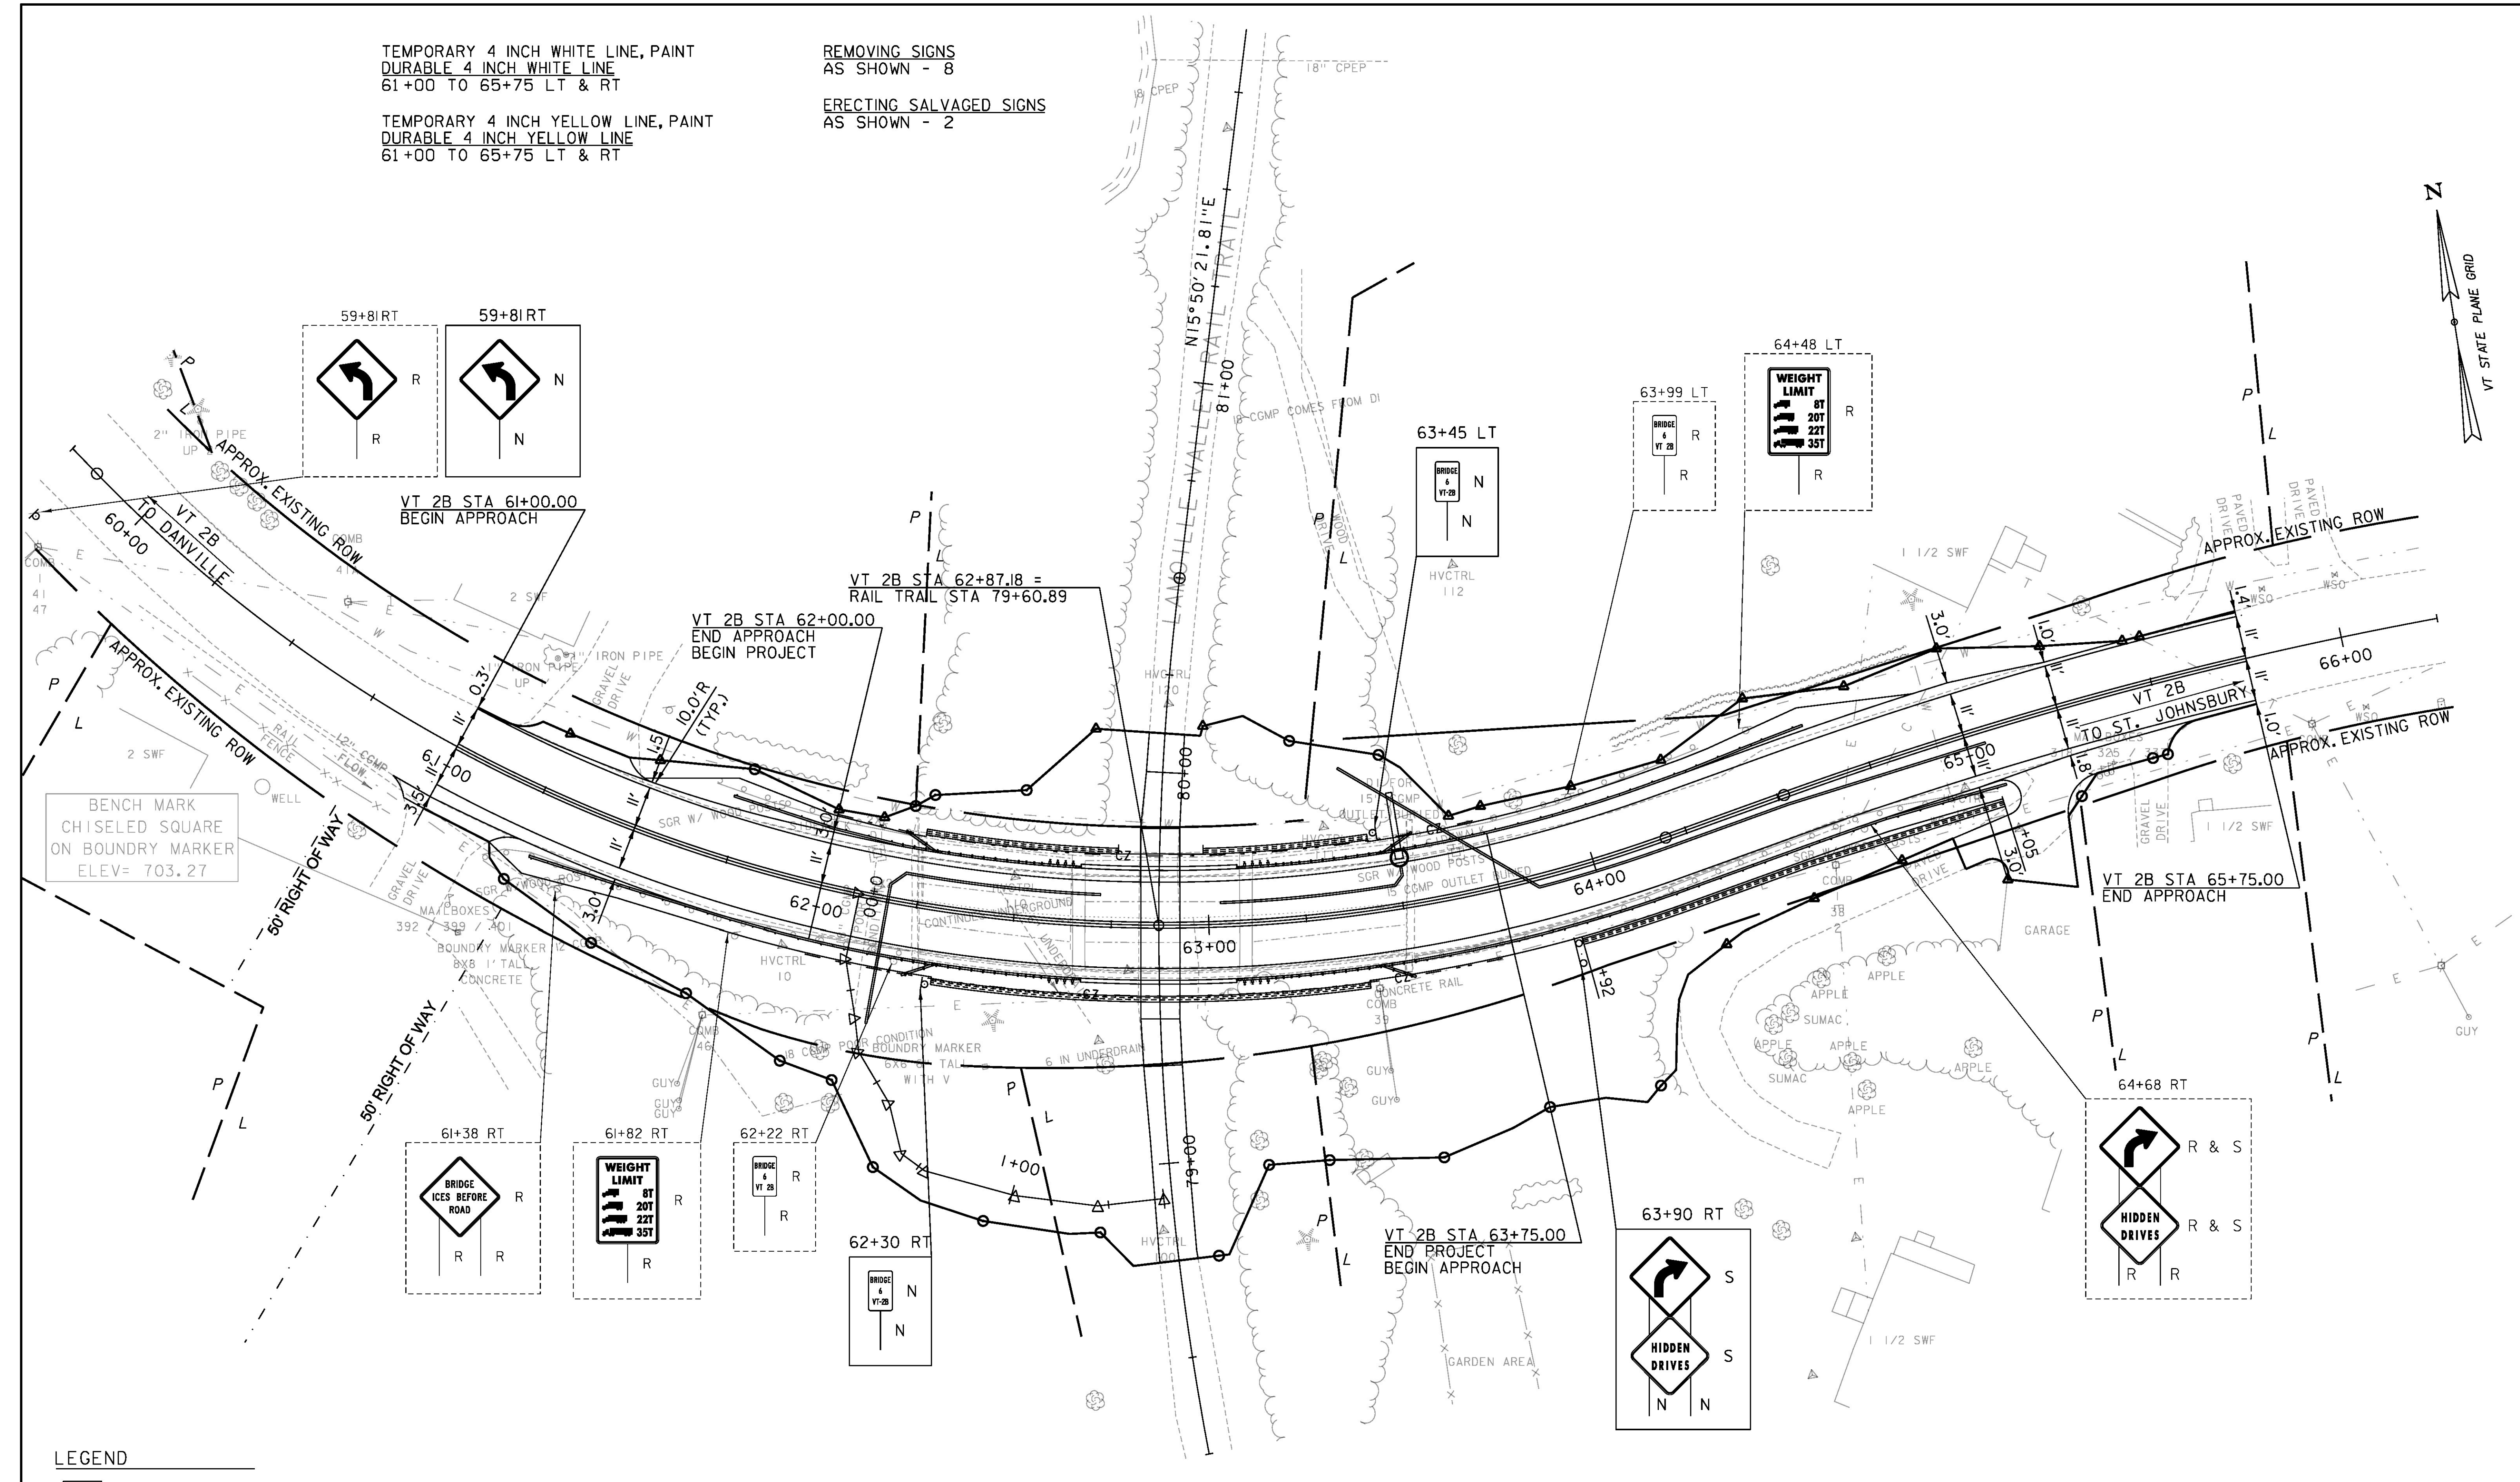


BENCH MARK  
CHISELED SQUARE  
ON BOUNDARY MARKER  
ELEV= 703.27

LEGEND

N	NEW SIGN
RET	RETAIN SIGN
S	SALVAGE SIGN
R	REMOVE SIGN

EXISTING BRIDGE DATA  
THREE SPAN ROLLED BEAM,  
CONCRETE DECK BUILT 1936.  
129' LENGTH, 42' MAX SPAN  
26'-5" MIN UNDERCLEAR.

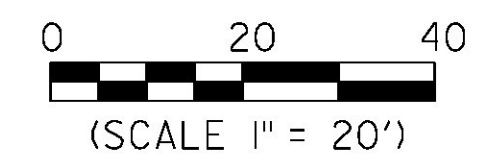

PROJECT NAME:	ST. JOHNSBURY
PROJECT NUMBER:	BF 7000(20)
FILE NAME:	86e048/cos/z86e048bdrts.dgn
PROJECT LEADER:	J.BYATT
DESIGNED BY:	M.HALEY
SIGNING AND STRIPING LAYOUT SHEET	
PLOT DATE:	10/26/2016
DRAWN BY:	W.GORDON
CHECKED BY:	P.SHEDD
SHEET	25 OF 70

CLD 14-016