



NOTES:


1. SEE STANDARDS S-352A, S-352B, AND S-352C FOR ADDITIONAL INFORMATION.
2. THE BRIDGE PLAQUE FURNISHED BY THE AGENCY SHALL BE CAST INTO THE FACE OF THE RAIL AT THE NORTHEAST CORNER AS SHOWN IN THE BRIDGE PLAQUE LOCATION DETAIL BELOW. ALL WORK TO INSTALL THE PLAQUE WILL BE CONSIDERED INCIDENTAL TO CONTRACT ITEM 525.45, "BRIDGE RAILING, GALVANIZED STEEL TUBING/CONCRETE COMBINATION (COATED BLACK)". SEE STRUCTURES DETAIL SD-502.00 FOR FURTHER DETAILS.
3. SEE SHEET 49 FOR APPROACH RAIL CONNECTION DETAIL.

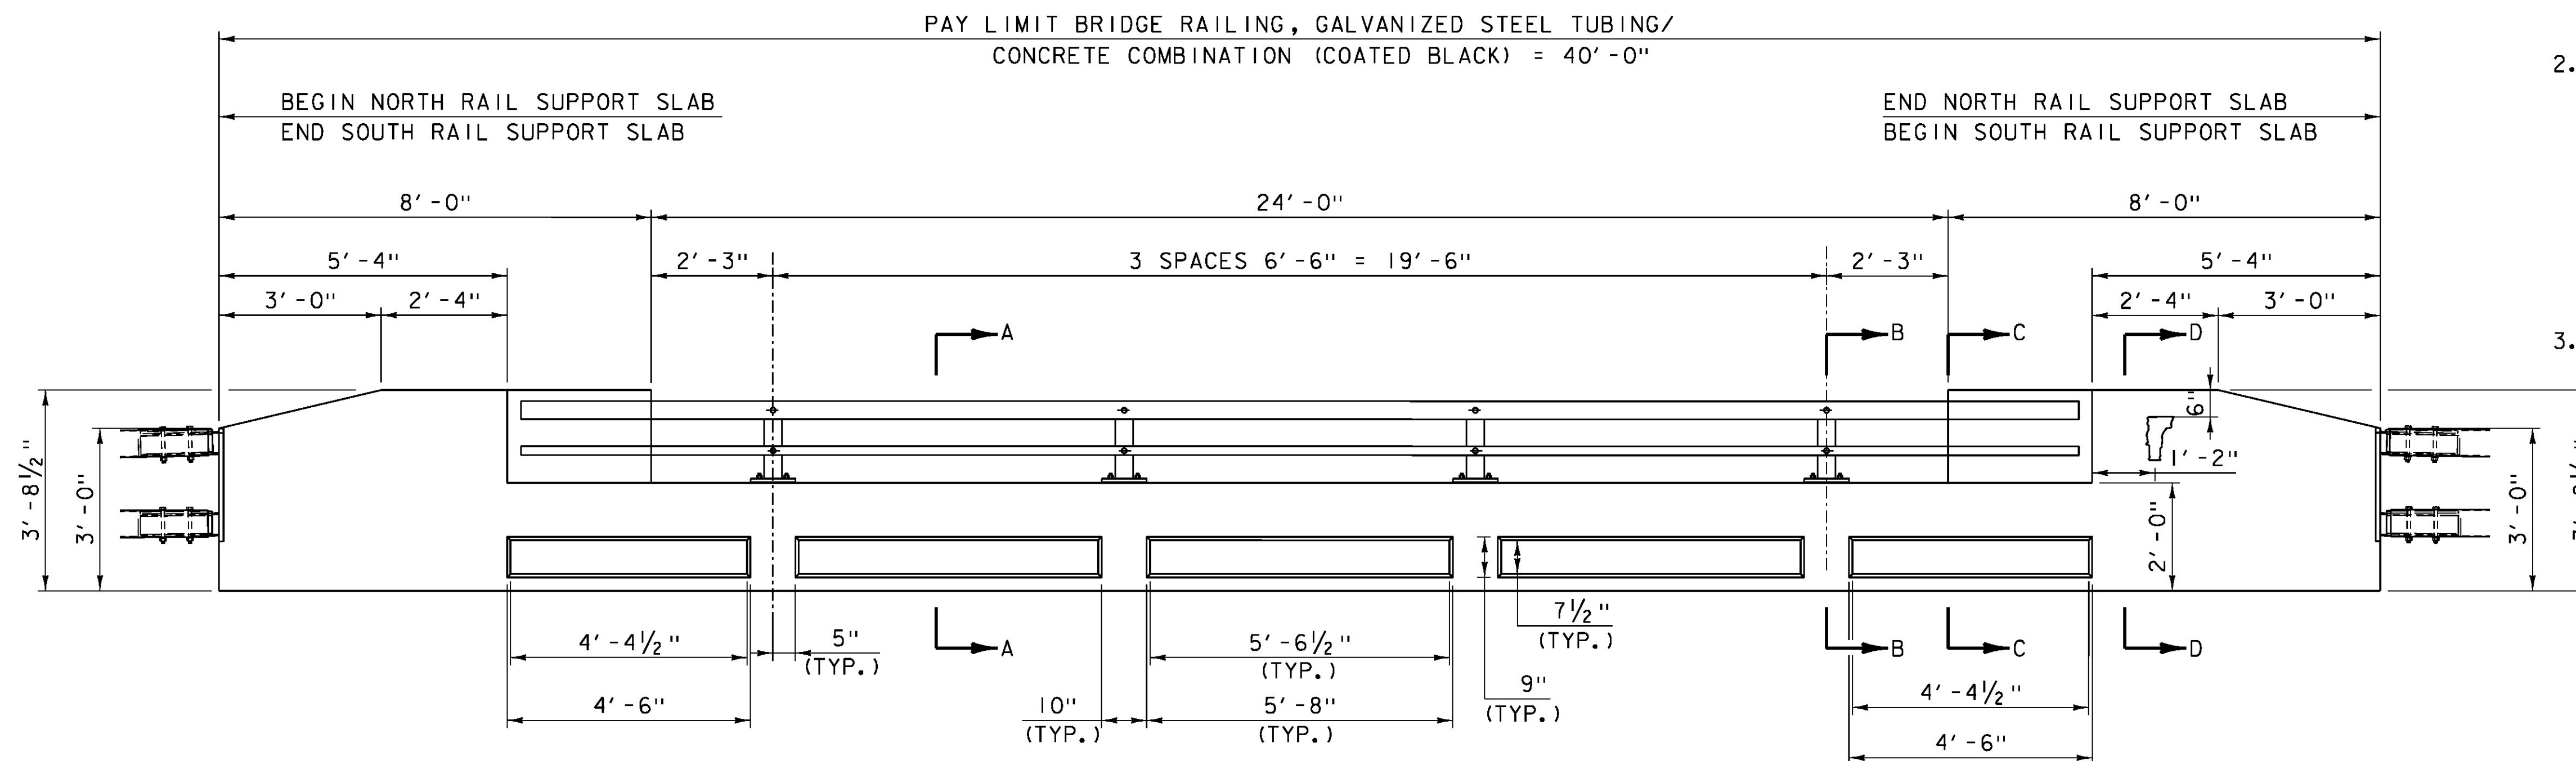


ROADWAY ELEVATION OF RAIL
SCALE: 1/2" = 1'-0"

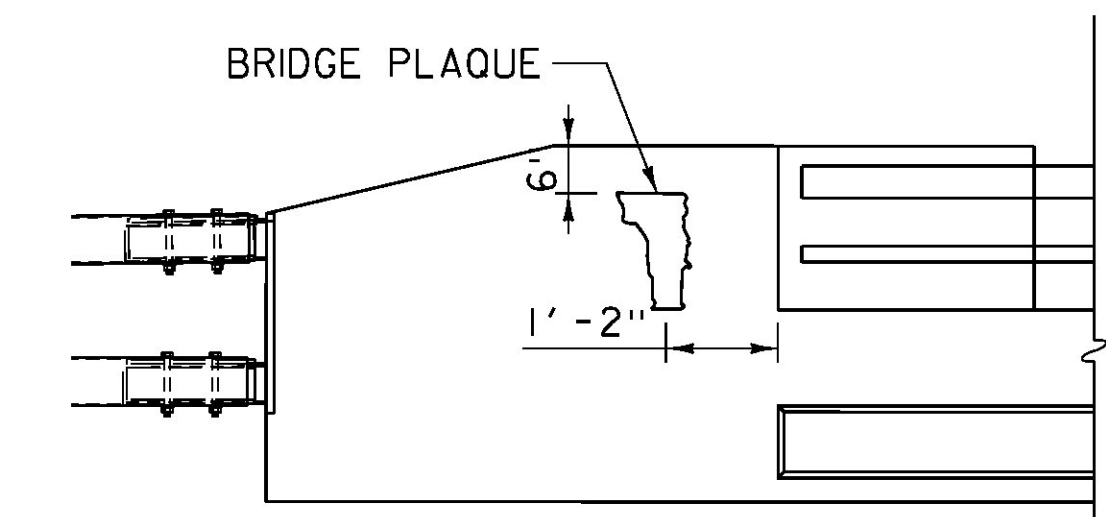


BRIDGE PLAQUE LOCATION DETAIL
SCALE: 1/2" = 1'-0"

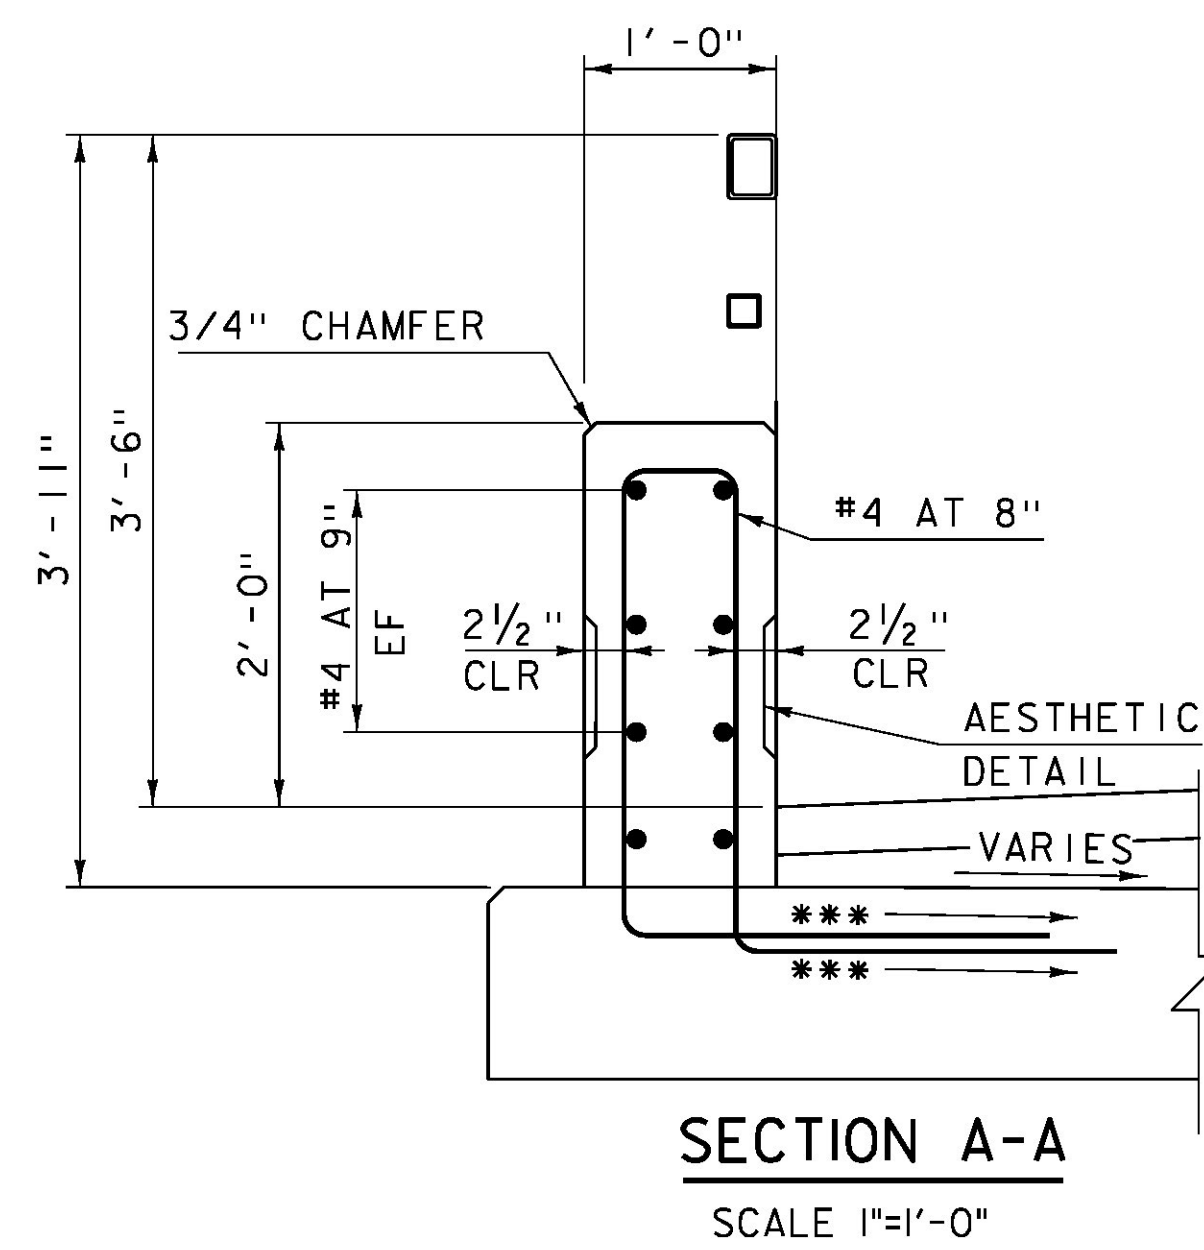


SECTION A-A
SCALE 1"=1'-0"

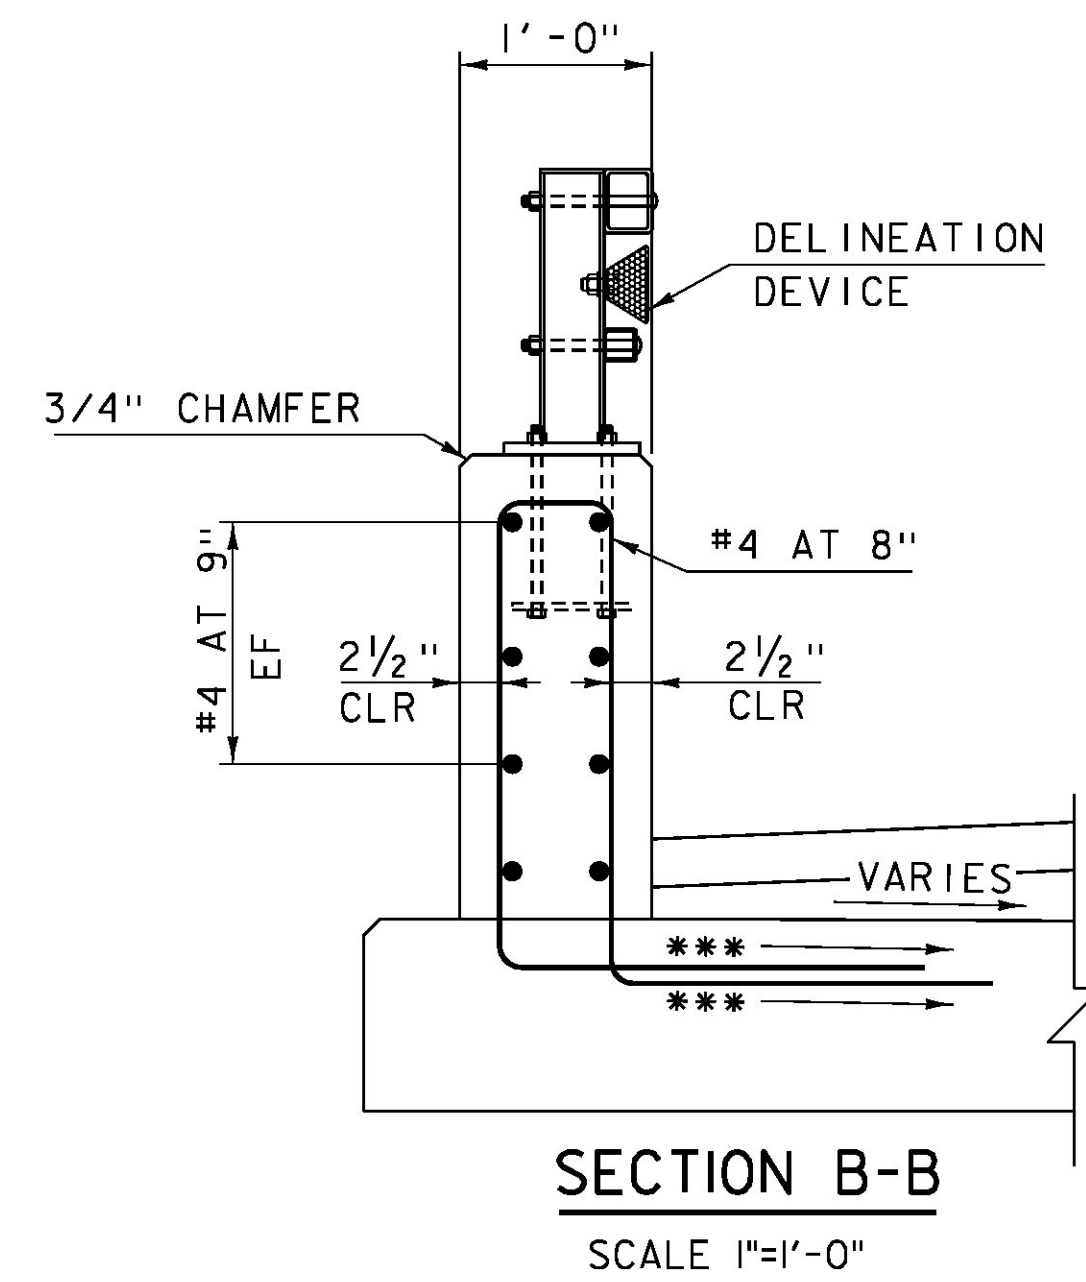

SECTION B-B
SCALE 1"=1'-0"

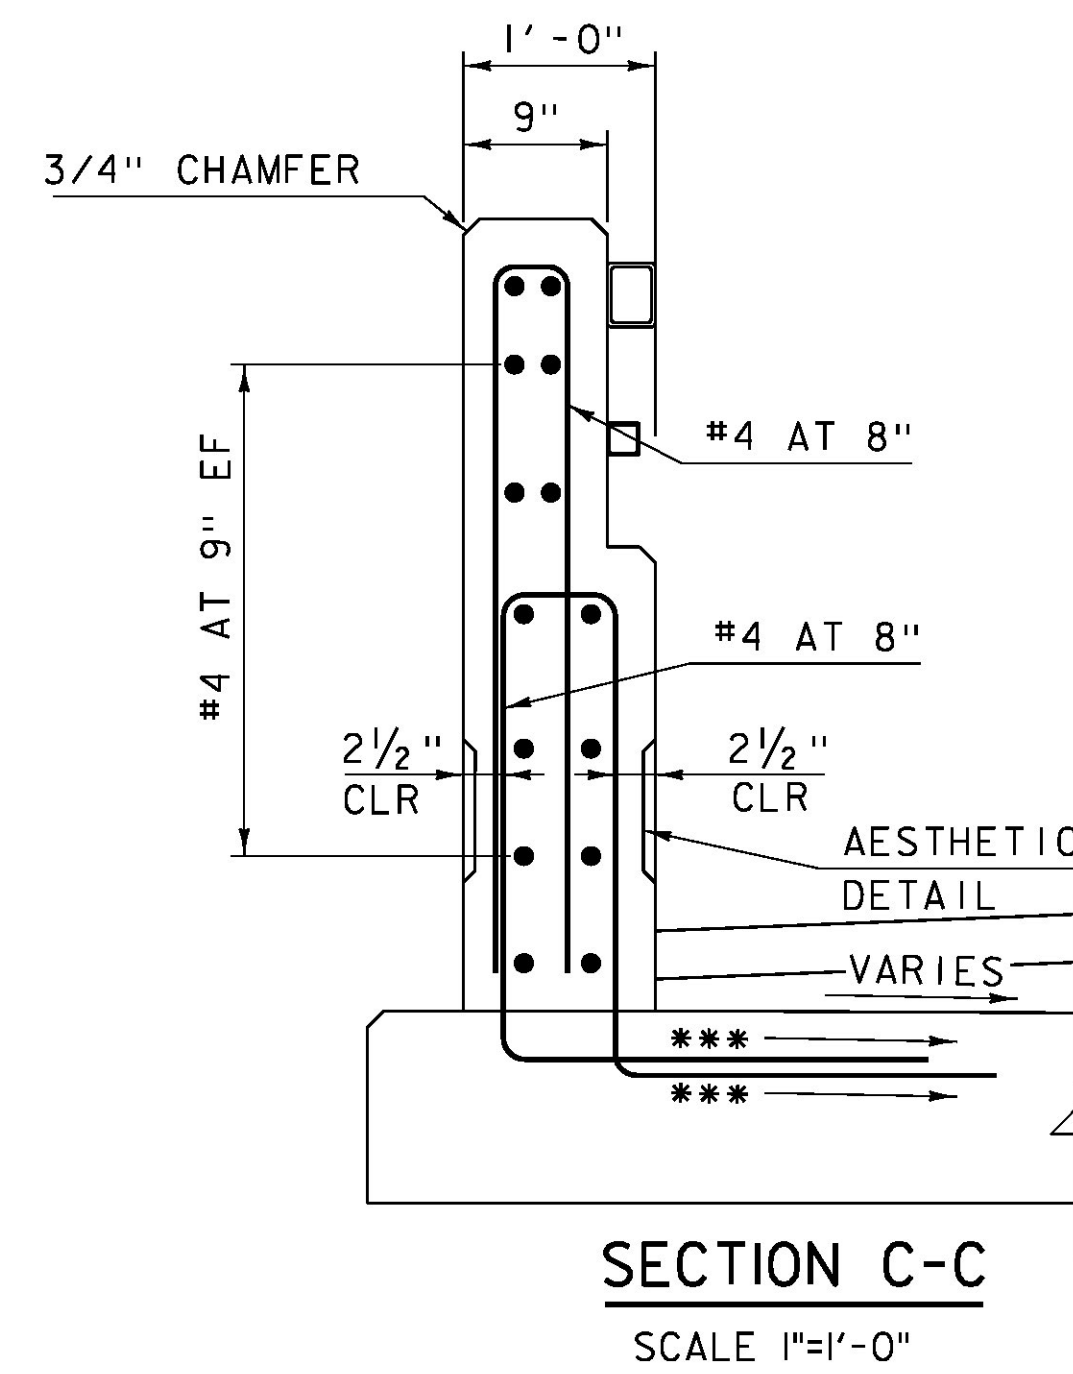

SECTION C-C
SCALE 1"=1'-0"

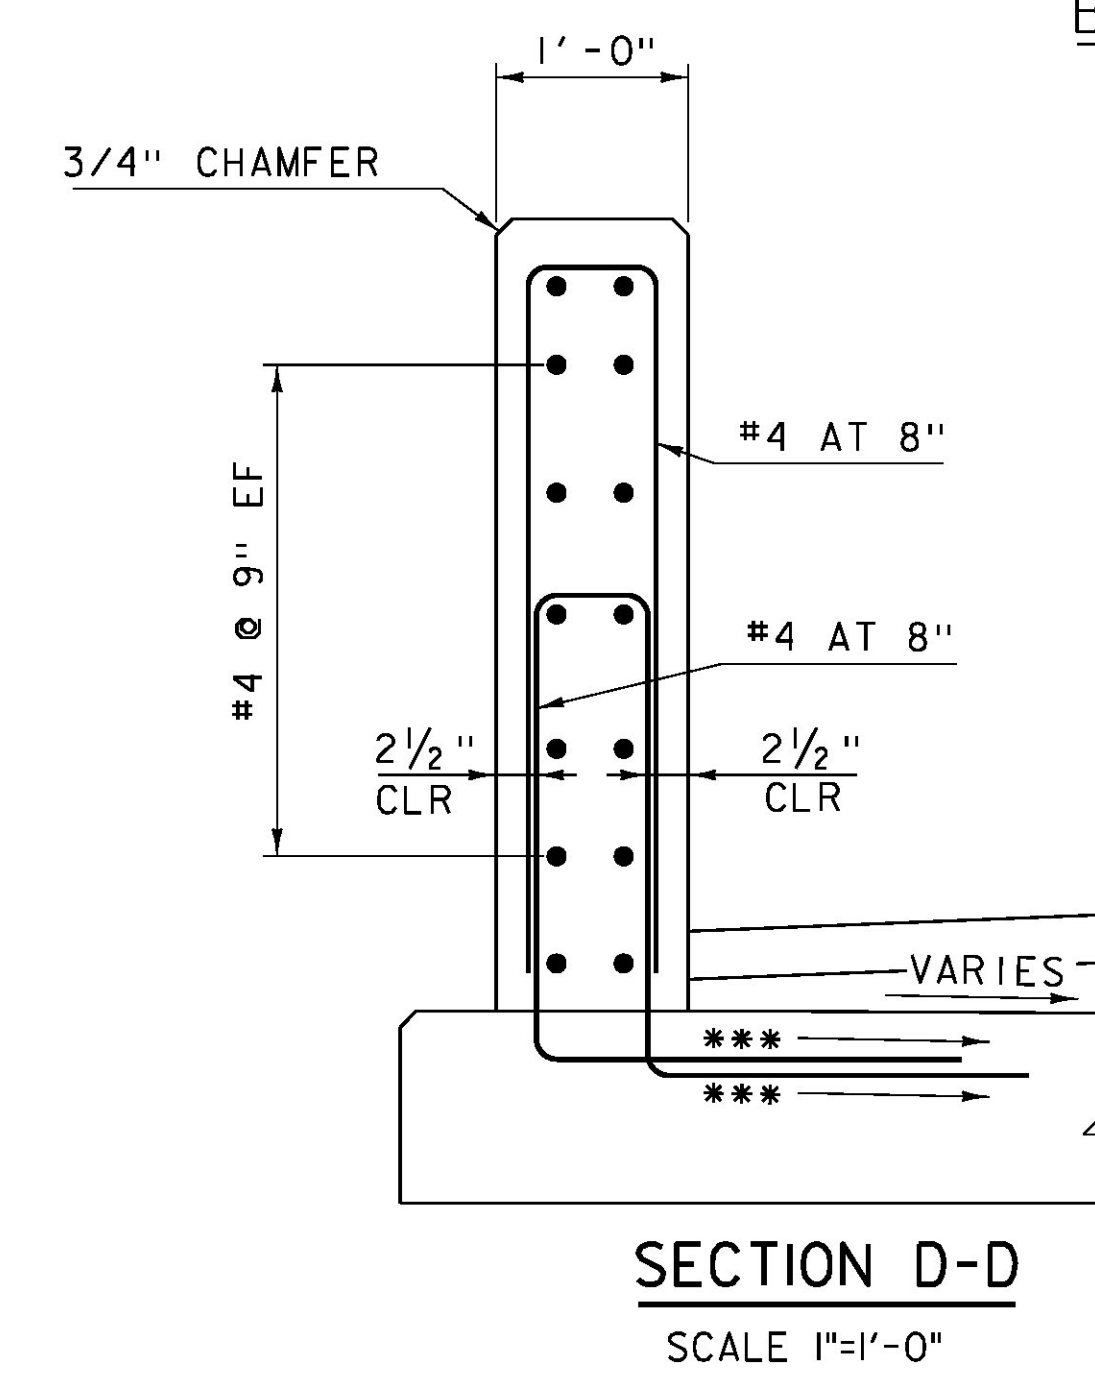

SECTION D-D
SCALE 1"=1'-0"

NOTES:

- NF = NEAR FACE
- FF = FAR FACE
- EF = EACH FACE
- 3" CLEAR, UNLESS OTHERWISE SPECIFIED ON THE PLANS.
- 2'-2" BAR LAP UNLESS OTHERWISE SPECIFIED ON THE PLANS
- *** MATCH SLOPE OF NEAREST TRANSVERSE STEEL

MODEL: Sheet02
CLD 14-016

PROJECT NAME:	ST. JOHNSBURY
PROJECT NUMBER:	BF 7000(20)
FILE NAME:	86e048/cos/z86e048rail.dgn
PROJECT LEADER:	J. BYATT
DESIGNED BY:	M. SMITH
BRIDGE RAIL DETAILS SHEET	
PLOT DATE:	10/26/2016
DRAWN BY:	M. SMITH
CHECKED BY:	S. BEAUMONT
SHEET	47 OF 70

