



MODEL: Sheet03
CLD 14-016

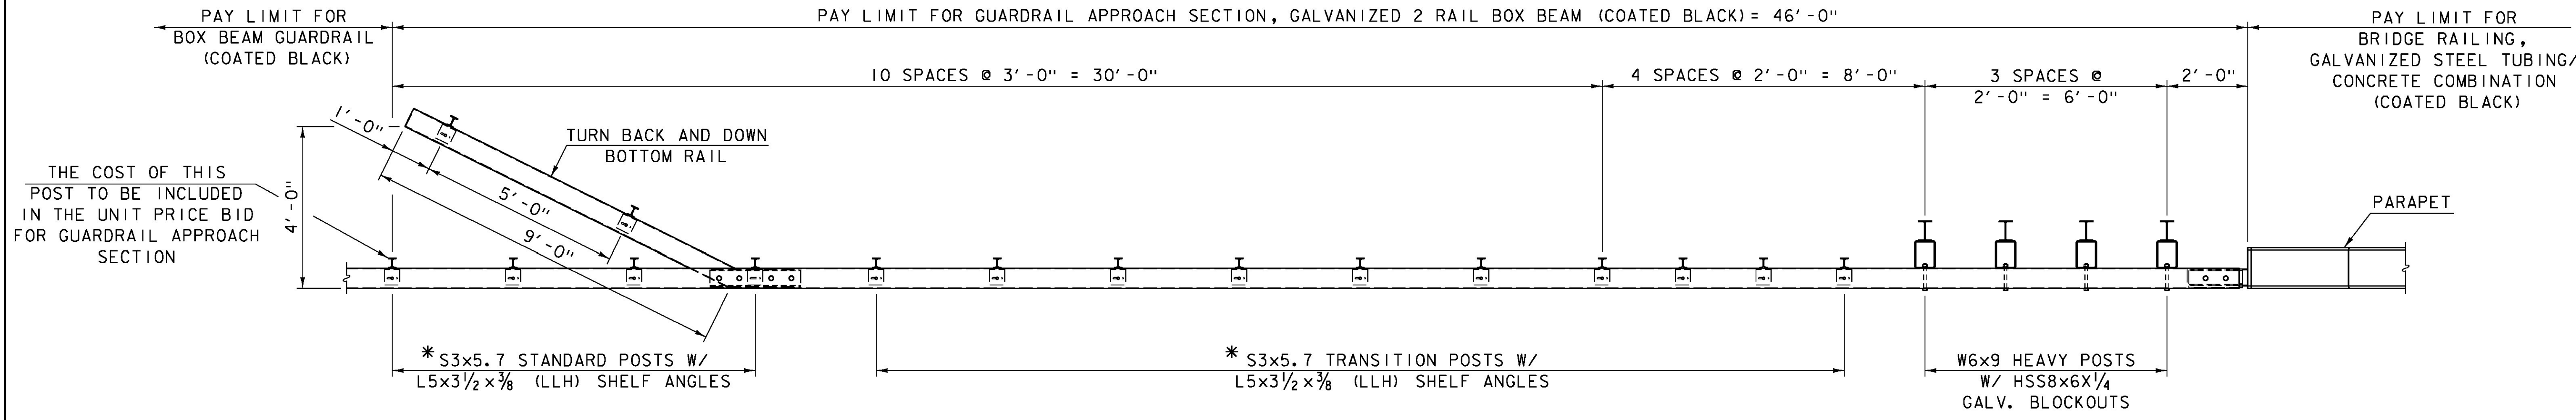

APPROACH RAIL PLAN
NOT TO SCALE

* SEE STD. G1-BM FOR POST CONNECTION DETAILS

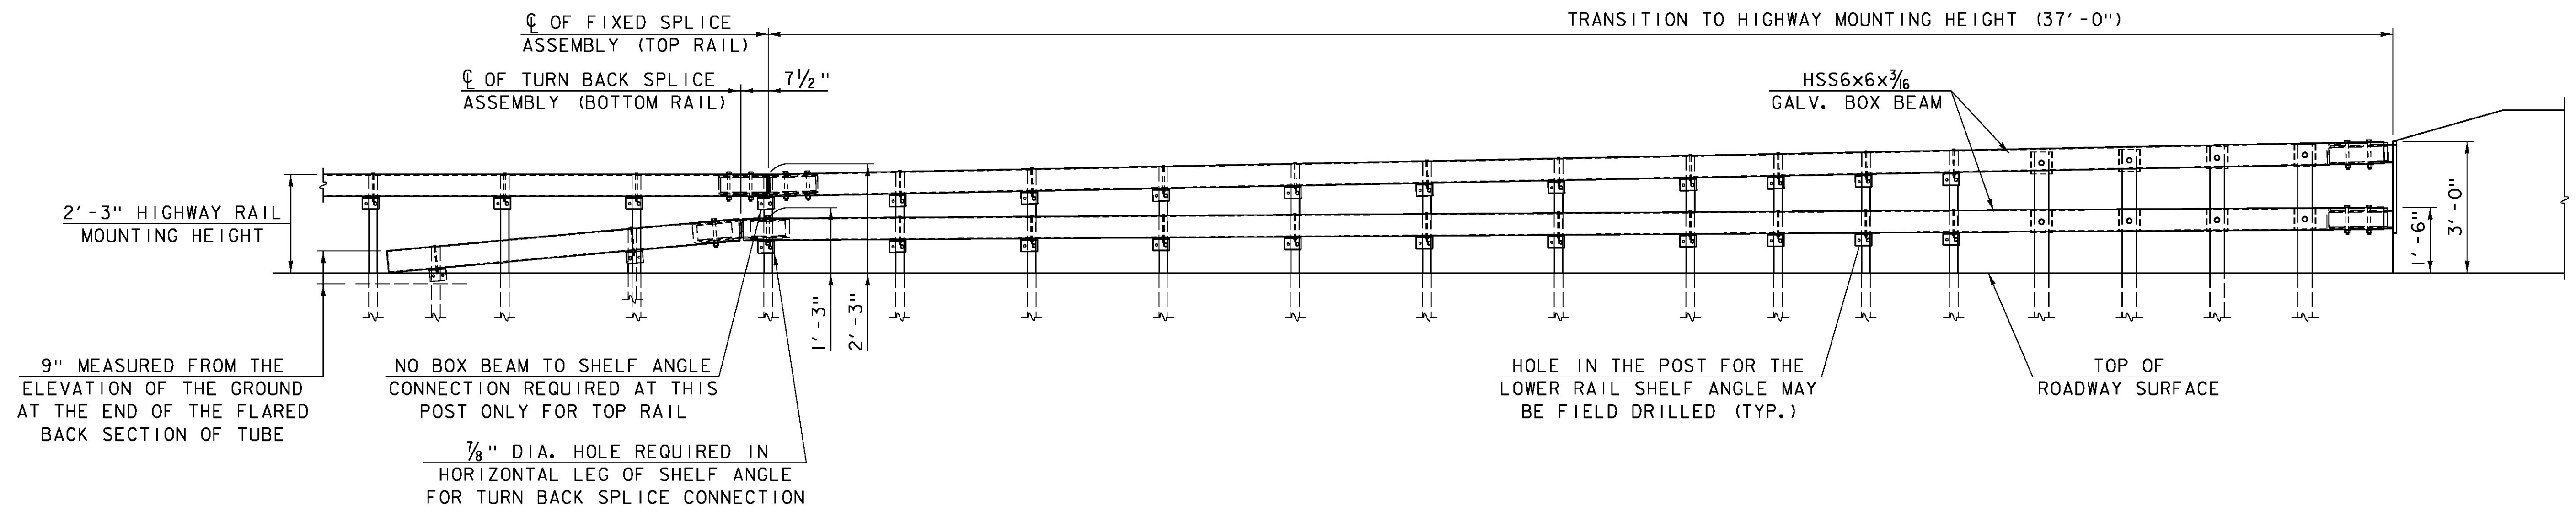

APPROACH RAIL ELEVATION
NOT TO SCALE

PROJECT NAME:	ST. JOHNSBURY
PROJECT NUMBER:	BF 7000(20)
FILE NAME:	86e048/cos/z86e048rail.dgn
PROJECT LEADER:	J. BYATT
DESIGNED BY:	M. SMITH
APPROACH RAIL DETAILS SHEET 1	
PLOT DATE:	10/26/2016
DRAWN BY:	M. SMITH
CHECKED BY:	S. BEAUMONT
SHEET	48 OF 70

