




61+00
DRIVE RT
BEGIN APPROACH

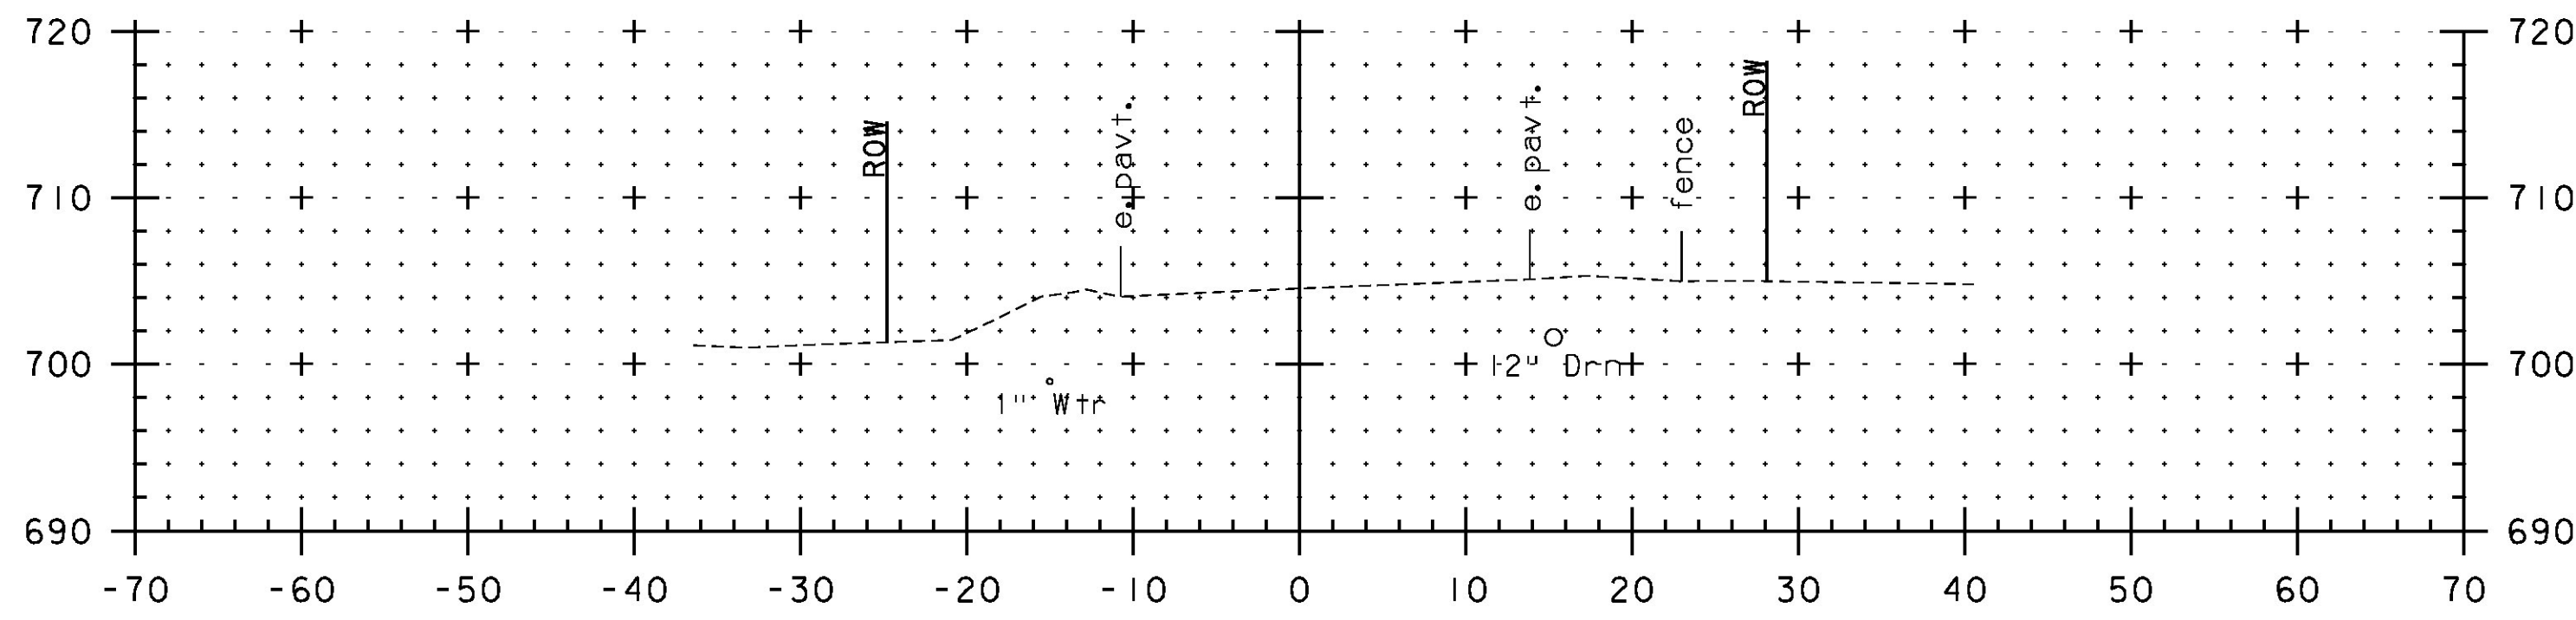


60+75

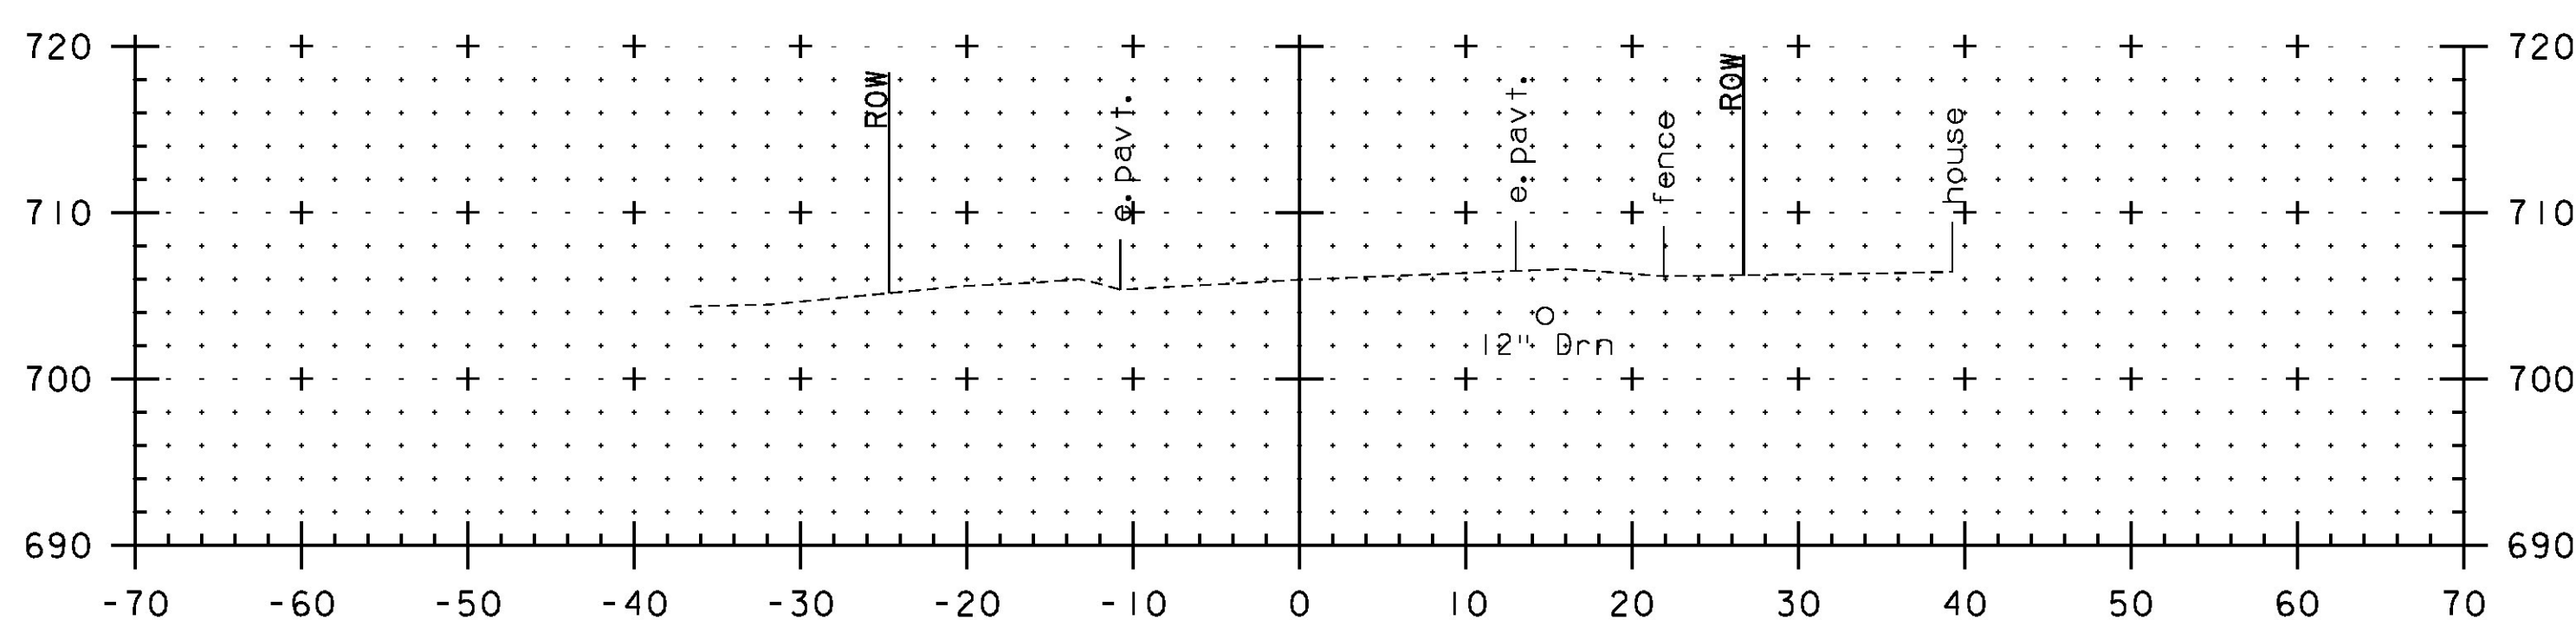


60+50

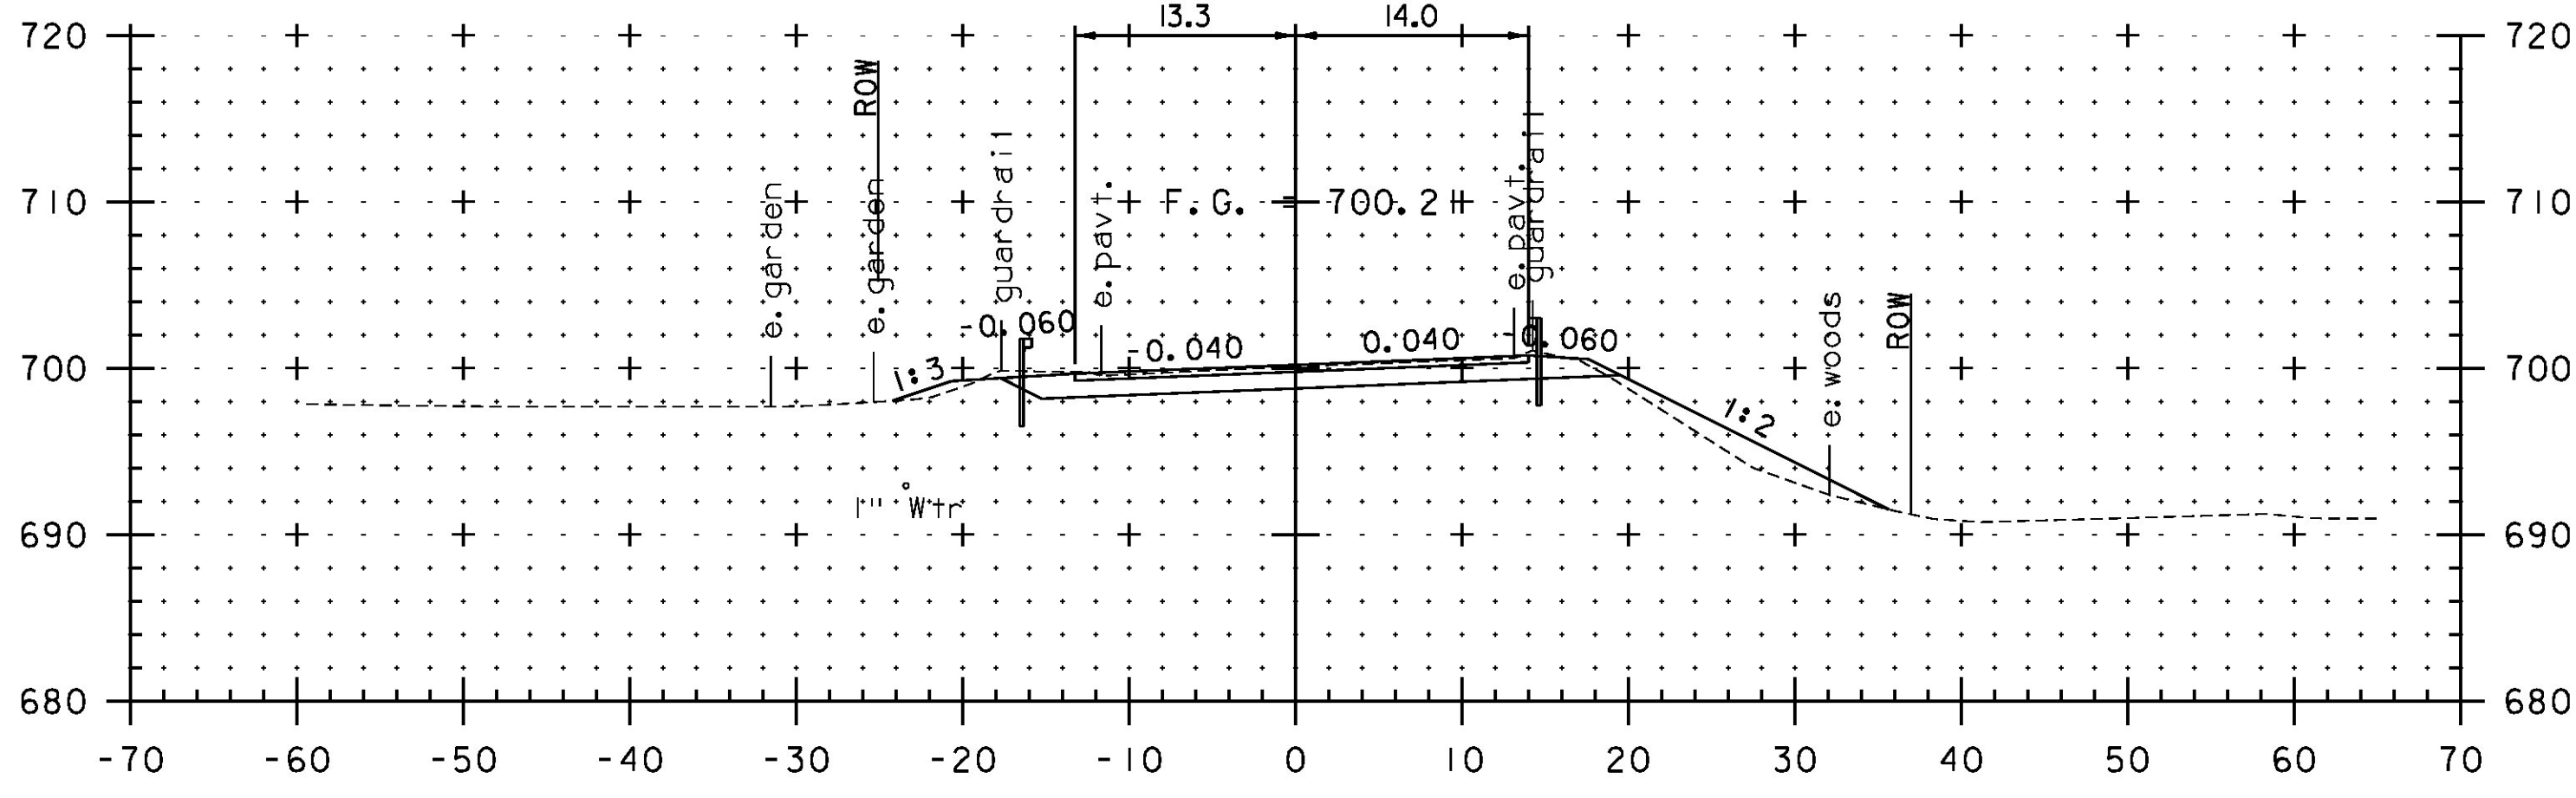

61+75


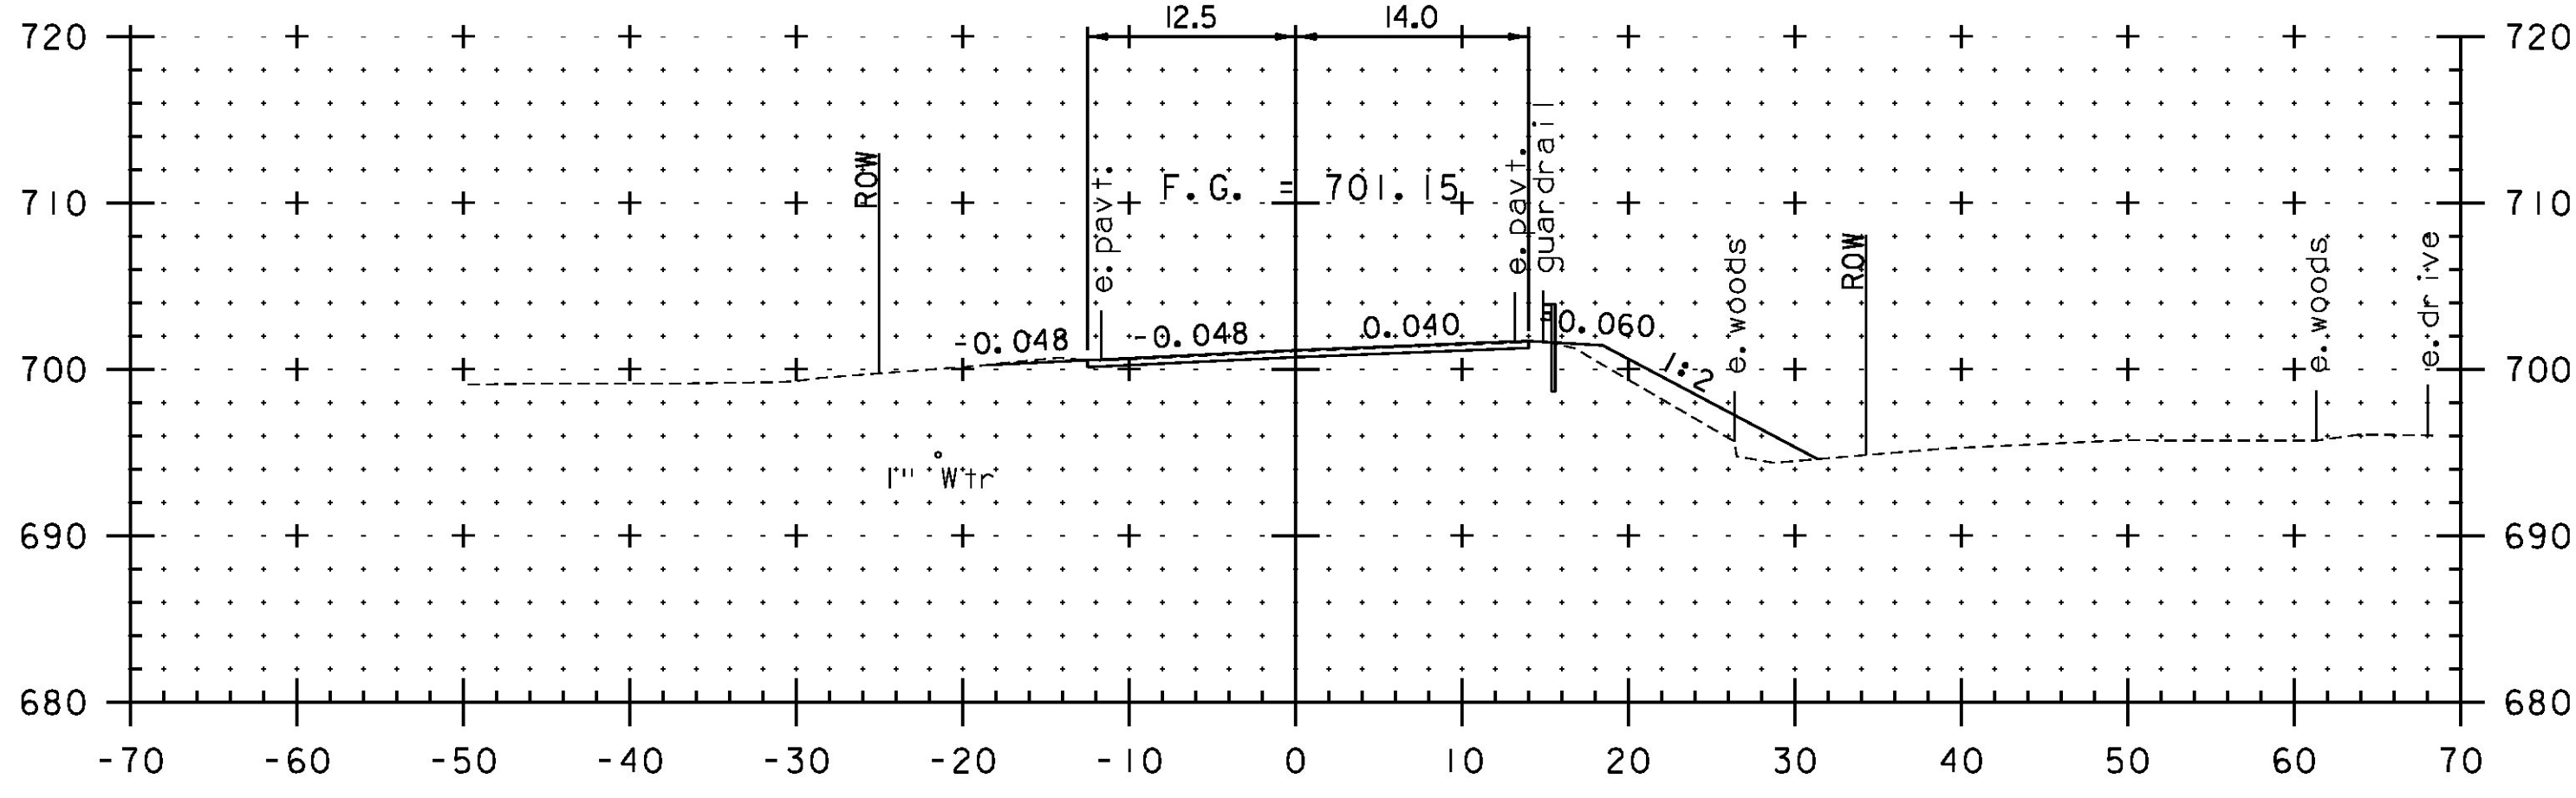


61+50

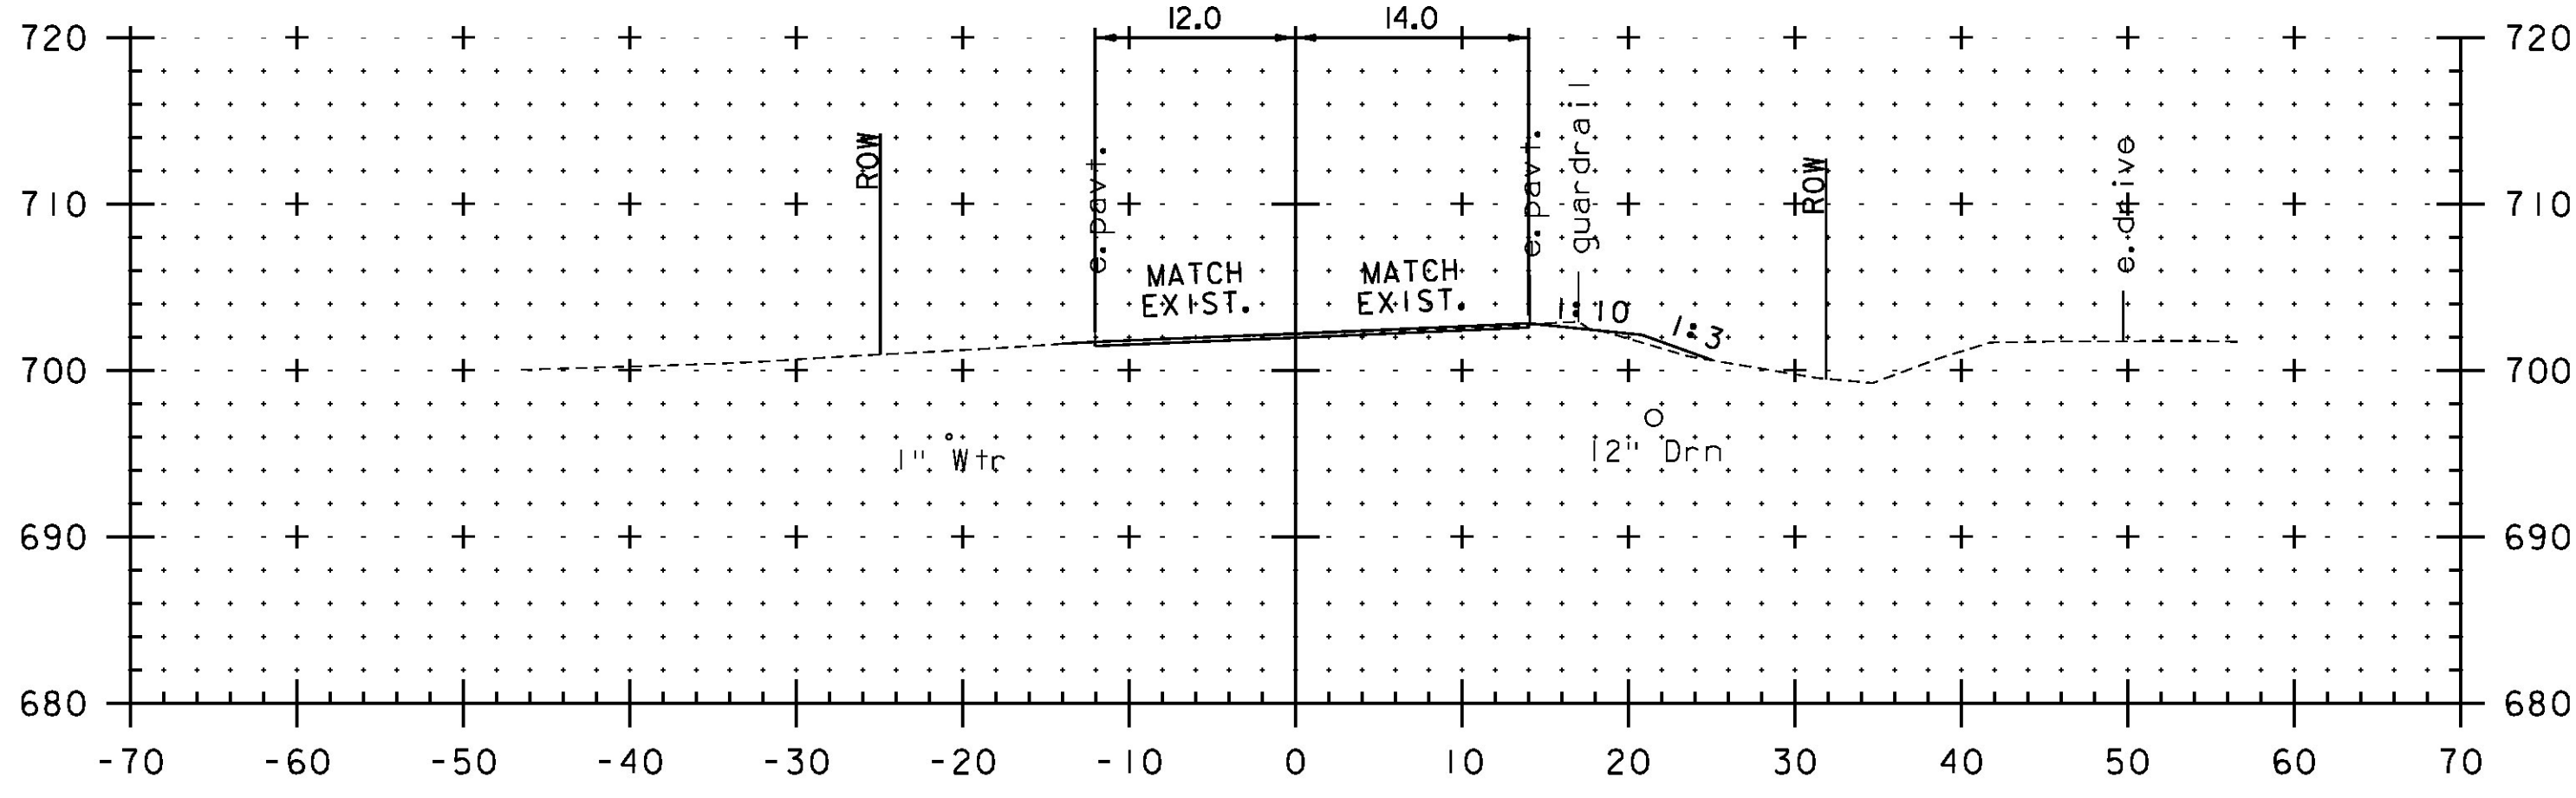

61+25
DRIVE LT

STA. 60+50 TO STA. 61+75

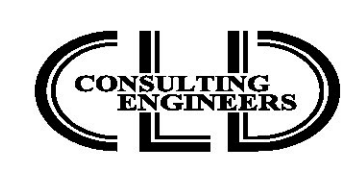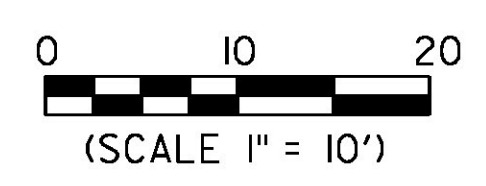

PROJECT NAME:	ST. JOHNSBURY
PROJECT NUMBER:	BF 7000(20)
FILE NAME:	86e048/cos/z86e048xs.dgn
PROJECT LEADER:	J. BYATT
DESIGNED BY:	M. HALEY
VT 2B CROSS SECTIONS:	1
PLOT DATE:	10/26/2016
DRAWN BY:	M. HALEY
CHECKED BY:	P. SHEDD
SHEET:	53 OF 70

CLD 14-016 MODEL: MAINLINE X50