




CLD 14-016
MODEL: MAINLINE XS02

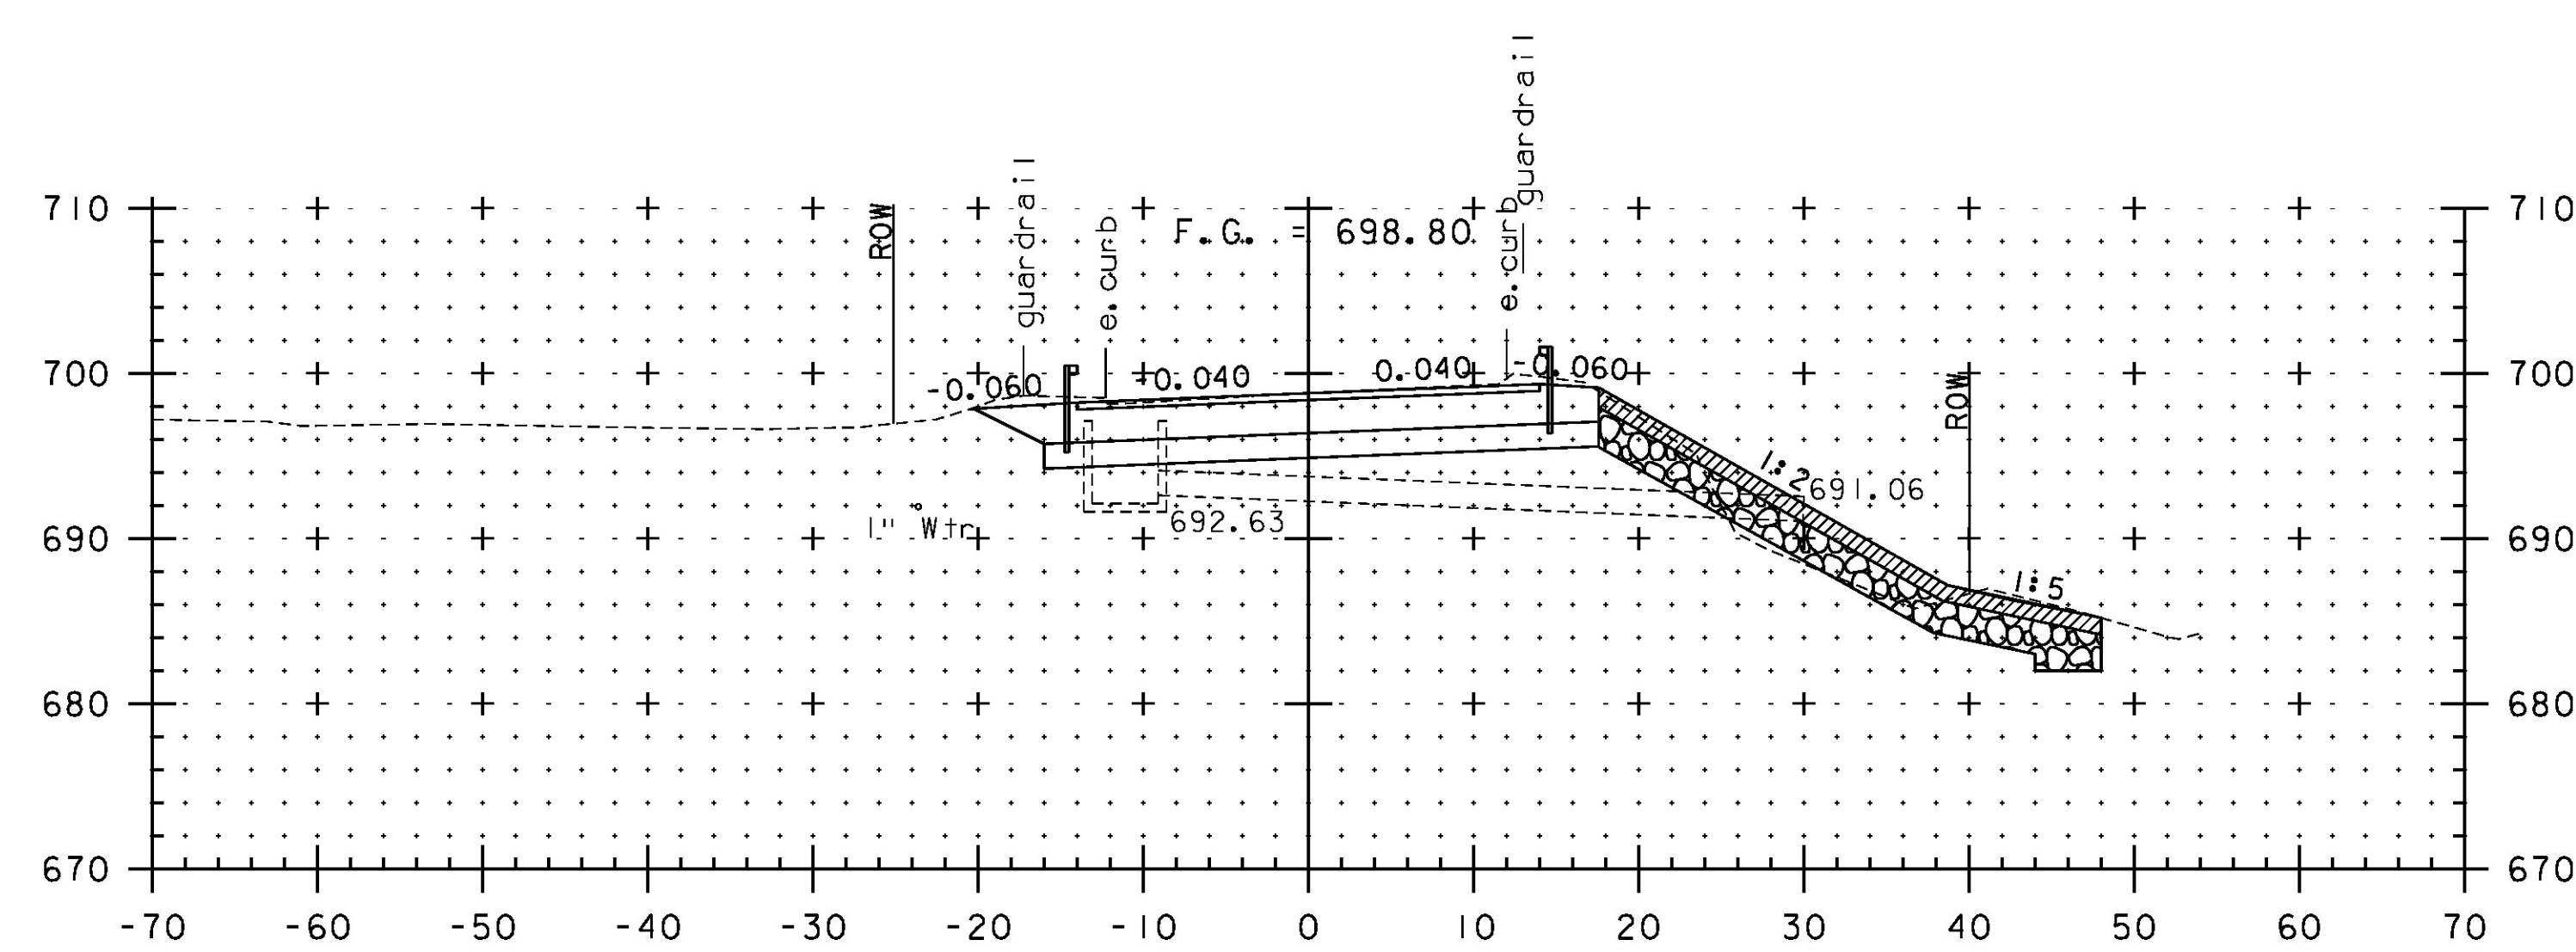


62+12

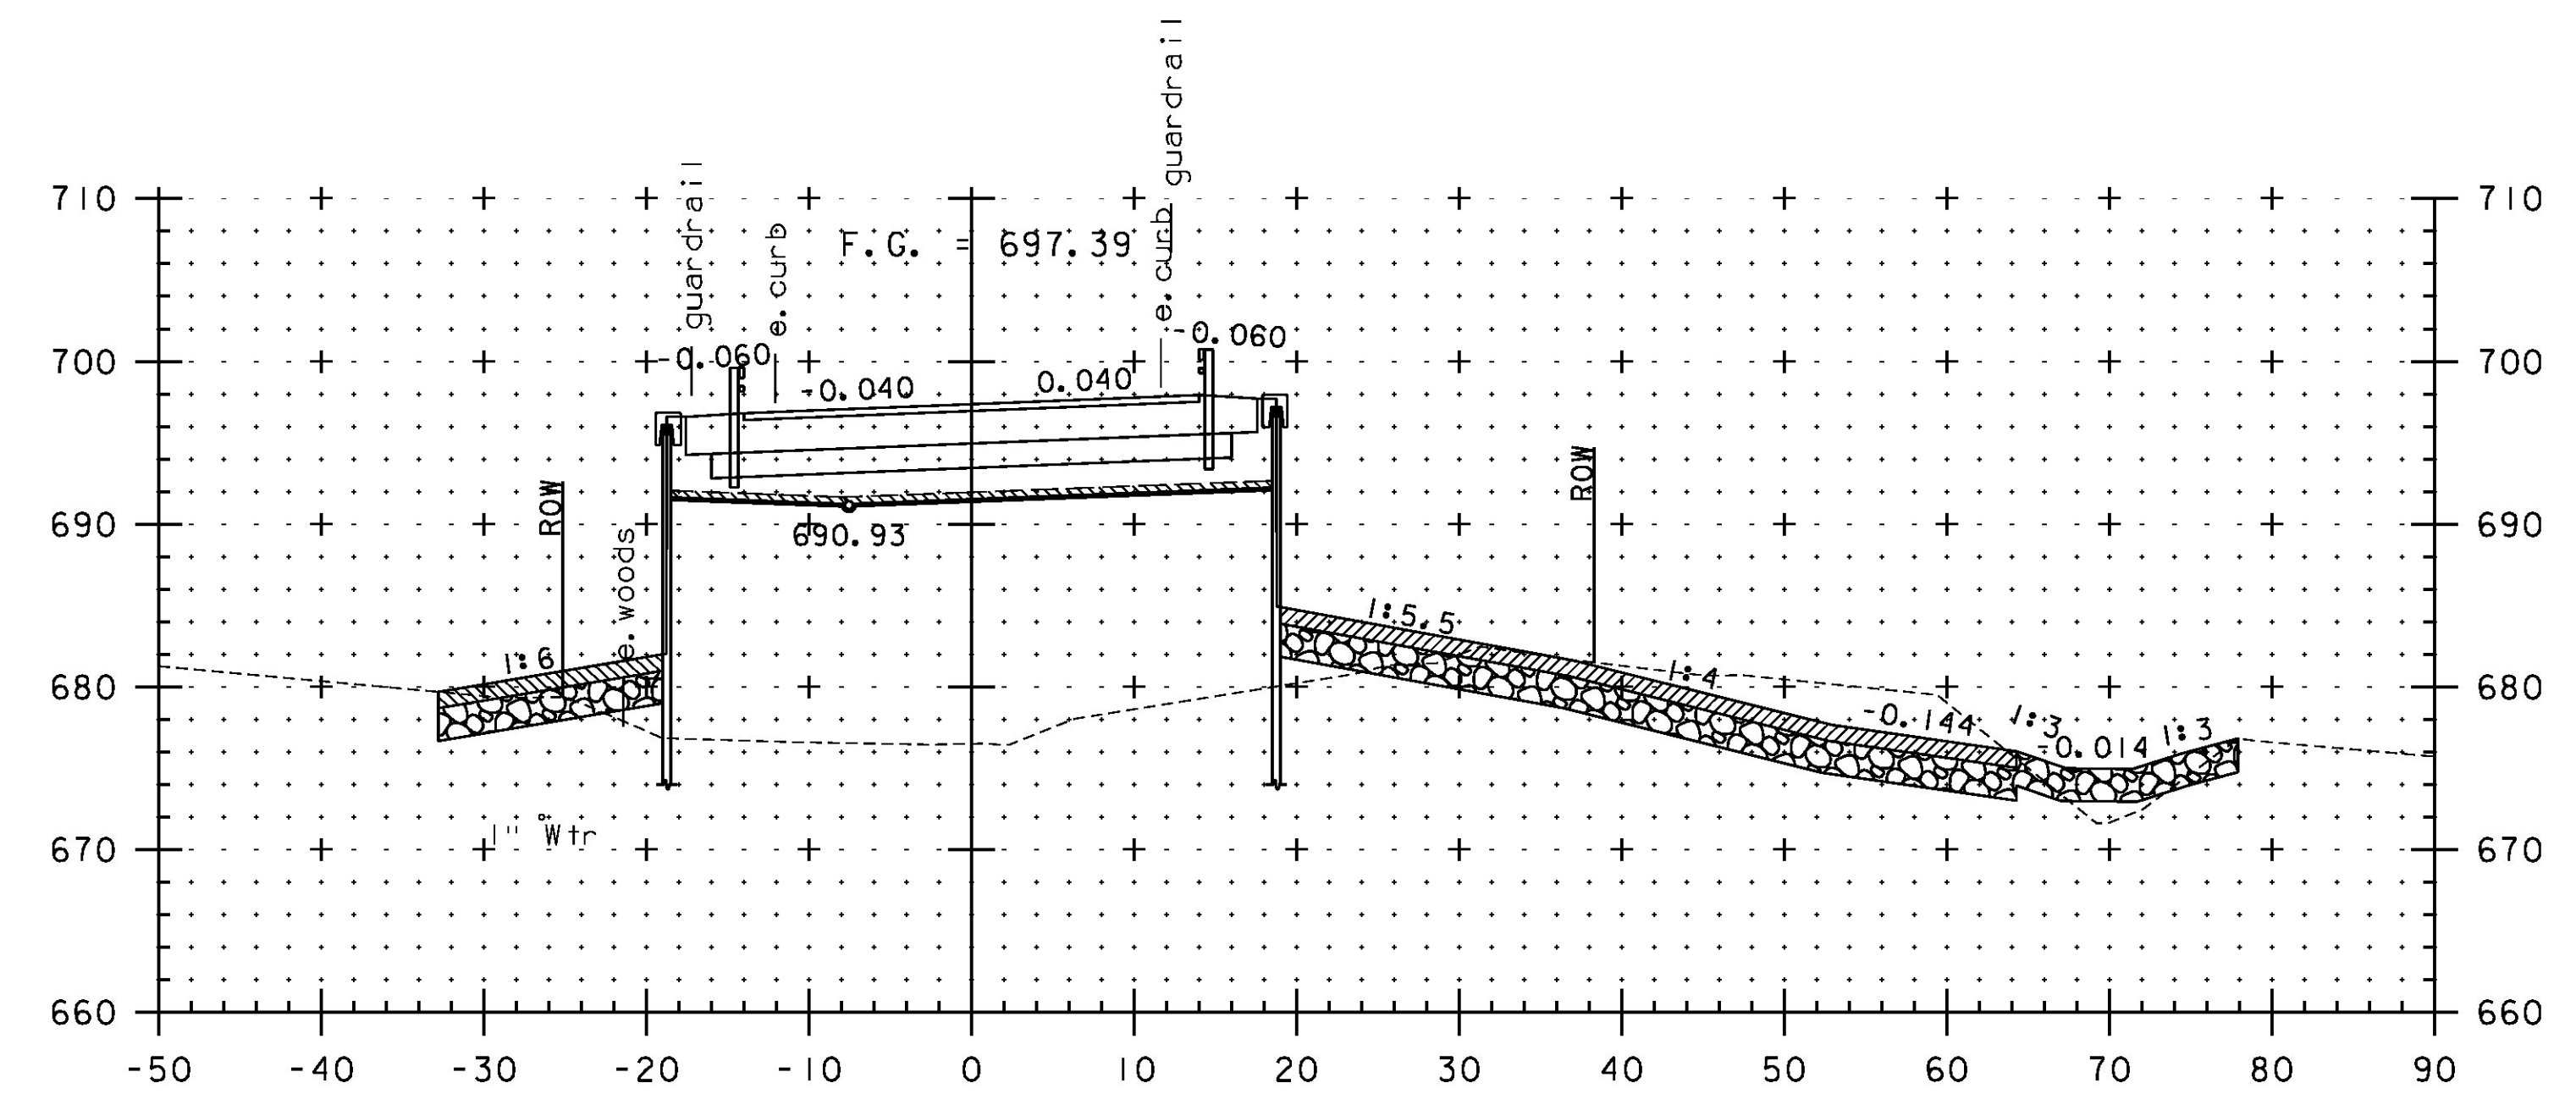

62+50

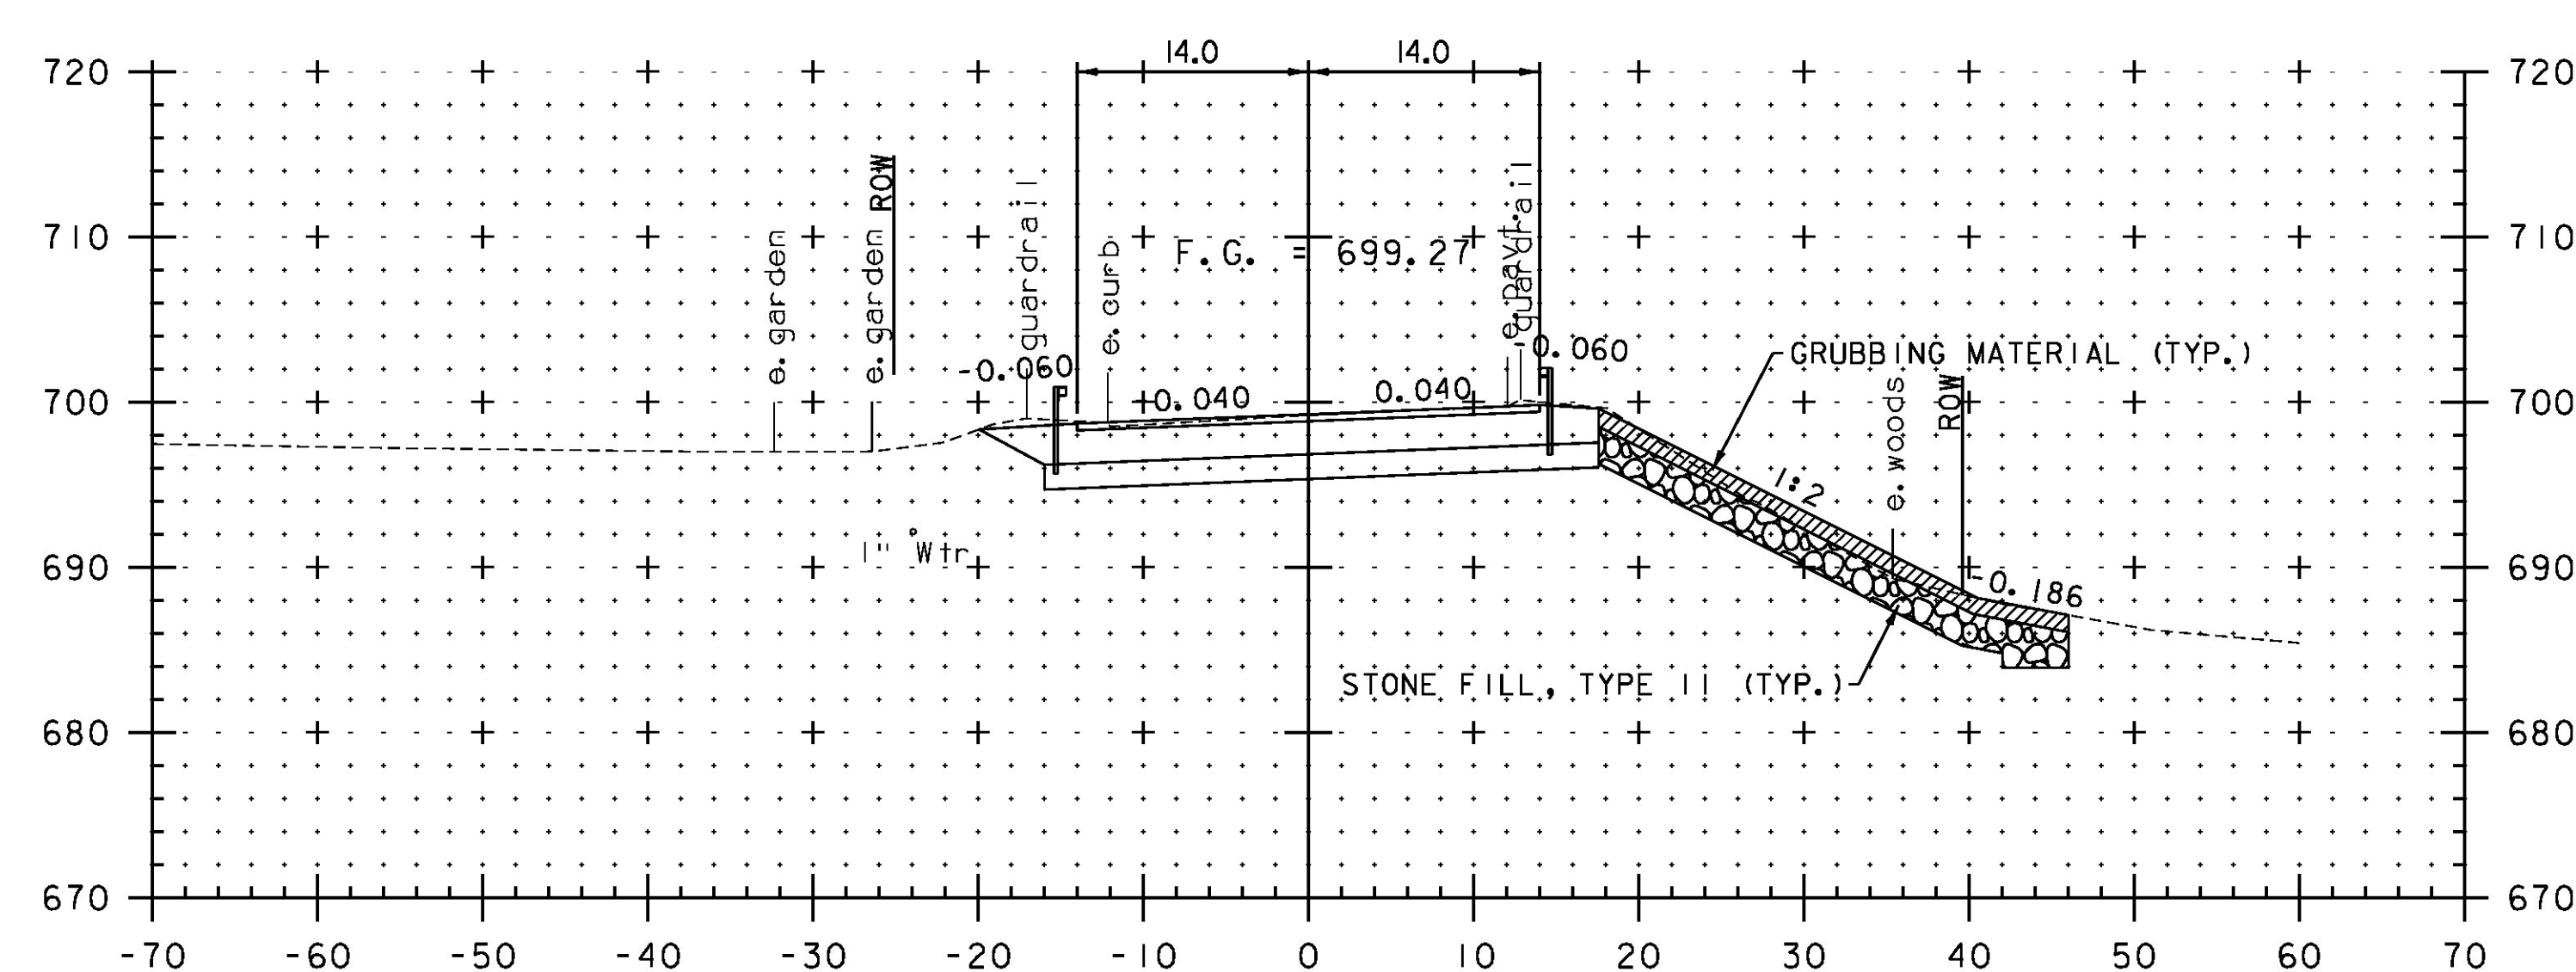


62+00
BEGIN PROJECT

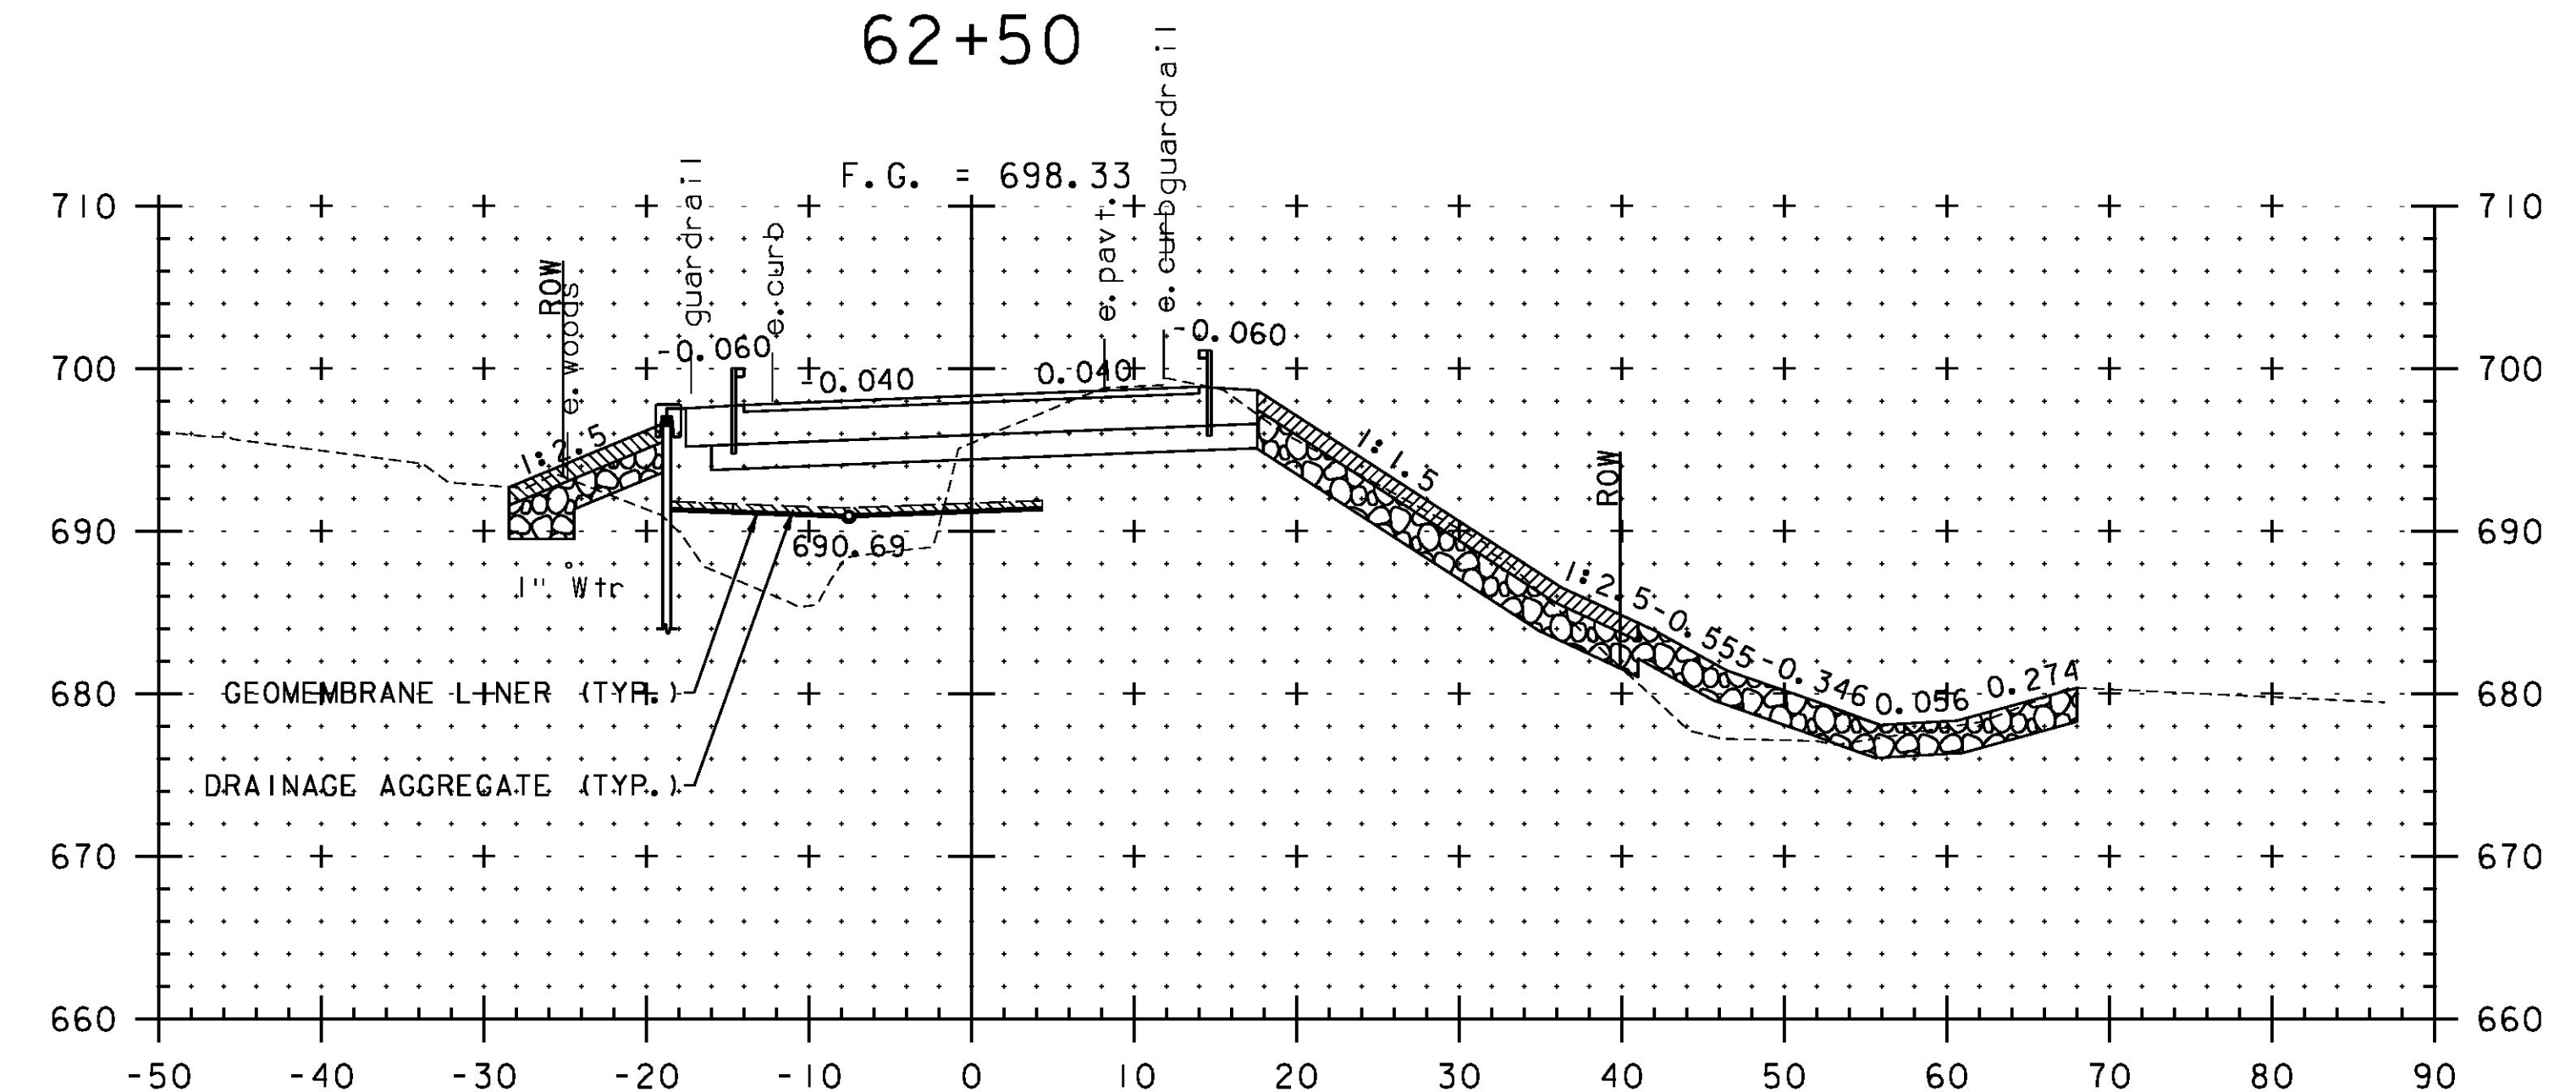

62+25

STA. 62+00 TO STA. 62+50

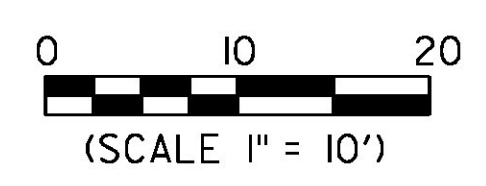

PROJECT NAME:	ST. JOHNSBURY
PROJECT NUMBER:	BF 7000(20)
FILE NAME:	86e048/cos/z86e048xs.dgn
PROJECT LEADER:	J. BYATT
DESIGNED BY:	M. HALEY
VT 2B CROSS SECTIONS:	2
PLOT DATE:	10/26/2016
DRAWN BY:	M. HALEY
CHECKED BY:	P. SHEDD
SHEET:	54 OF 70