


BENCH MARK  
CHISELED SQUARE  
ON BOUNDARY MARKER  
ELEV= 703.27

NOTE  
SEE CROSS SECTIONS FOR FINISHED GRADING.

PROJECT NAME:	ST. JOHNSBURY	PLOT DATE:	10/26/2016
PROJECT NUMBER:	BF 7000(20)	DRAWN BY:	W.GORDON
FILE NAME:	86e048/z86e048bdrerocn.dgn	CHECKED BY:	P.SHEDD
PROJECT LEADER:	J.BYATT	DESIGNED BY:	M.HALEY
EPSC CONSTRUCTION PLAN SHEET			SHEET 64 OF 70

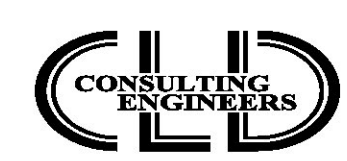

CLD 14-016 MODEL:LOI