


MANUFACTURED BY:
 **Oldcastle™ Precast, Inc.**
 41 ALMEIDA ROAD REHOBOTH, MA 02769
 (508) 336-7600 FAX (508) 336-7707

PROJECT:
 STATE OF VERMONT
 AGENCY OF TRANSPORTATION
 VERMONT ROUTE 2B (URBAN MINOR ARTERIAL) BRIDGE NO. 6
 PROJECT NO. BF 7000(20) - ST. JOHNSBURY
 PRECAST COPING WALLS
 ST. JOHNSBURY, VT

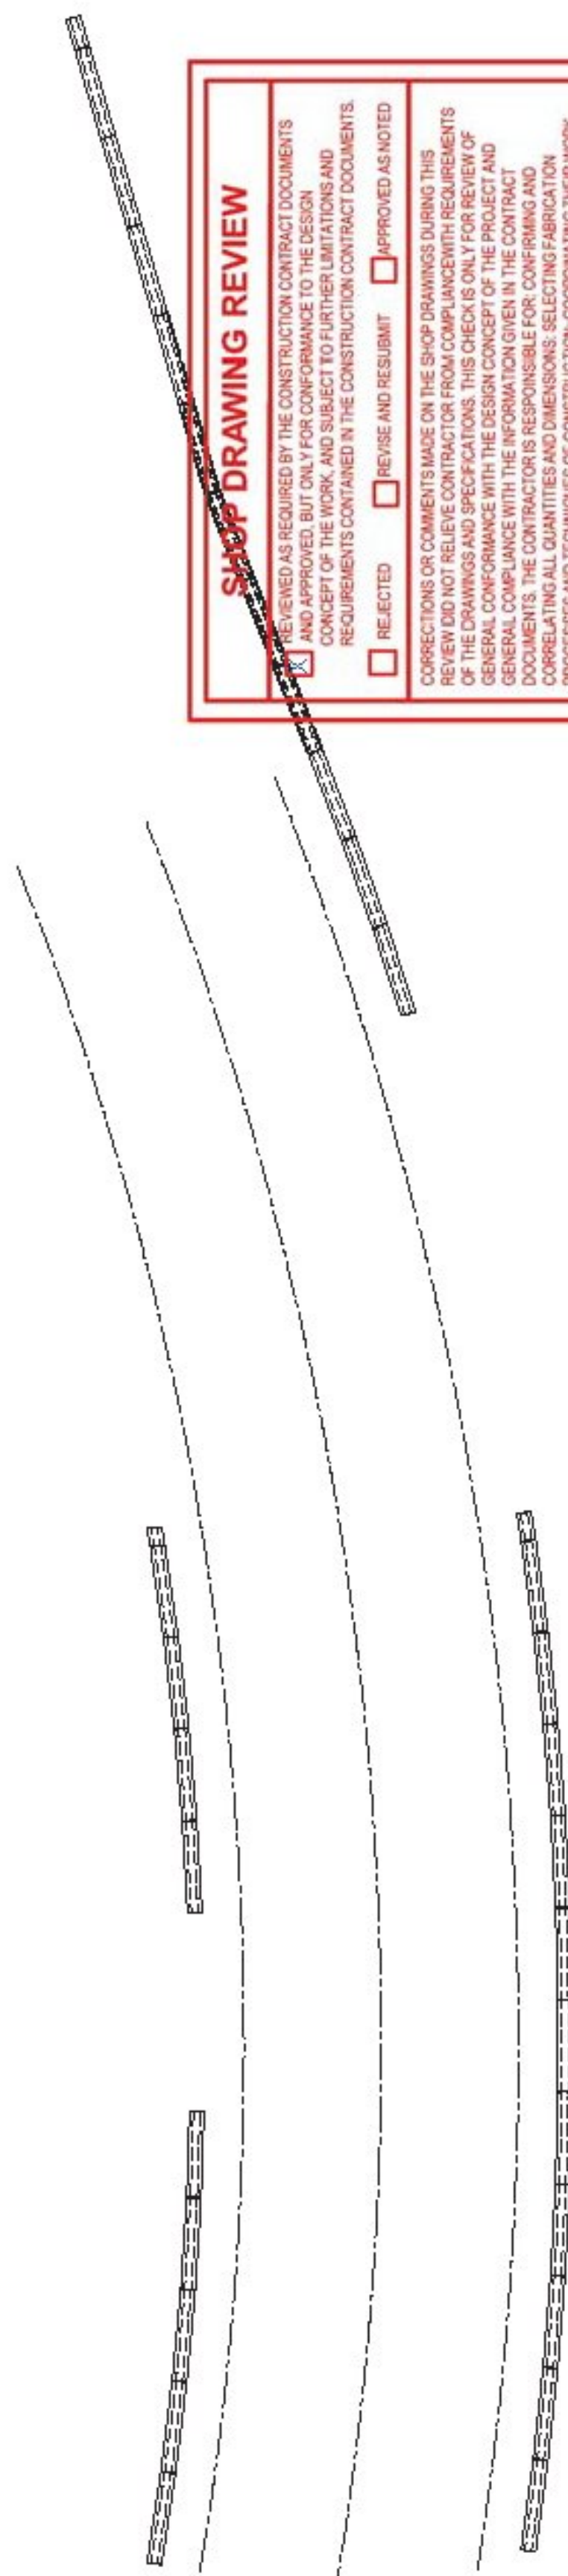

Vermont Agency of Transportation
RECEIVED
 CK'D BY CLD OK'D BY WBP
 April 6, 2017
 RESUBMIT Approved
 BY WPELLETIER DATE 04.07.2017

SHOP DRAWING REVIEW

REVIEWED AS REQUIRED BY THE CONSTRUCTION CONTRACT DOCUMENTS AND APPROVED, BUT ONLY FOR CONFORMANCE TO THE DESIGN CONCEPT OF THE WORK, AND SUBJECT TO FURTHER LIMITATIONS AND REQUIREMENTS CONTAINED IN THE CONSTRUCTION CONTRACT DOCUMENTS.

REJECTED REVISE AND RESUBMIT APPROVED AS NOTED

CORRECTIONS OR COMMENTS MADE ON THE SHOP DRAWINGS DURING THE REVIEW SHALL BE MADE IN RED INK. THE REVIEWER SHALL SIGN AND DATE THE DRAWING TO INDICATE REVIEW. THIS CHECK IS ONLY FOR REVIEW OF GENERAL CONFORMANCE WITH THE INFORMATION GIVEN IN THE CONTRACT DOCUMENTS. IT DOES NOT CONSTITUTE AN ENDORSEMENT OF THE DESIGN OR CORRELATING ALL QUANTITIES AND DIMENSIONS, SELECTING FABRICATION PROCESSES AND TECHNIQUES OF CONSTRUCTION, COORDINATING THEIR WORK WITH THAT OF ALL OTHER TRADES, AND PERFORMING THEIR WORK IN A SAFE AND SATISFACTORY MANNER.

CLD Consulting Engineers
 100 Main Street
 Montpelier, VT 05602
 802-885-5223

Job Number: 14-0116
 Reviewed by: A. GIRALDI
 Date: 4/7/17

DRAWING SCHEDULE

NO.	DESCRIPTION	DATE
1	PRELIMINARY	
2	CONTRACT	
3	CONTRACT	
4	CONTRACT	
5	CONTRACT	
6	CONTRACT	
7	CONTRACT	
8	CONTRACT	
9	CONTRACT	
10	CONTRACT	

Oldcastle Precast
 100 Main Street
 Montpelier, VT 05602
 802-885-5223

STATE OF VERMONT, AGENCY OF TRANSPORTATION
 CONTRACT NO. 14-0116 (R01)

CONTRACT NO.	14-0116
CONTRACT TITLE	VERMONT ROUTE 2B (URBAN MINOR ARTERIAL) BRIDGE NO. 6
PROJECT NO.	BF 7000(20)
DATE	4/7/17
DESIGNED BY	WBP
CHECKED BY	CLD
APPROVED BY	A. GIRALDI
DATE	4/7/17
SCALE	AS SHOWN
SHEET NO.	1 OF 1