

Please see attached e-mail from Big R speaking to the length of coping vs the length of wall


NORTH WALL

DRIVING WALL


SOUTH WALL

GENERAL LAYOUT
SCALE: 1/8" = 1'-0"

Vermont Agency of Transportation
RECEIVED
CK'D BY CLD OK'D BY WBP
April 6, 2017
RESUBMIT n0 Approved
BY WPELLETIER DATE 04/07/2017

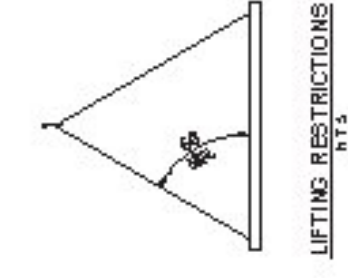

LIFTING RESTRICTIONS
N.T.S.

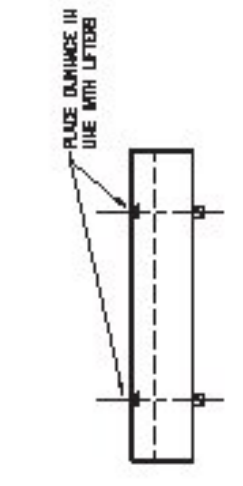

PLACE BLOCKS IN
LINE WITH LIFTING
DURING ELEVATION AS
FOUR POINTS OF CONTACT
N.T.S.

SHOP DRAWING REVIEW

REVIEWED AS REQUIRED BY THE CONSTRUCTION CONTRACT DOCUMENTS AND APPROVED, BUT ONLY FOR CONFORMANCE TO THE DESIGN CONCEPT OF THE WORK, AND SUBJECT TO FURTHER LIMITATIONS AND REQUIREMENTS CONTAINED IN THE CONSTRUCTION CONTRACT DOCUMENTS.

REJECTED REVISE AND RESUBMIT APPROVED AS NOTED

CORRECTIONS OR COMMENTS MADE ON THE SHOP DRAWINGS DURING THIS REVIEW SHALL BE MADE IN THE MARGINS OF THE DRAWINGS AND MUST BE GENERAL CONFORMANCE WITH THE DESIGN CONCEPT OF THE PROJECT AND GENERAL COMPLIANCE WITH THE INFORMATION GIVEN IN THE CONTRACT DOCUMENTS. THE REVIEWER SHALL NOT BE RESPONSIBLE FOR VERIFYING THE CORRELATING ALL QUANTITIES AND DIMENSIONS, SELECTING FABRICATION PROCESSES AND TECHNIQUES OF CONSTRUCTION, COORDINATING THEIR WORK WITH THAT OF ALL OTHER TRADES, AND PERFORMING THEIR WORK IN A SAFE AND SATISFACTORY MANNER.

CLD Consulting Engineers
Mechanicus, NH 03101
603-885-5223

Job Number: 14-0116
Reviewed by: A. GIRALDI
Date: 4/7/17

Orckcastle Precast
1000 ROUTE 100
MIDDLEBURY, VT 05750
TEL: 802-249-1100
FAX: 802-249-1101
WWW.ORKCASTLEPRECAST.COM

STATE OF VERMONT, AGENCY OF TRANSPORTATION
CONTRACT NUMBER: 14-0116

GENERAL LAYOUT	NO.	1
DATE	04/07/2017	
DESIGNED BY	WBP	
CHECKED BY	CLD	
APPROVED BY	WBP	
DATE	04/07/2017	
SCALE	1/8" = 1'-0"	
TOTAL SHEETS	1	1 OF 1