

MINIMUM 2" MAX. CLEARANCE FROM ALL EXTERIOR SURFACES UNLESS NOTED OTHERWISE.

BAR CHART (EPOXY COATED)

ITEM	QTY/PC	UNIT	SIZE	TYPE	LENGTH	AMP
4001	5	S	#4	D	7'-0"	510000
4002	4	S	#4	SHR.	7'-1 1/2"	610000

BILL OF MATERIALS


ITEM	QTY/PC	TOTAL	DESCRIPTION	AMP
1	2	2	NO. 40001 4" SQUARE CORNER	400000
2	10	10	NO. 40002 4" SQUARE CORNER	500000

Vermont Agency of Transportation
RECEIVED
 CK'D BY CLD OK'D BY WBP
 April 6, 2017
 RESUBMIT nO Approved
 BY WPELLETIER DATE 04.07.2017

DESIGN NOTES
 1. CONCRETE SHALL BE PLACED IN 12" LAYERS WITH 12" MAX. SPACING BETWEEN LAYERS.
 2. ALL SURFACES TO BE FINISHED TO THE FINISH SURFACE.
 3. ALL SURFACES TO BE FINISHED TO THE FINISH SURFACE.
 4. ALL SURFACES TO BE FINISHED TO THE FINISH SURFACE.

BAR WEIGHT TOTALS

ITEM	QTY	WEIGHT
1	2	2.27
2	10	22.7

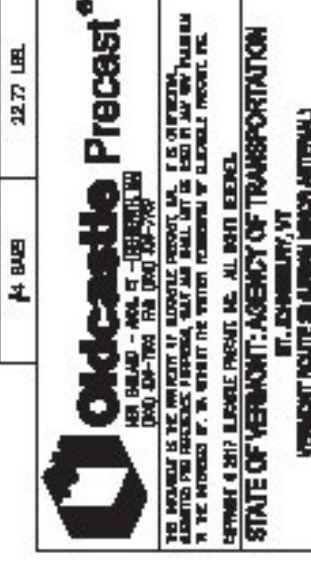

CONCRETE WALL TYPE CORNER PRECAST DETAIL #

ITEM	QTY	WEIGHT	UNIT
1	2	2.27	LB
2	10	22.7	LB



SHOP DRAWING REVIEW

REVIEWED AS REQUIRED BY THE CONSTRUCTION CONTRACT DOCUMENTS AND APPROVED, BUT ONLY FOR CONFORMANCE TO THE DESIGN REQUIREMENTS CONTAINED IN THE CONSTRUCTION CONTRACT DOCUMENTS.

REJECTED REVISE AND RESUBMIT APPROVED AS NOTED

CORRECTIONS OR COMMENTS MADE ON THE SHOP DRAWINGS DURING THIS REVIEW DO NOT RELIEVE CONTRACTOR FROM COMPLIANCE WITH REQUIREMENTS OF THE DRAWINGS AND SPECIFICATIONS. THIS CHECK IS ONLY FOR REVIEW OF GENERAL COMPLIANCE WITH REQUIREMENTS OF THE DRAWINGS AND SPECIFICATIONS. CONTRACTOR IS RESPONSIBLE FOR CONFIRMING AND CORRECTING ALL QUANTITIES AND DIMENSIONS. SELECTING FABRICATION WITH THAT OF ALL OTHER TRADES AND PERFORMING THEIR WORK IN A SAFE AND SATISFACTORY MANNER.

CD
 Job Number: 14-01115
 Reviewed by: A. GERALDI
 Date: 4/7/17

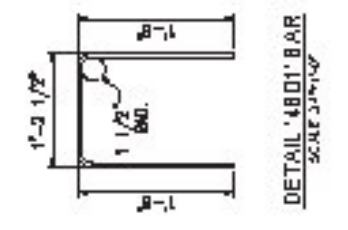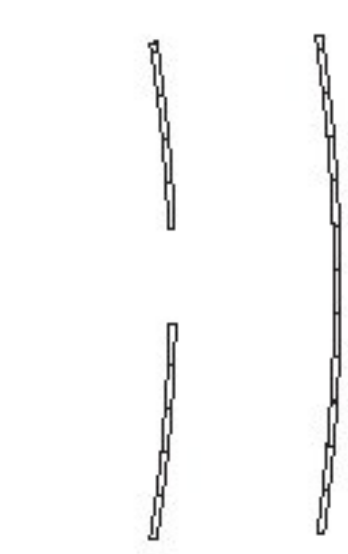

CW-5
 (1) REQD.