



PROFILE VT RT 14

NOTE: GRADES SHOWN TO THE NEAREST HUNDRETH ARE EXISTING GROUND ALONG CENTERLINE.


GRADES SHOWN TO THE NEAREST THOUSANDTH ARE FINISH GRADE ALONG CENTERLINE.

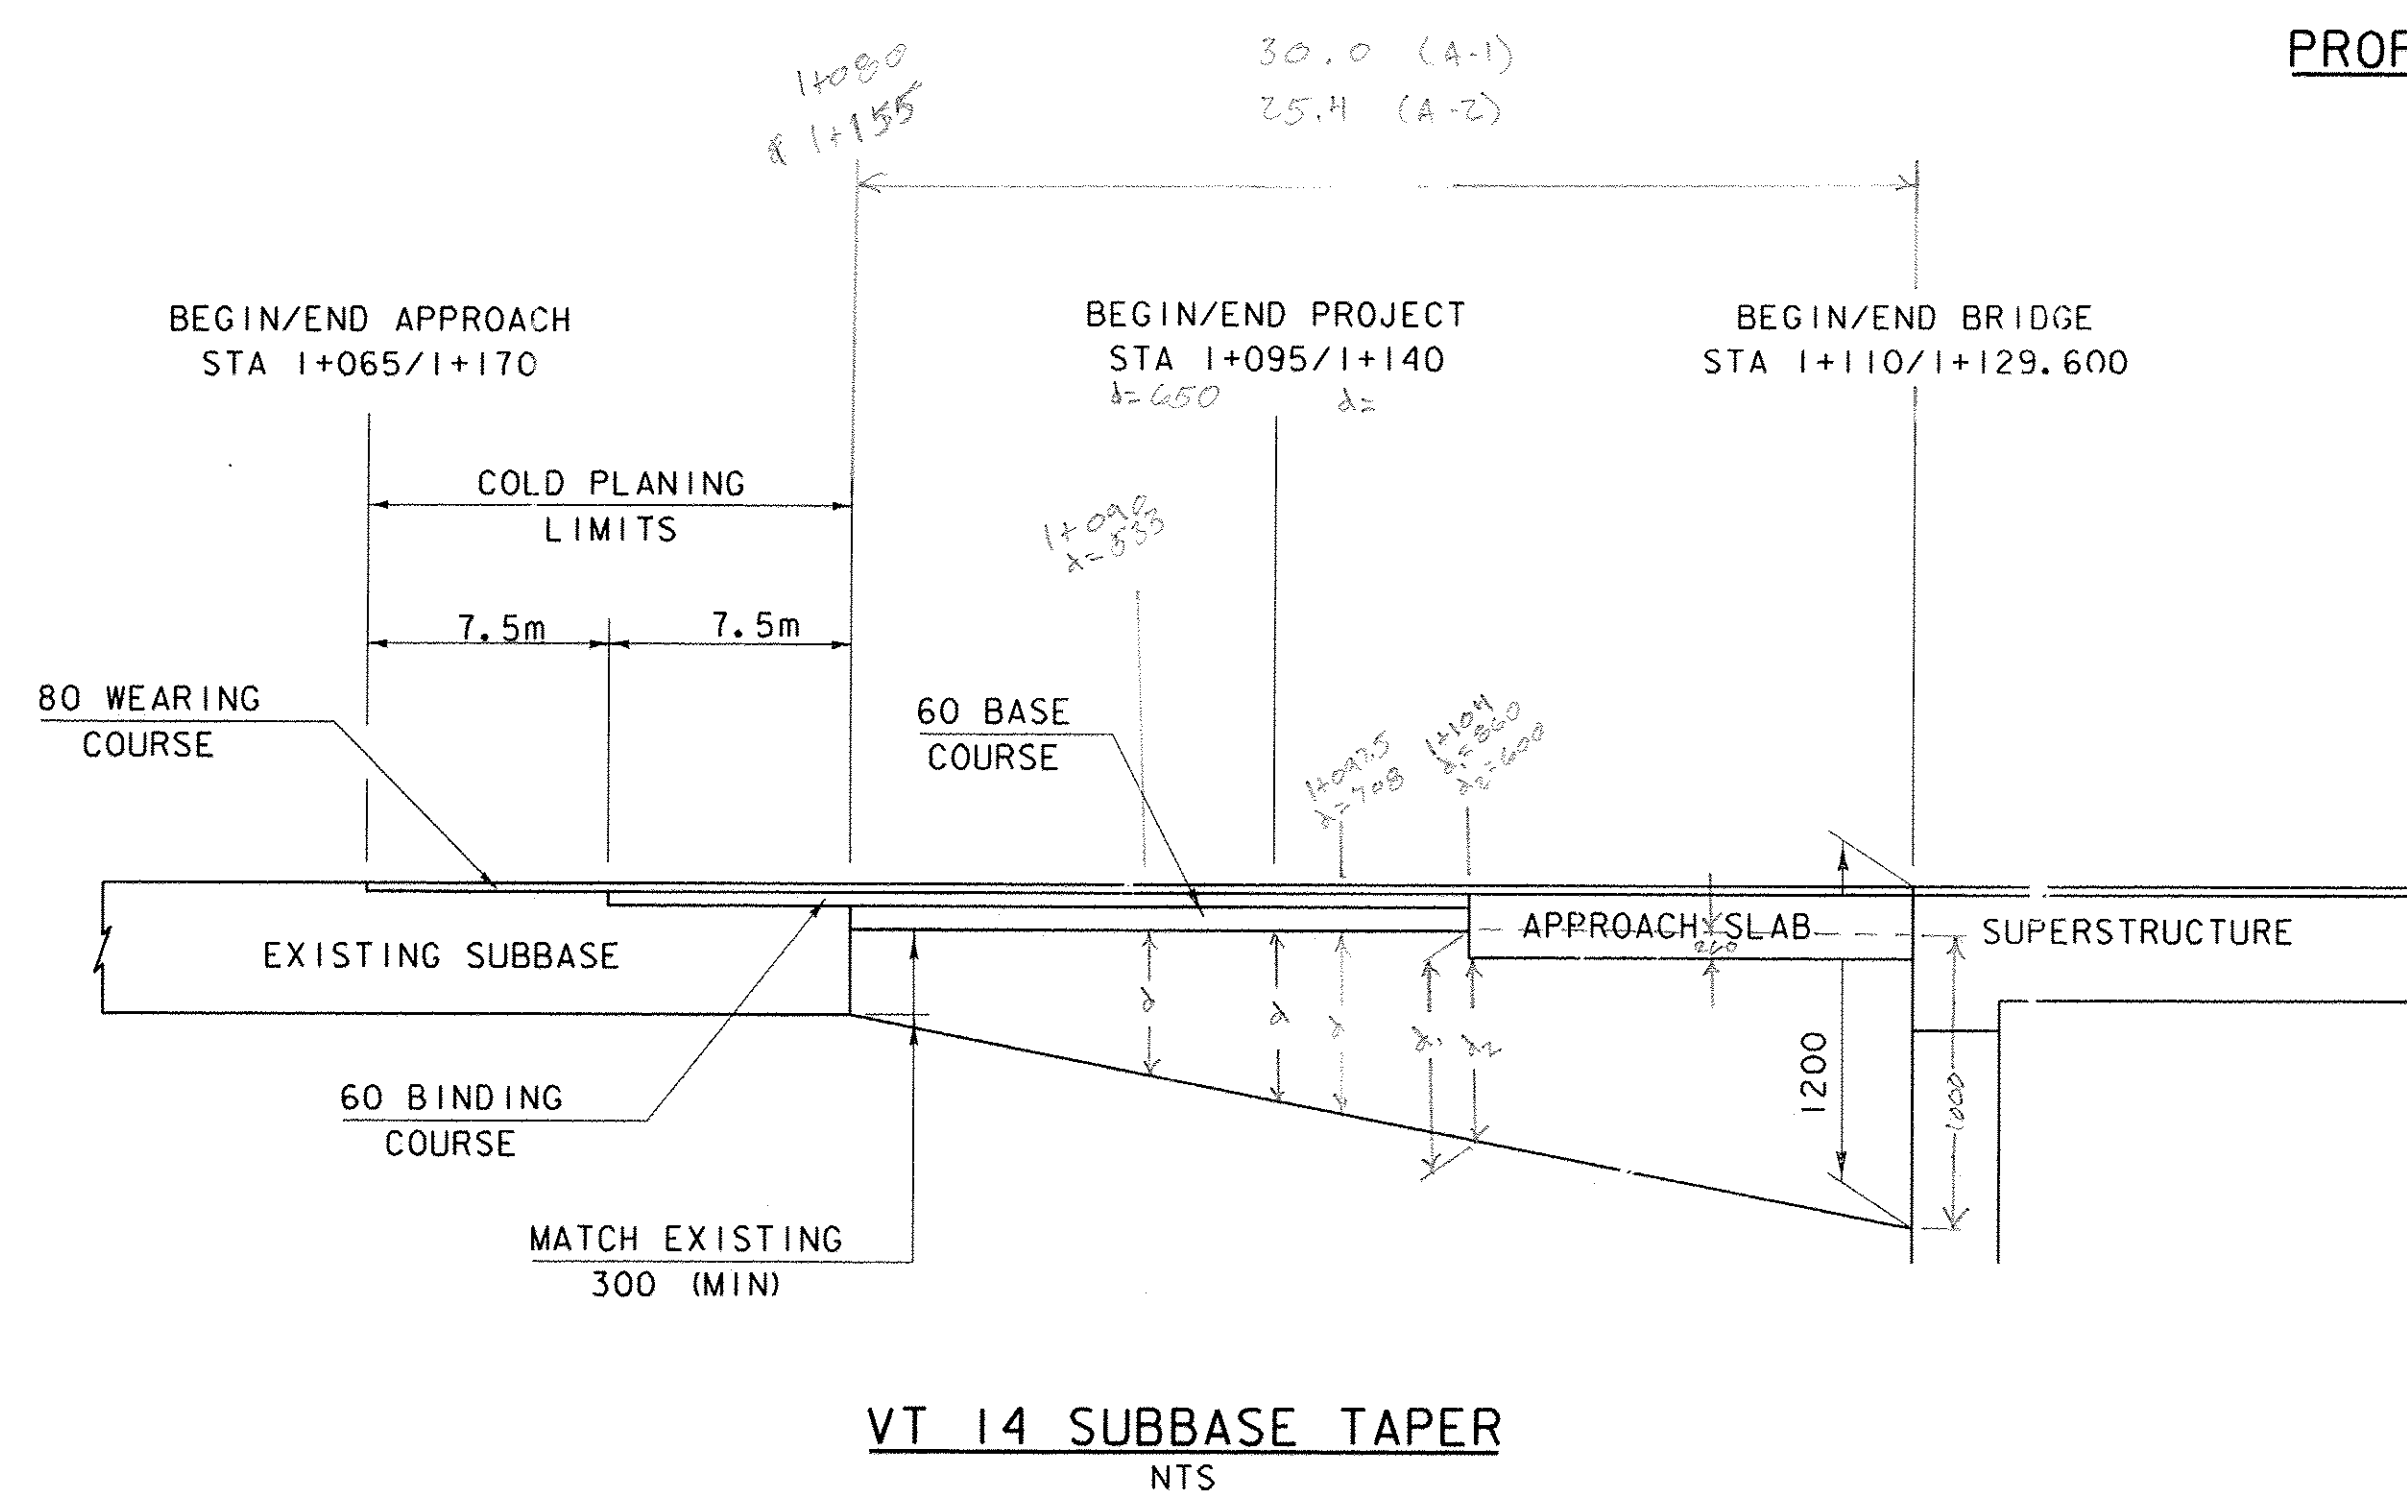

VT 14 SUBBASE TAPER
NTS

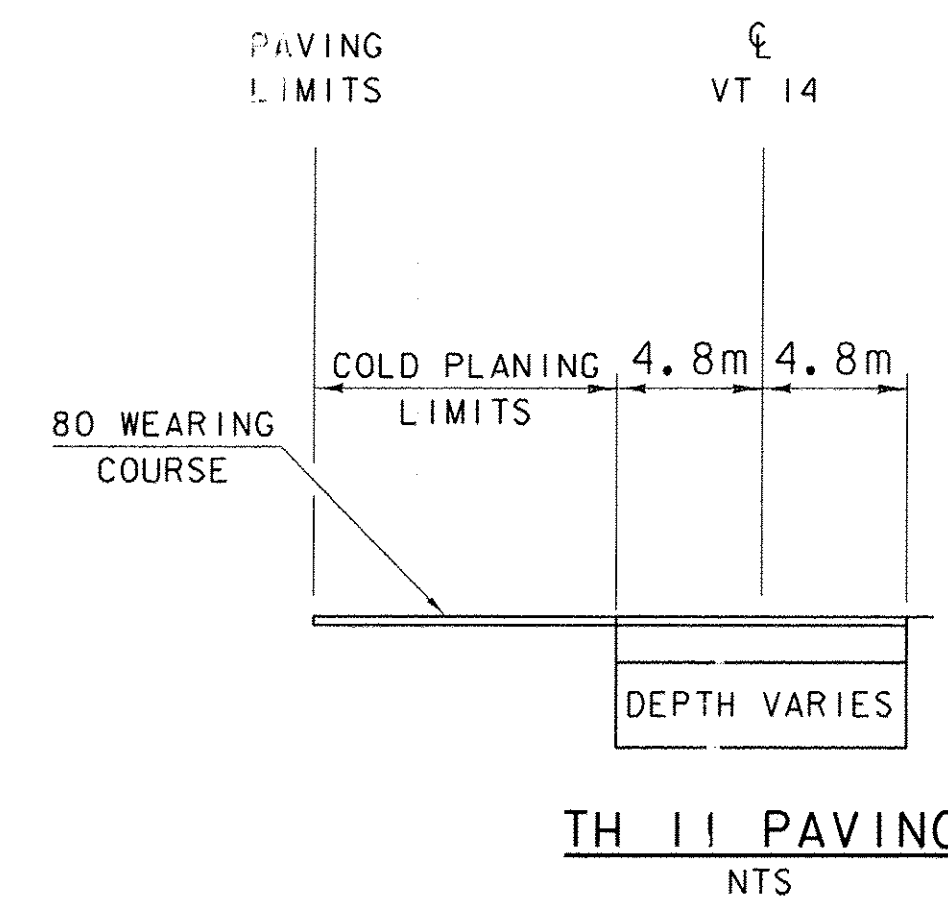

TH II PAVING
NTS

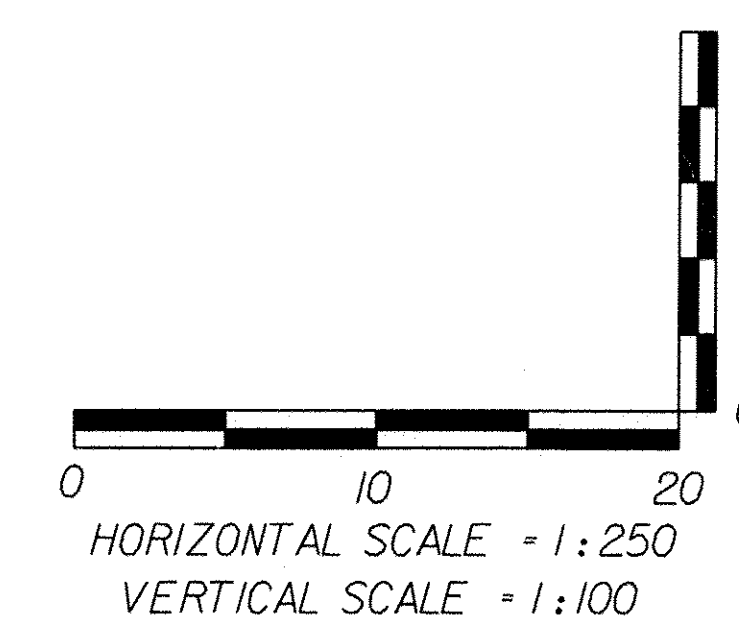

PROJECT NAME: EAST MONTPELIER	PLOT DATE: 18-AUG-2010
PROJECT NUMBER: BRF 037-2(8)	DRAWN BY: L.J.STONE
FILE NAME: se054pro.dgn	DESIGNED BY: L.J.STONE
PROJECT LEADER: C.P.WILLIAMS	CHECKED BY: H.J.SALLS
PROFILE VT RT 14	SHEET 11 OF 63