


NOTES:

NF = NEAR FACE
 FF = FAR FACE
 EF = EACH FACE
 ▲ = CUT TO FIT IN FIELD

80 CLEAR UNLESS OTHERWISE SPECIFIED ON THE PLANS

ALL LAPS 660 UNLESS OTHERWISE NOTED.

ALL REINFORCING STEEL SHALL BE EPOXY COATED.

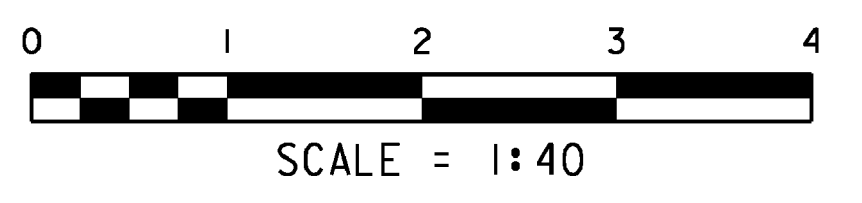

REV. NO.	DATE	BY	DESCRIPTION
▲	2/18/2011	VAOT	MODIFIED RIGHT WIDTH OF APPROACH SLABS IN ORDER TO ACCOMMODATE SIDEWALK.

PROJECT: EAST MONTEPELIER	PROJECT NO. # BRF 037-2 (8)
DESIGN FILE NAME: 86e054\Structures\SidewalkChange\ApproachSlab.dgn	PLOT DATE: 23-FEB-2011
IPARM FILE NAME: se054aps2.i	DESIGNED BY: L. J. STONE
SQUAD LEADER: C.P. WILLIAMS	CHECKED BY: H. I. SALLS
APPROACH SLAB DETAILS SHEET	SHEET: 27A OF 63