

**ABUTMENT #2 FOOTING REINFORCEMENT**


SCALE 1:40

**NOTE:**

- NF = NEAR FACE
- FF = FAR FACE
- EF = EACH FACE
- ▲ = CUT TO FIT IN FIELD

80 CLR. UNLESS OTHERWISE SPECIFIED ON THE PLANS.

ALL LAPS ARE 660 MIN UNLESS OTHERWISE SPECIFIED ON THE PLANS.

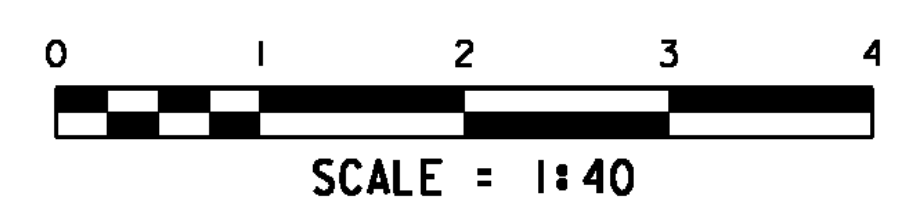

PROJECT: EAST MONTPELIER	PROJECT NO.: BRF 037-2 (8)
DESIGN FILE NAME: 86e054/Structures/se054sub.dgn	PLOT DATE: 18-AUG-2010
IPARM FILE NAME: se054ftg2.i	DRAWN BY: D.D. BEARD
DESIGNED BY: L.J. STONE	SQUAD LEADER: C.P. WILLIAMS
SQUAD LEADER: C.P. WILLIAMS	CHECKED BY: H.I. SALLS
ABUTMENT 2 FOOTING REINFORCEMENT	SHEET: 32 OF 63