


WINGWALL #4 TYPICAL SECTION
SCALE = 1:20

SEE REVISED SHEET 34A

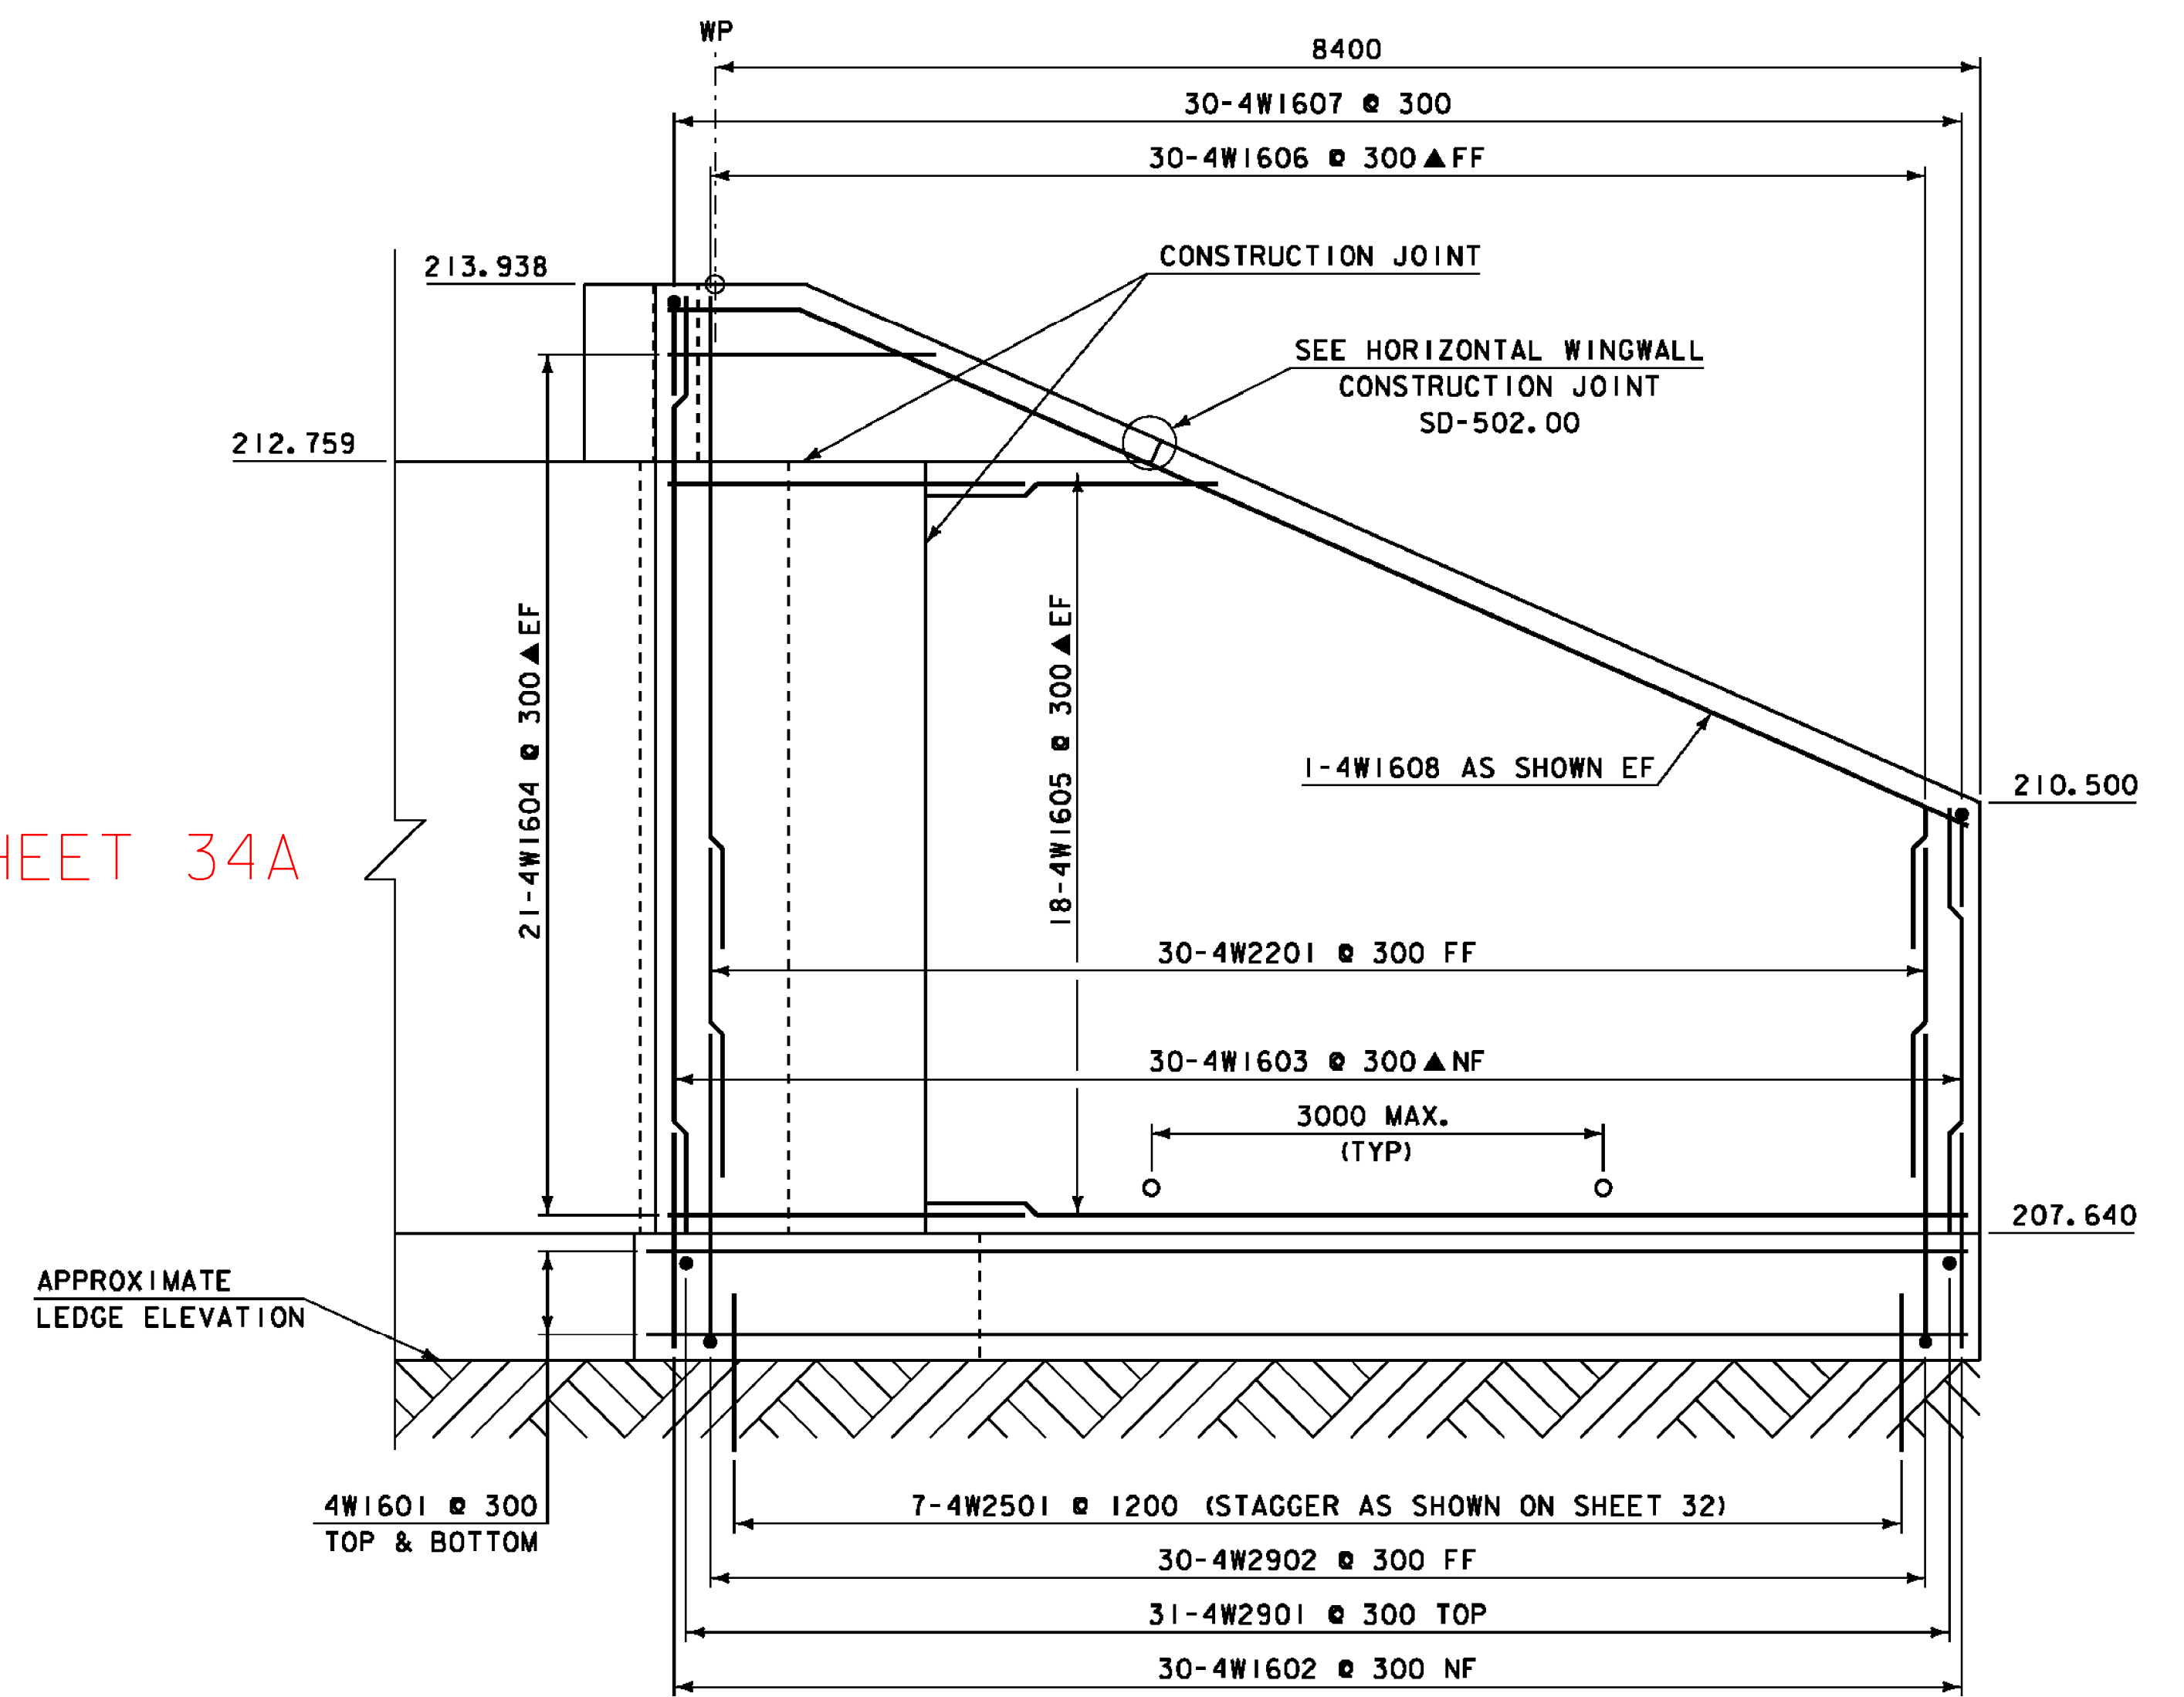


WINGWALL #4 ELEVATION
SCALE = 1:40

NOTE:

- NF = NEAR FACE
- FF = FAR FACE
- EF = EACH FACE
- ▲ = CUT TO FIT IN FIELD

80 CLR. UNLESS OTHERWISE SPECIFIED ON THE PLANS.

ALL LAPS ARE 660 MIN UNLESS OTHERWISE SPECIFIED ON THE PLANS.

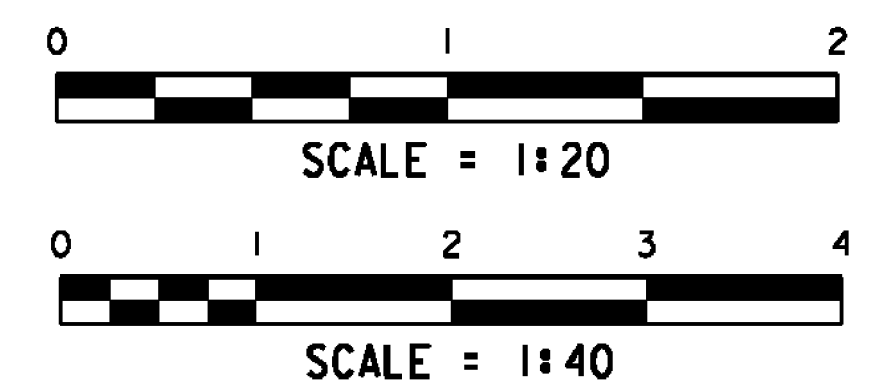

PROJECT: EAST MONTEPELIER	PROJECT NO. # BRF 037-2 (8)
DESIGN FILE NAME: 86e054/Structures/se054sub.dgn	PLOT DATE: 18-AUG-2010
IPARM FILE NAME: se054ww3x4.i	DRAWN BY: D.D. BEARD
DESIGNED BY: L.J. STONE	CHECKED BY: H.I. SALLS
SQUAD LEADER: C.P. WILLIAMS	WINGWALL 4 DETAILS
	SHEET: 34 OF 63