


WINGWALL #4 TYPICAL SECTION
SCALE = 1:20

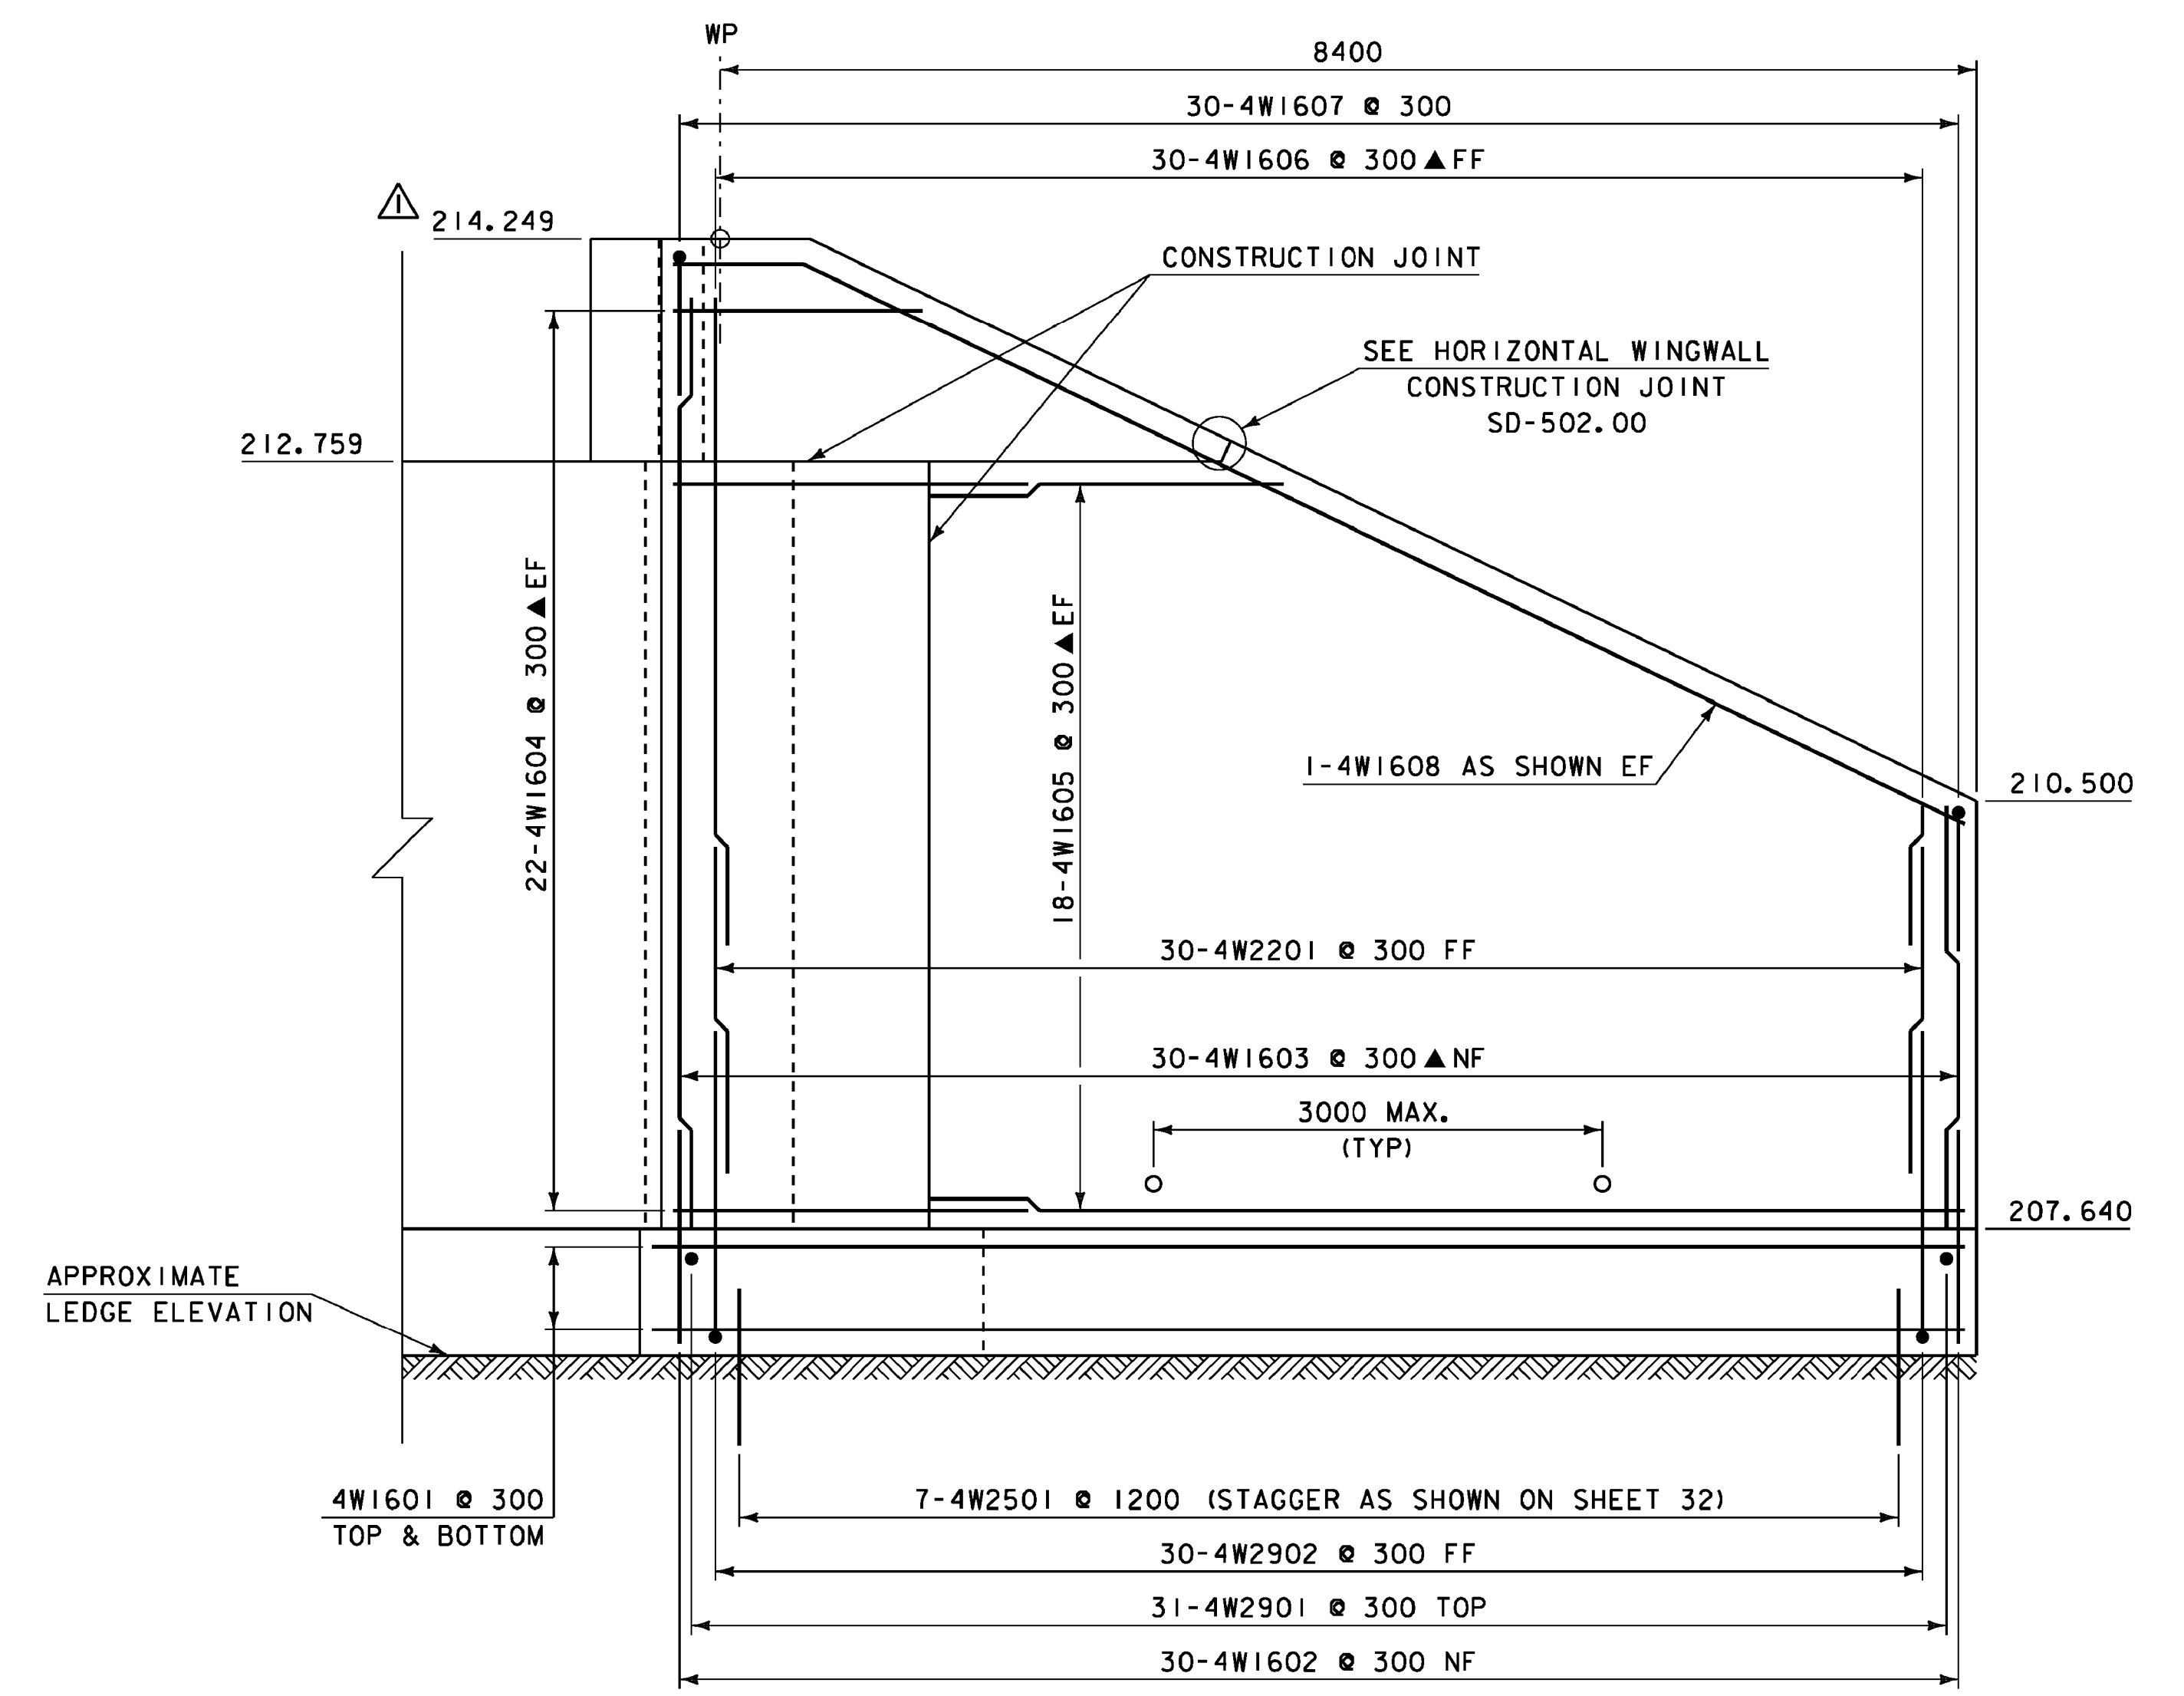

WINGWALL #4 ELEVATION
SCALE = 1:40

NOTE:


- NF = NEAR FACE
- FF = FAR FACE
- EF = EACH FACE
- ▲ = CUT TO FIT IN FIELD

80 CLR. UNLESS OTHERWISE SPECIFIED ON THE PLANS.

ALL LAPS ARE 660 MIN UNLESS OTHERWISE SPECIFIED ON THE PLANS.



SCALE = 1:20

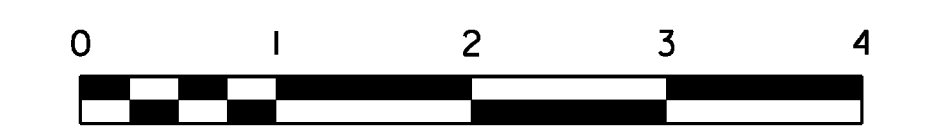

SCALE = 1:40

REV. NO.	DATE	BY	DESCRIPTION
△	2/18/2011	VAOT	MODIFIED ELEVATION OF WINGWALL.

PROJECT: EAST MONTEPELIER	PROJECT NO. # BRF 037-2 (8)
DESIGN FILE NAME: 86e054\Structures\SidewalkChange\Abutment.dgn	PLOT DATE: 23-FEB-2011
IPARM FILE NAME: se054ww3x4.i	DRAWN BY: D. D. BEARD
DESIGNED BY: L. J. STONE	CHECKED BY: H. I. SALLS
SQUAD LEADER: C. P. WILLIAMS	WINGWALL 4 DETAILS
	SHEET: 34A OF 63