


NOTE: SEE SHEET 20 FOR GUARD RAIL RADI I

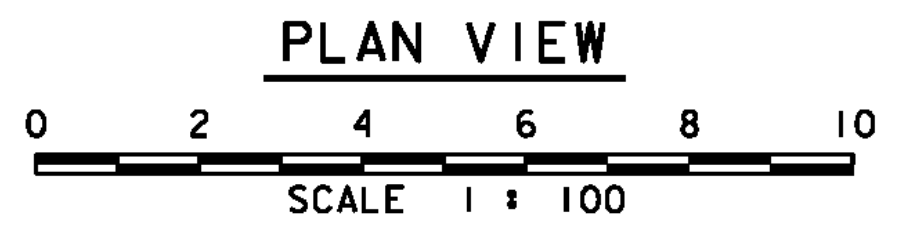

<b>DATUM</b>	
VERTICAL	USGS
HORIZONTAL	ASSUMED

PROJECT: <b>EAST MONTPELIER</b>	PROJECT NO. : <b>BRF 037-2 (8)</b>
DESIGN FILE NAME: 86e054/structures/se054rail.dgn	PLOT DATE: 18-AUG-2010
IPARM FILE NAME: se054railay.i	SURVEY DATE: 3/93
SURVEYED BY: R. MOREAU	DRAWN BY: D. D. BEARD
SQUAD LEADER: C. P. WILLIAMS	SHEET: 35 OF 63
RAILING LAYOUT	