



ROGERS,  
DAVID E.

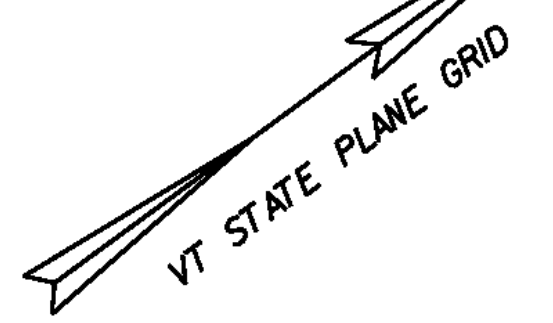

BEGIN R.O.W. PROJECT  
BRF 037-2(8)  
STA. 1+058.93 7.54m  
(24.75')RT.

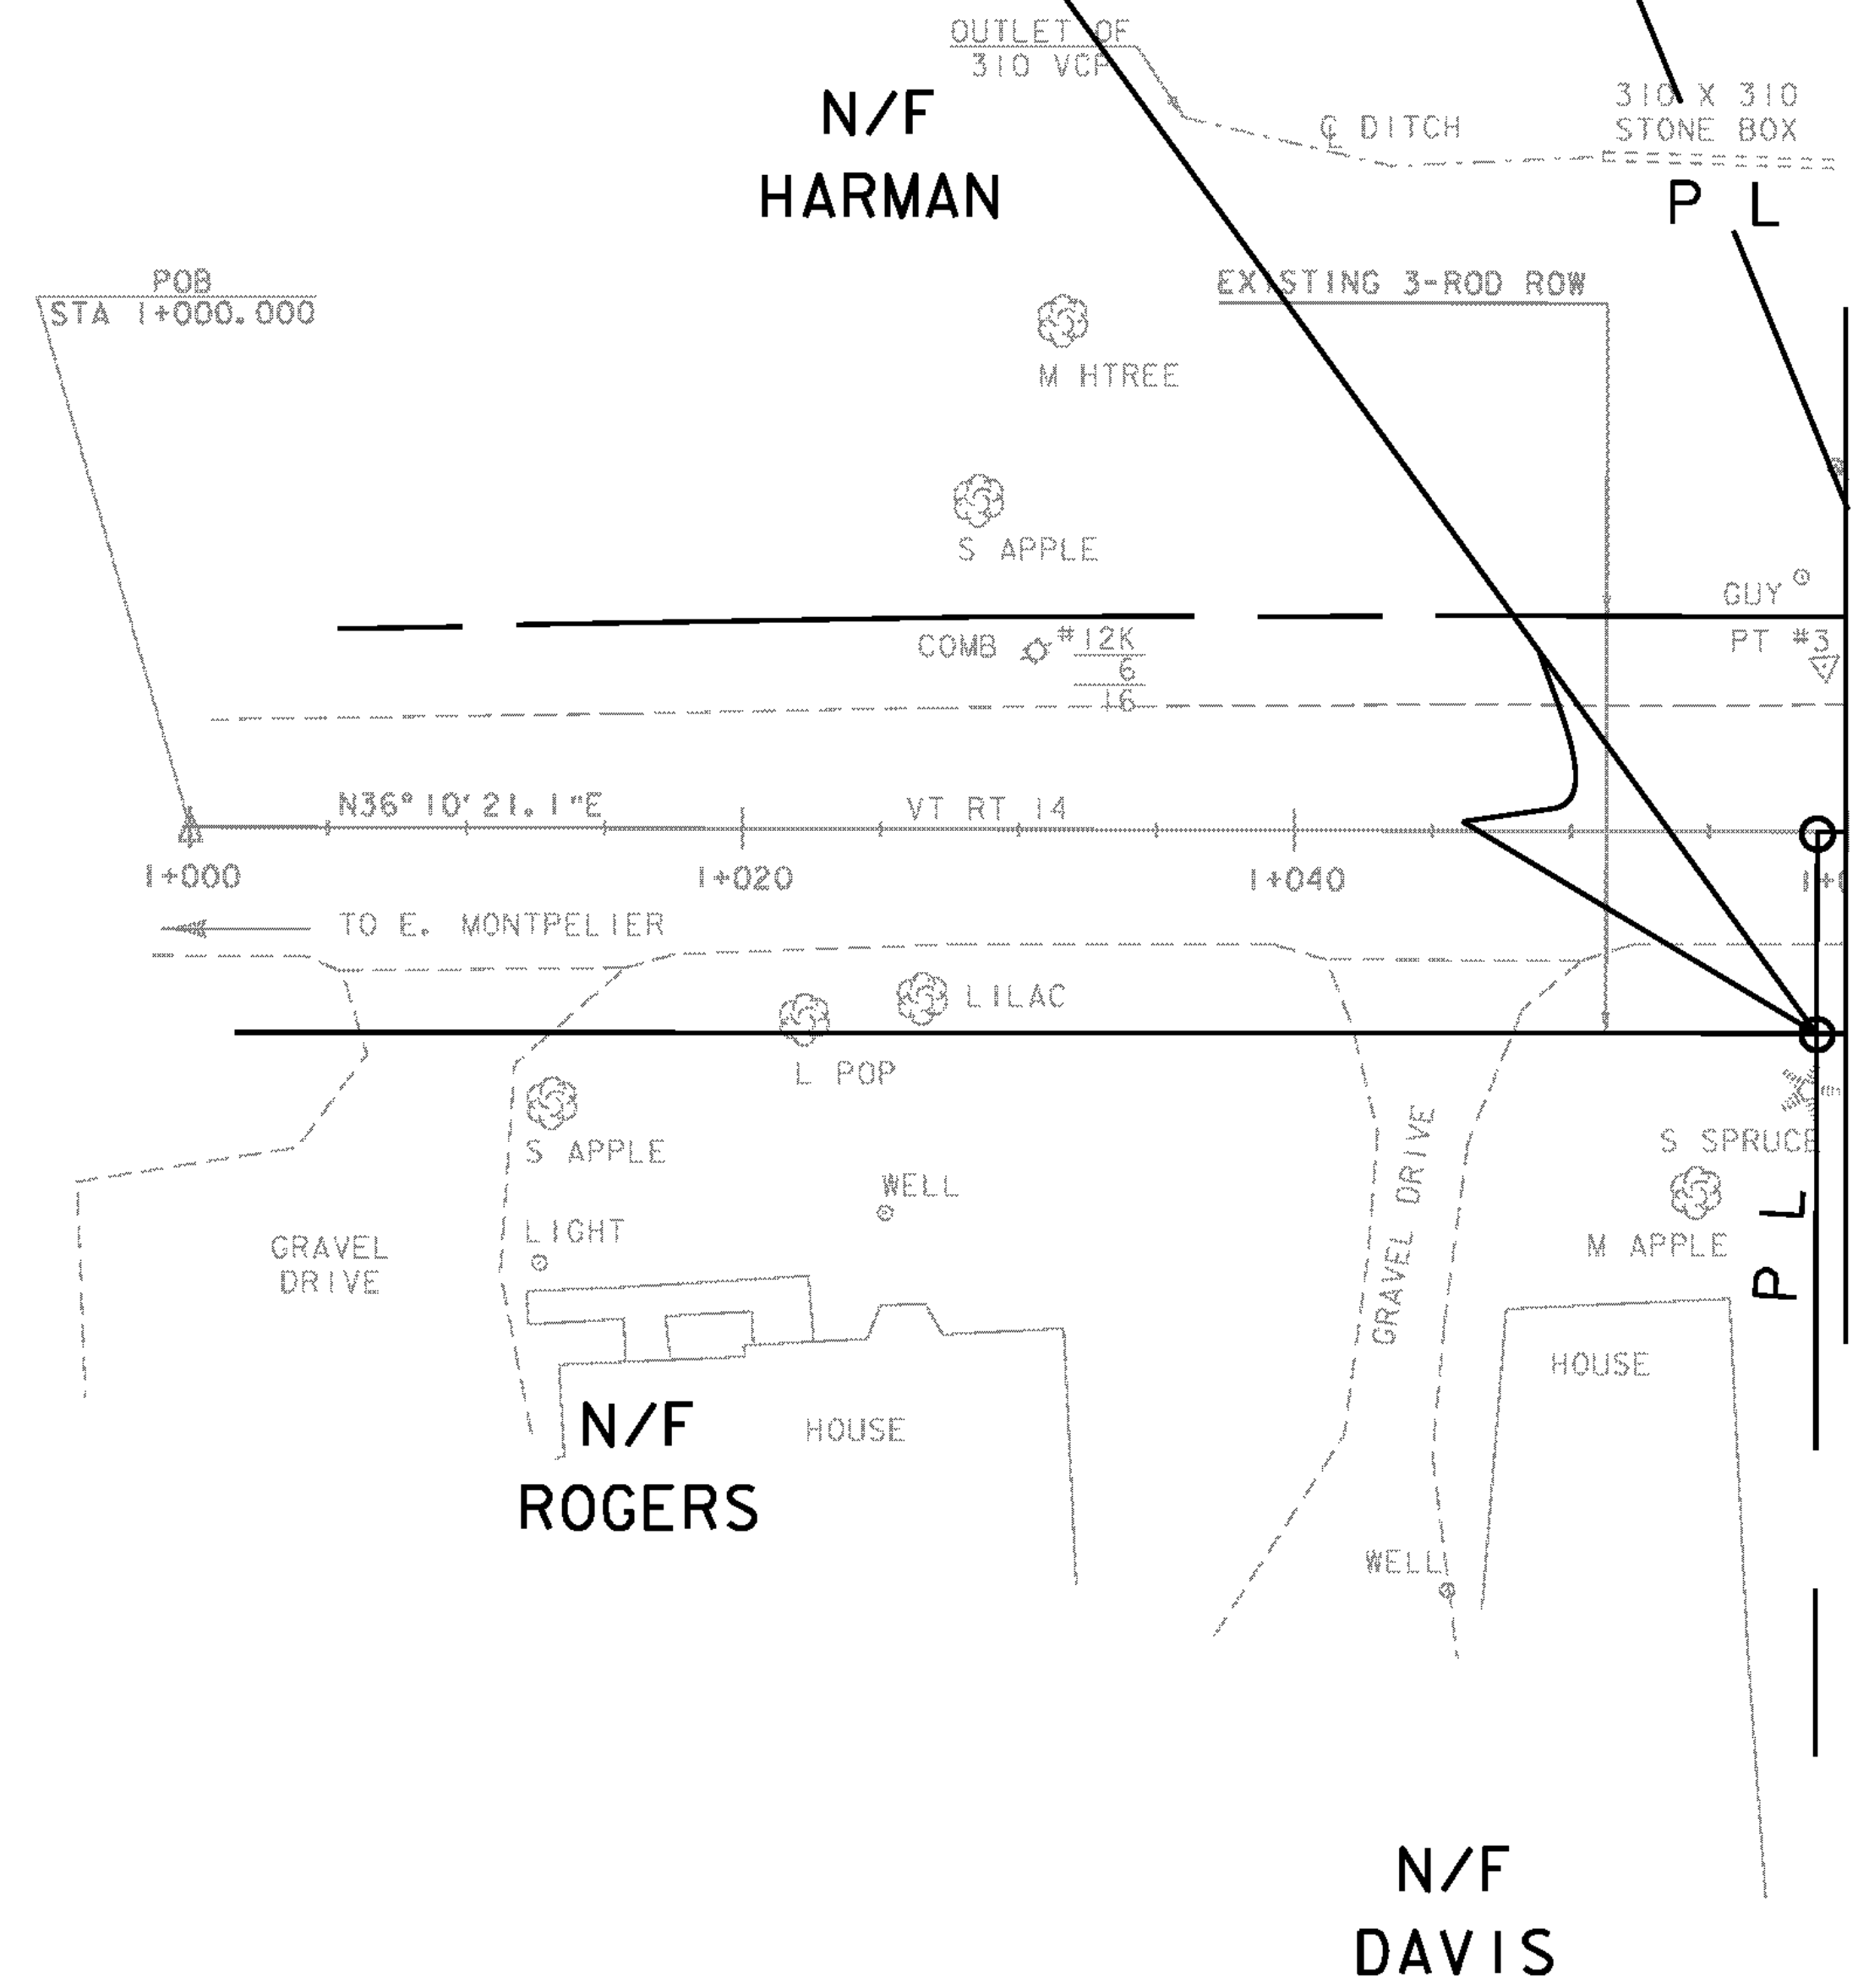

LINES SHOWN ON THIS PLAN AS EXISTING  
PROPERTY LINES P/L ARE BELIEVED TO  
BE ACCURATE BUT SHOULD NOT BE RELIED  
UPON FOR PURPOSES UNRELATED TO THE  
STATE OF VERMONT'S ACQUISITION OF LAND  
AND RIGHTS FOR THIS PROJECT.

<b>DATUM</b>	
VERTICAL	USGS
HORIZONTAL	ASSUMED

**FOR R.O.W.  
USE ONLY**

PROJECT: EAST MONTPELIER	PROJECT NO. : BRF 037-2 (8)
DESIGN FILE NAME: re054zzz.dgn	PLOT DATE: 18-AUG-2010
IPARM FILE NAME: se054row1	SURVEY DATE: 3/93
SURVEYED BY: R. MOREAU	DRAWN BY: L. J. STONE
SQUAD LEADER: C. P. WILLIAMS	SHEET: 40 OF 63
ROW SHEET 13 OF 14	