


NOTE:
 ANY TEMPORARY FILLS BELOW OHW SHALL BE PLACED ON GEOTEXTILE FABRIC. SEE GENERAL NOTES FOR ADDITIONAL DETAILS.

OHW IMPACTS	
TEMP. CONSTRUCTION AREA	61 SM (657 SF)
PERM. CONSTRUCTION AREA	37 SM (398 SF)

TOTAL AREA OF EARTH DISTURBANCE = 2211.5 SM (23805 SF)
 0.22 HECTARES (0.55 ACRES)

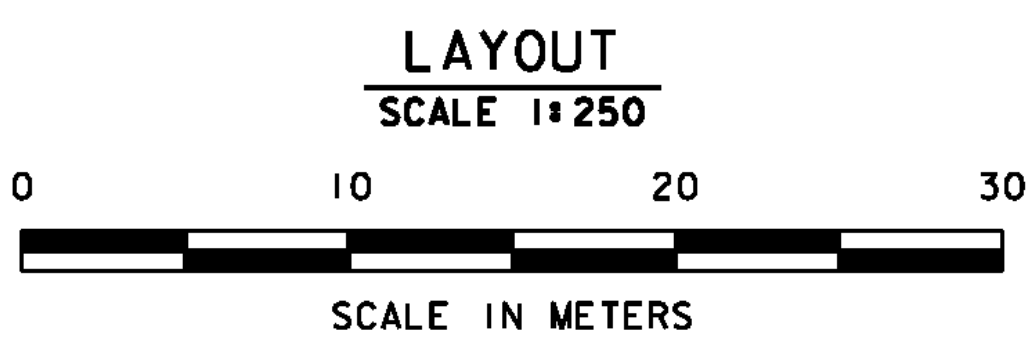

PROJECT: EAST MONTPELIER	PROJECT NO. : BRF 037-2 (8)
DESIGN FILE NAME: s86e054/Str/environmental.dgn	PLOT DATE: 18-AUG-2010
IPARM FILE NAME: se054env.i	SURVEY DATE: 3/93
SURVEYED BY: R. MOREAU	DRAWN BY: M. FESSEL
SQUAD LEADER: C. P. WILLIAMS	SHEET: 44 OF 63
ENVIRONMENTAL IMPACTS	