
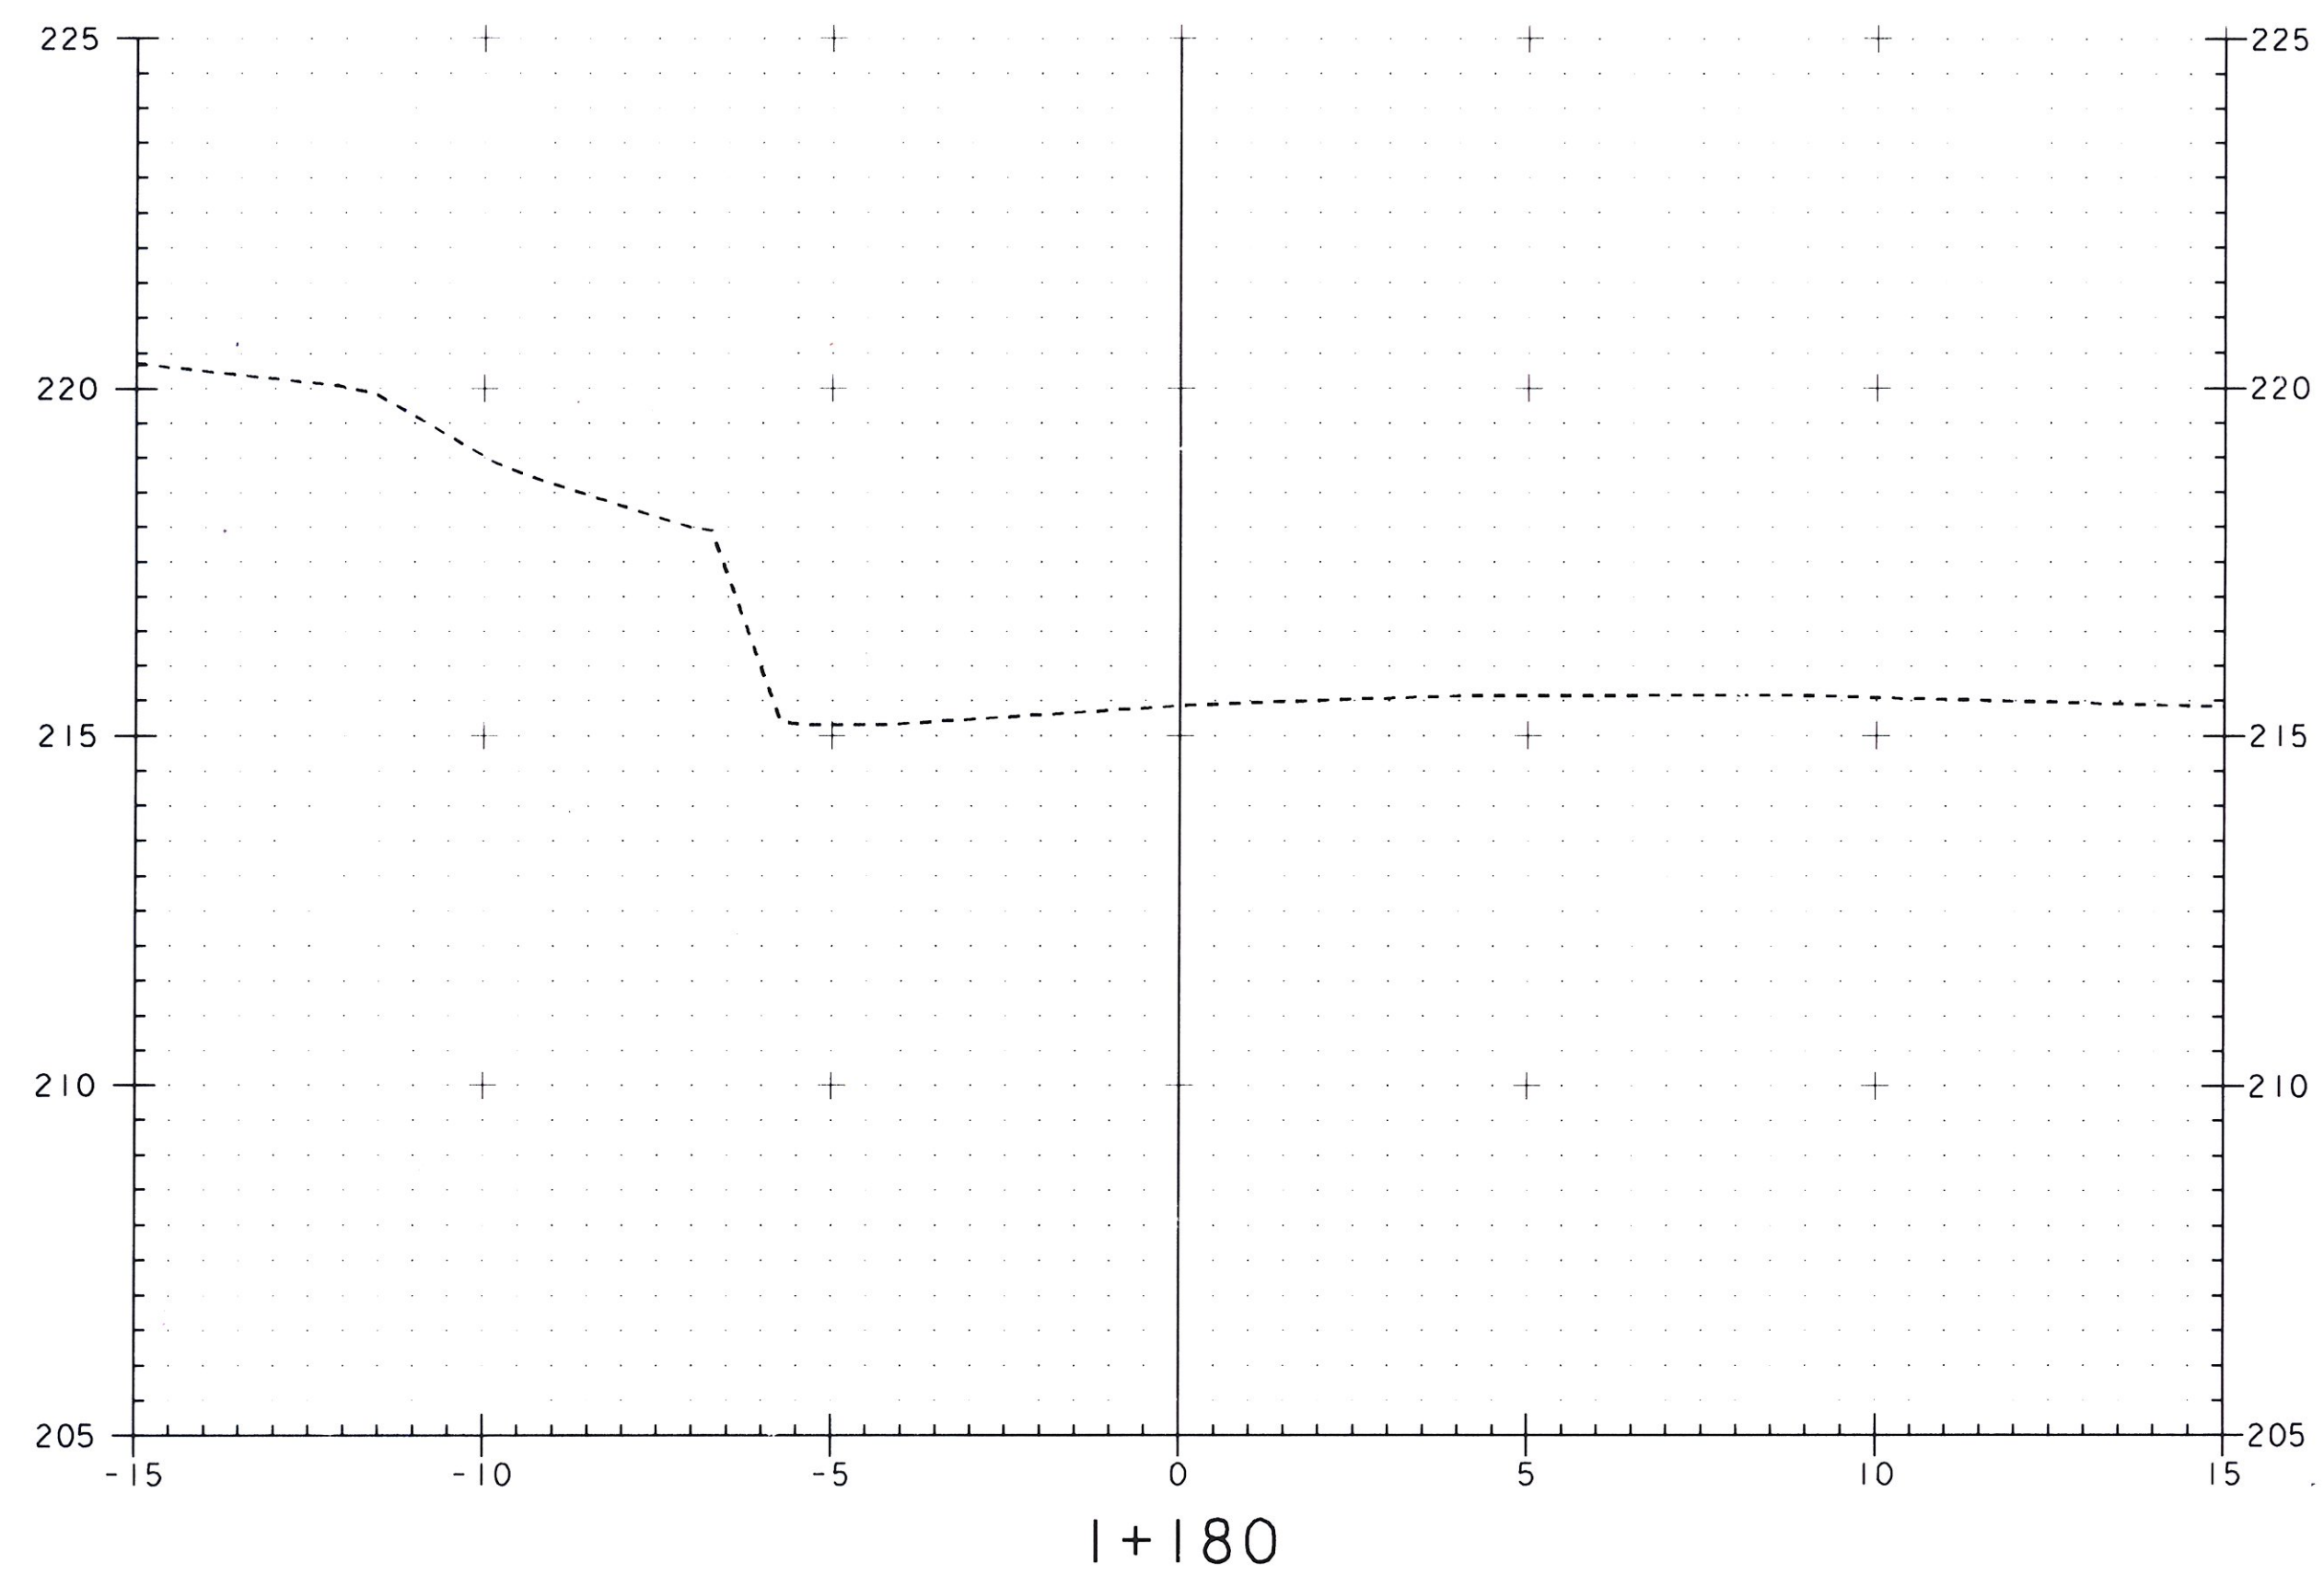


Item 203.15, Common Excavation

Station (Butt)	Distance	Area	Volume
1+080	10.	4.12.	55.80.
1+090	5.	7.04.	35.85.
1+095	5.	7.30.	40.80.
1+100	5.	9.02.	52.53 ✓
1+105	5.	<del>11.99</del> 11.50	<del>54.45</del> 55.68 ✓
1+110	5.	10.28.	—
Bridge			
1+121.4	0.4.	13.39.	5.70.
1+130	5.	15.10.	66.15.
1+135	5.	11.36.	51.03.
1+140	5.	9.05.	41.68.
1+145	5.	7.62.	34.10.
1+150	5.	6.02.	26.30.
1+155	5.	4.50.	—

463.16 m<sup>3</sup>  
 465.62 m<sup>3</sup> ✓  
 RSC  
 1-22-13  
 1-23-13  
 C.D.  
 12-30-11

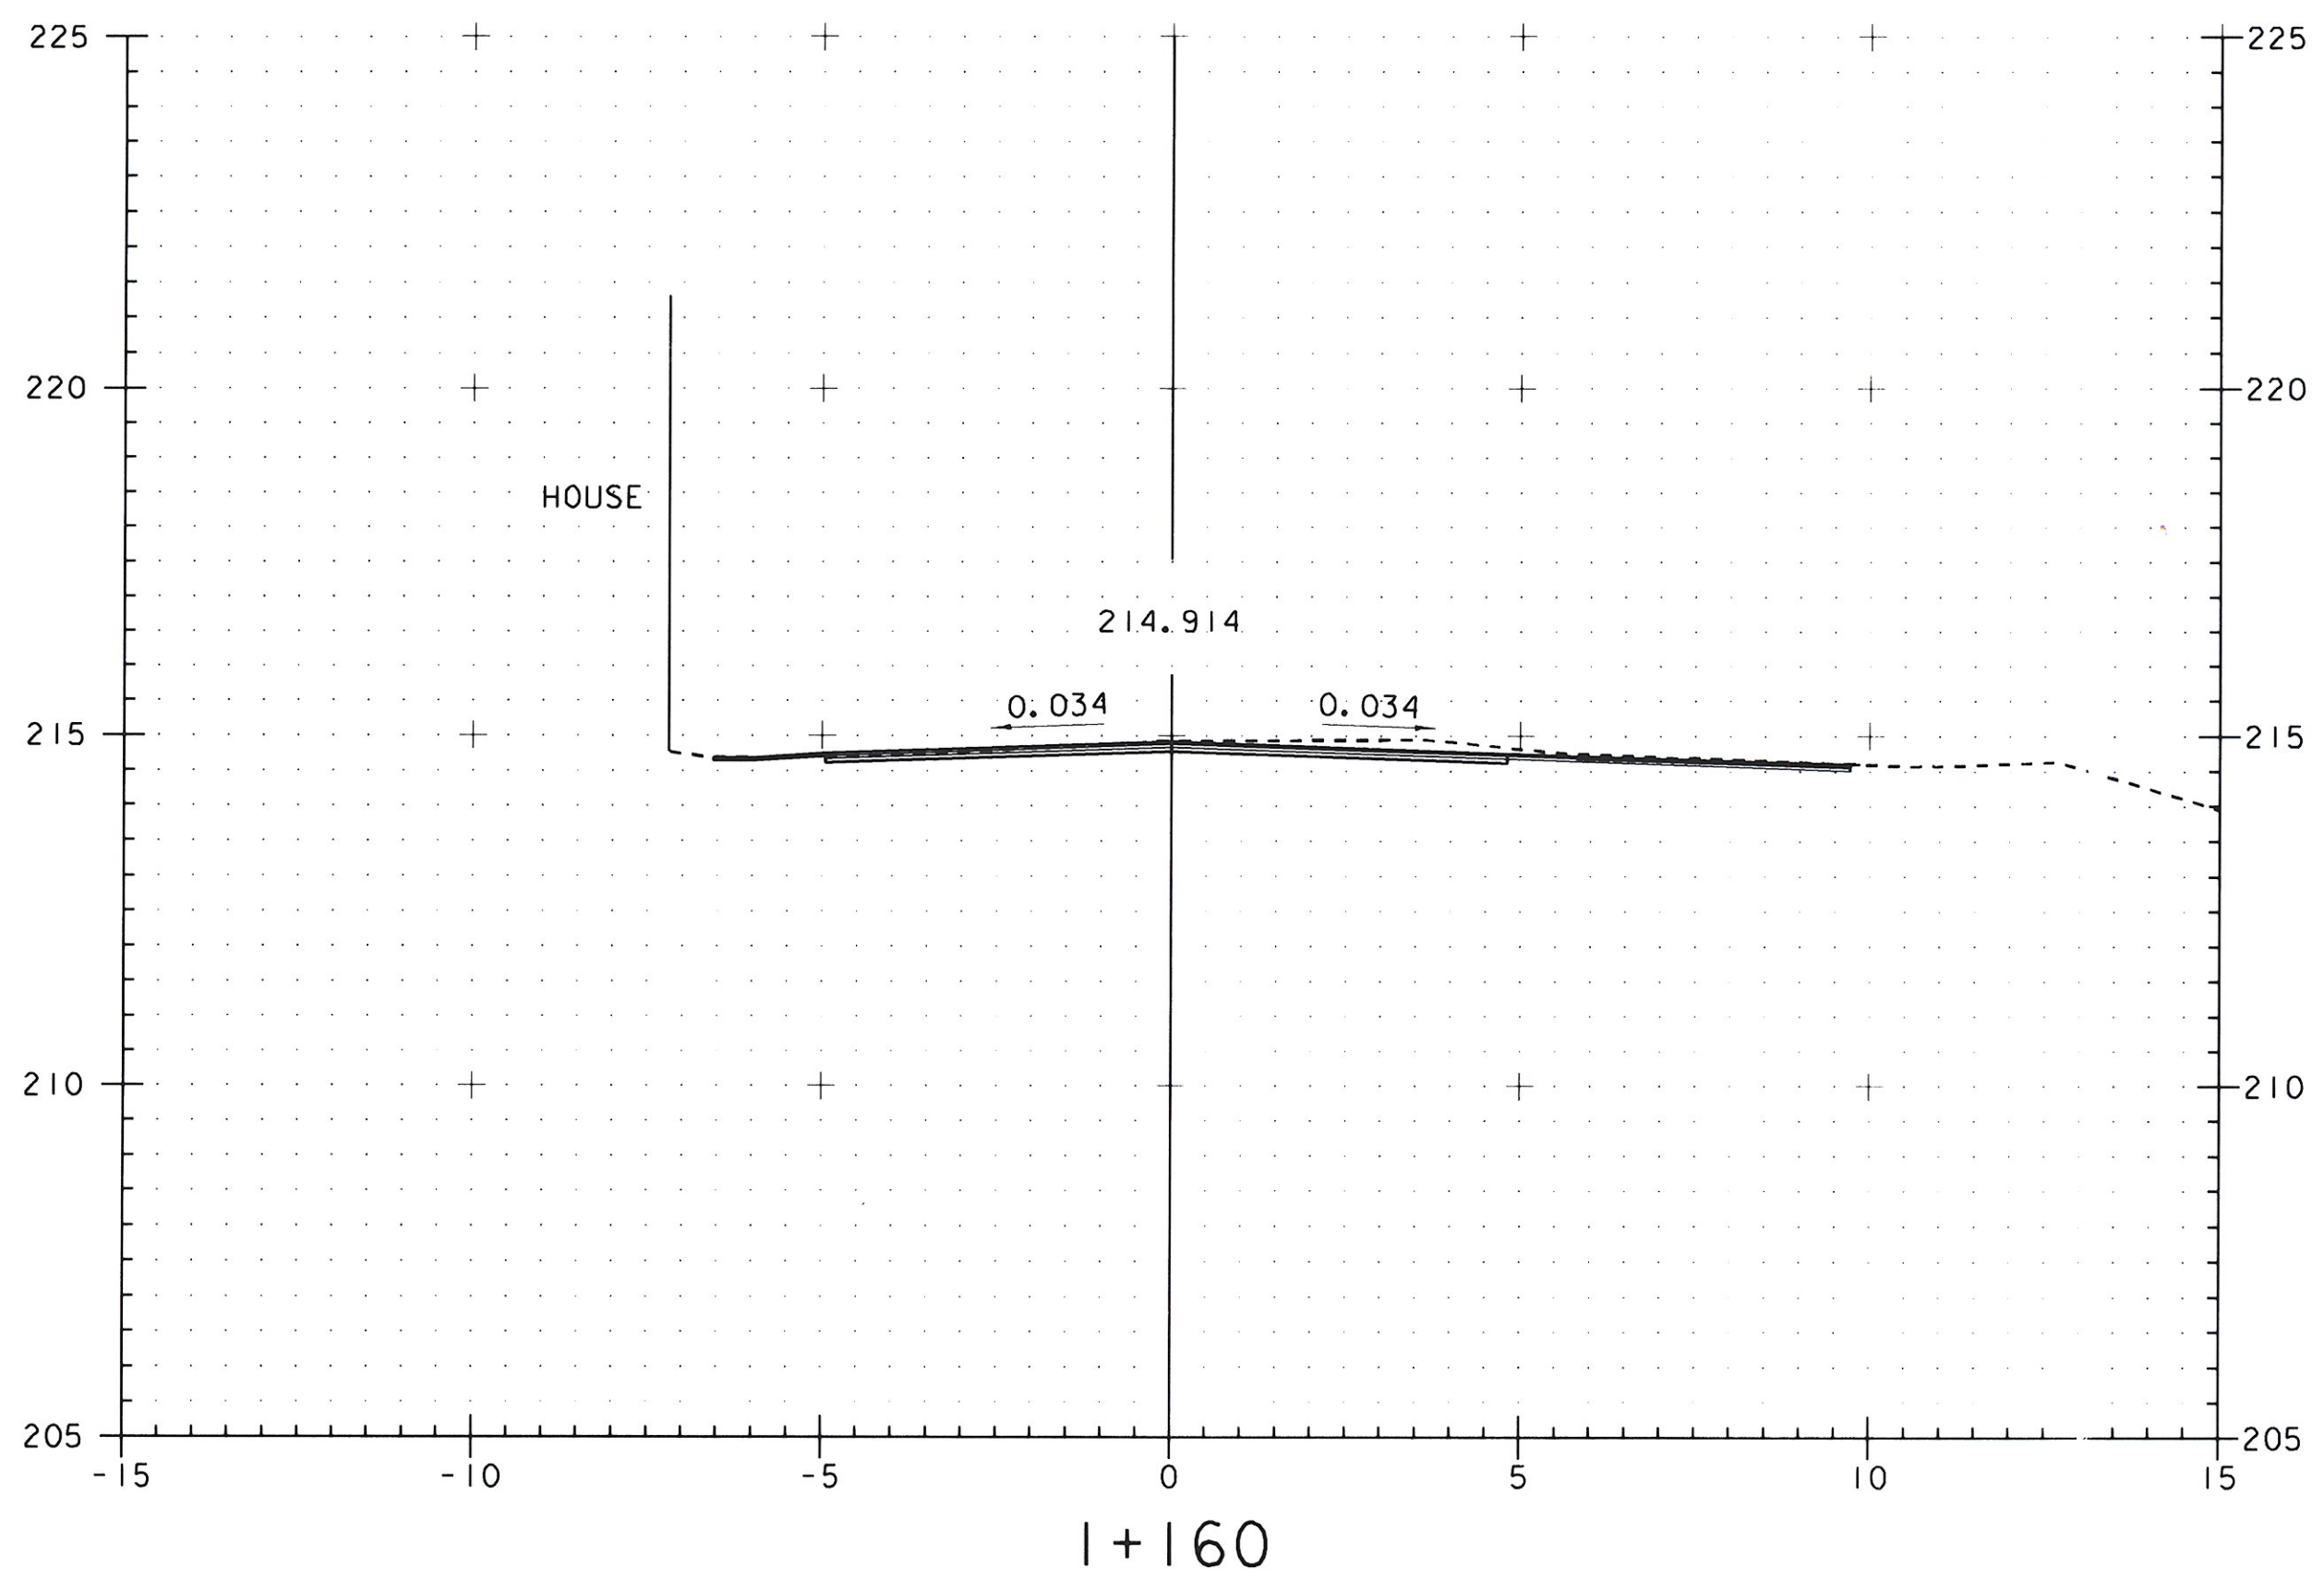

PROJECT: EAST MONTPELIER	PROJECT NO.: BRF 037-2(8)
DESIGN FILE NAME: 86e054/structures/se054xsl.dgn	PLOT DATE: 18-AUG-2010
IPARM FILE NAME: se054m5.i	
SECTION I+160 THROUGH I+180	
MAINLINE SECTIONS	SHEET: 56 OF 63