



STA 2+033.000
 (ABUTMENT No. 1)
 BEGIN STONE FILL TYPE IV
 BEGIN GEOTEXTILE UNDER STONE FILL
 BEGIN GRUBBING MATERIAL
 BEGIN UNCLASSIFIED CHANNEL EXCAVATION

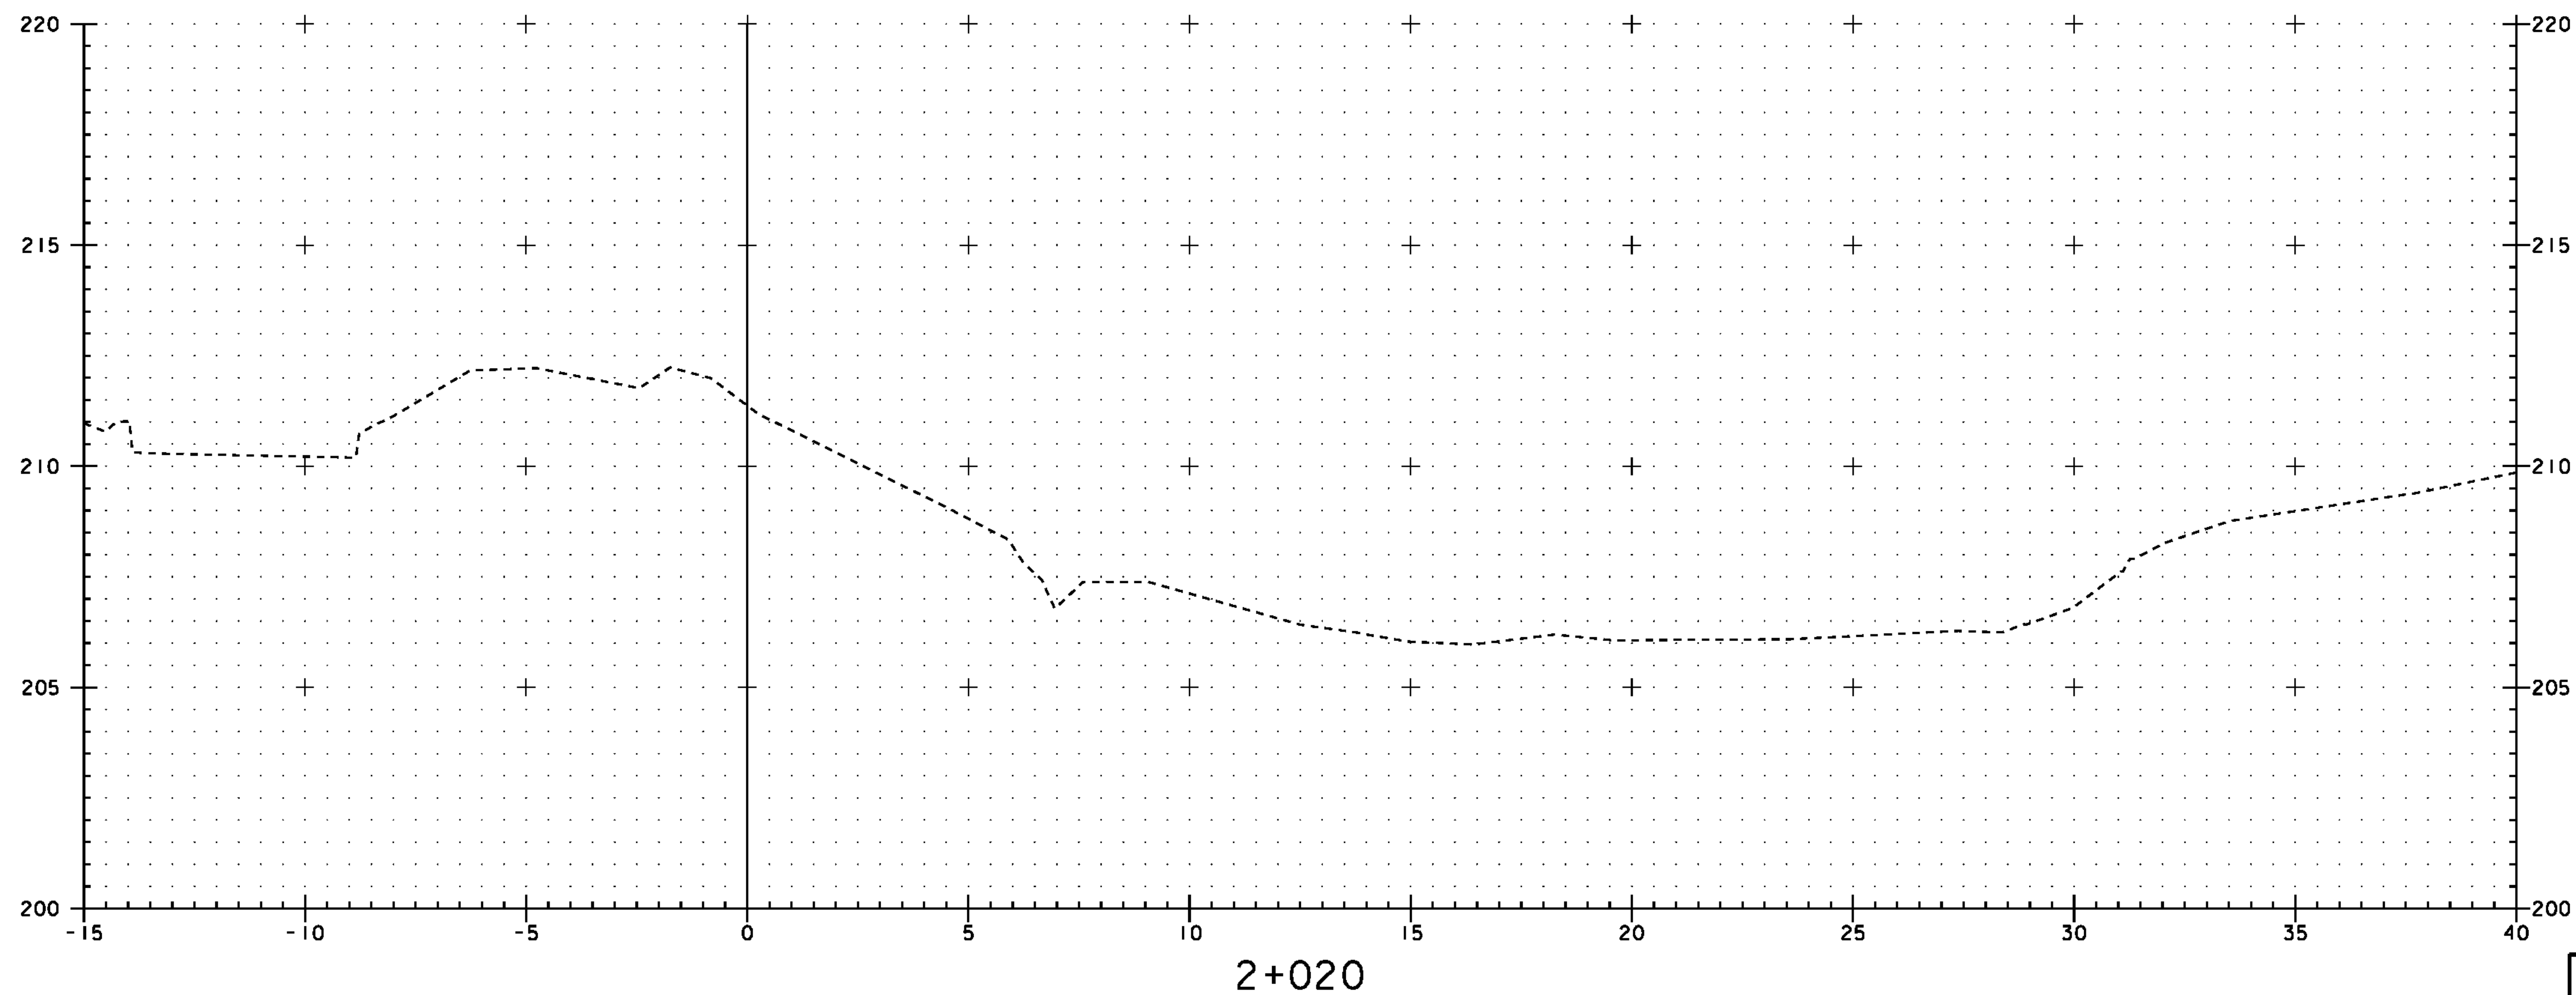

STA 2+030.200
 (ABUTMENT No. 2)
 BEGIN STONE FILL TYPE IV
 BEGIN GEOTEXTILE UNDER STONE FILL
 BEGIN GRUBBING MATERIAL
 BEGIN UNCLASSIFIED CHANNEL EXCAVATION

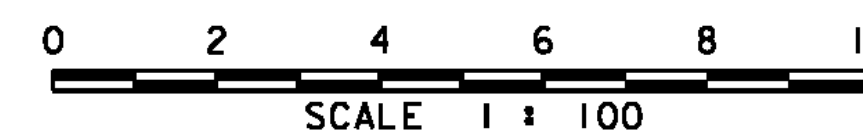

PROJECT: EAST MONTEPELIER	PROJECT NO.: BRF 037-2(8)
DESIGN FILE NAME: 86e054/structures/se054xsl.dgn	PLOT DATE: 18-AUG-2010
IPARM FILE NAME: se054ch2.i	
SECTION 2+020 THROUGH 2+030	
CHANNEL SECTIONS	SHEET: 58 OF 63