


STA 2+039.00  
 (ABUTMENT No. 1)

END STONE FILL TYPE IV  
 END GEOTEXTILE UNDER STONE FILL  
 END GRUBBING MATERIAL  
 END UNCLASSIFIED CHANNEL EXCAVATION

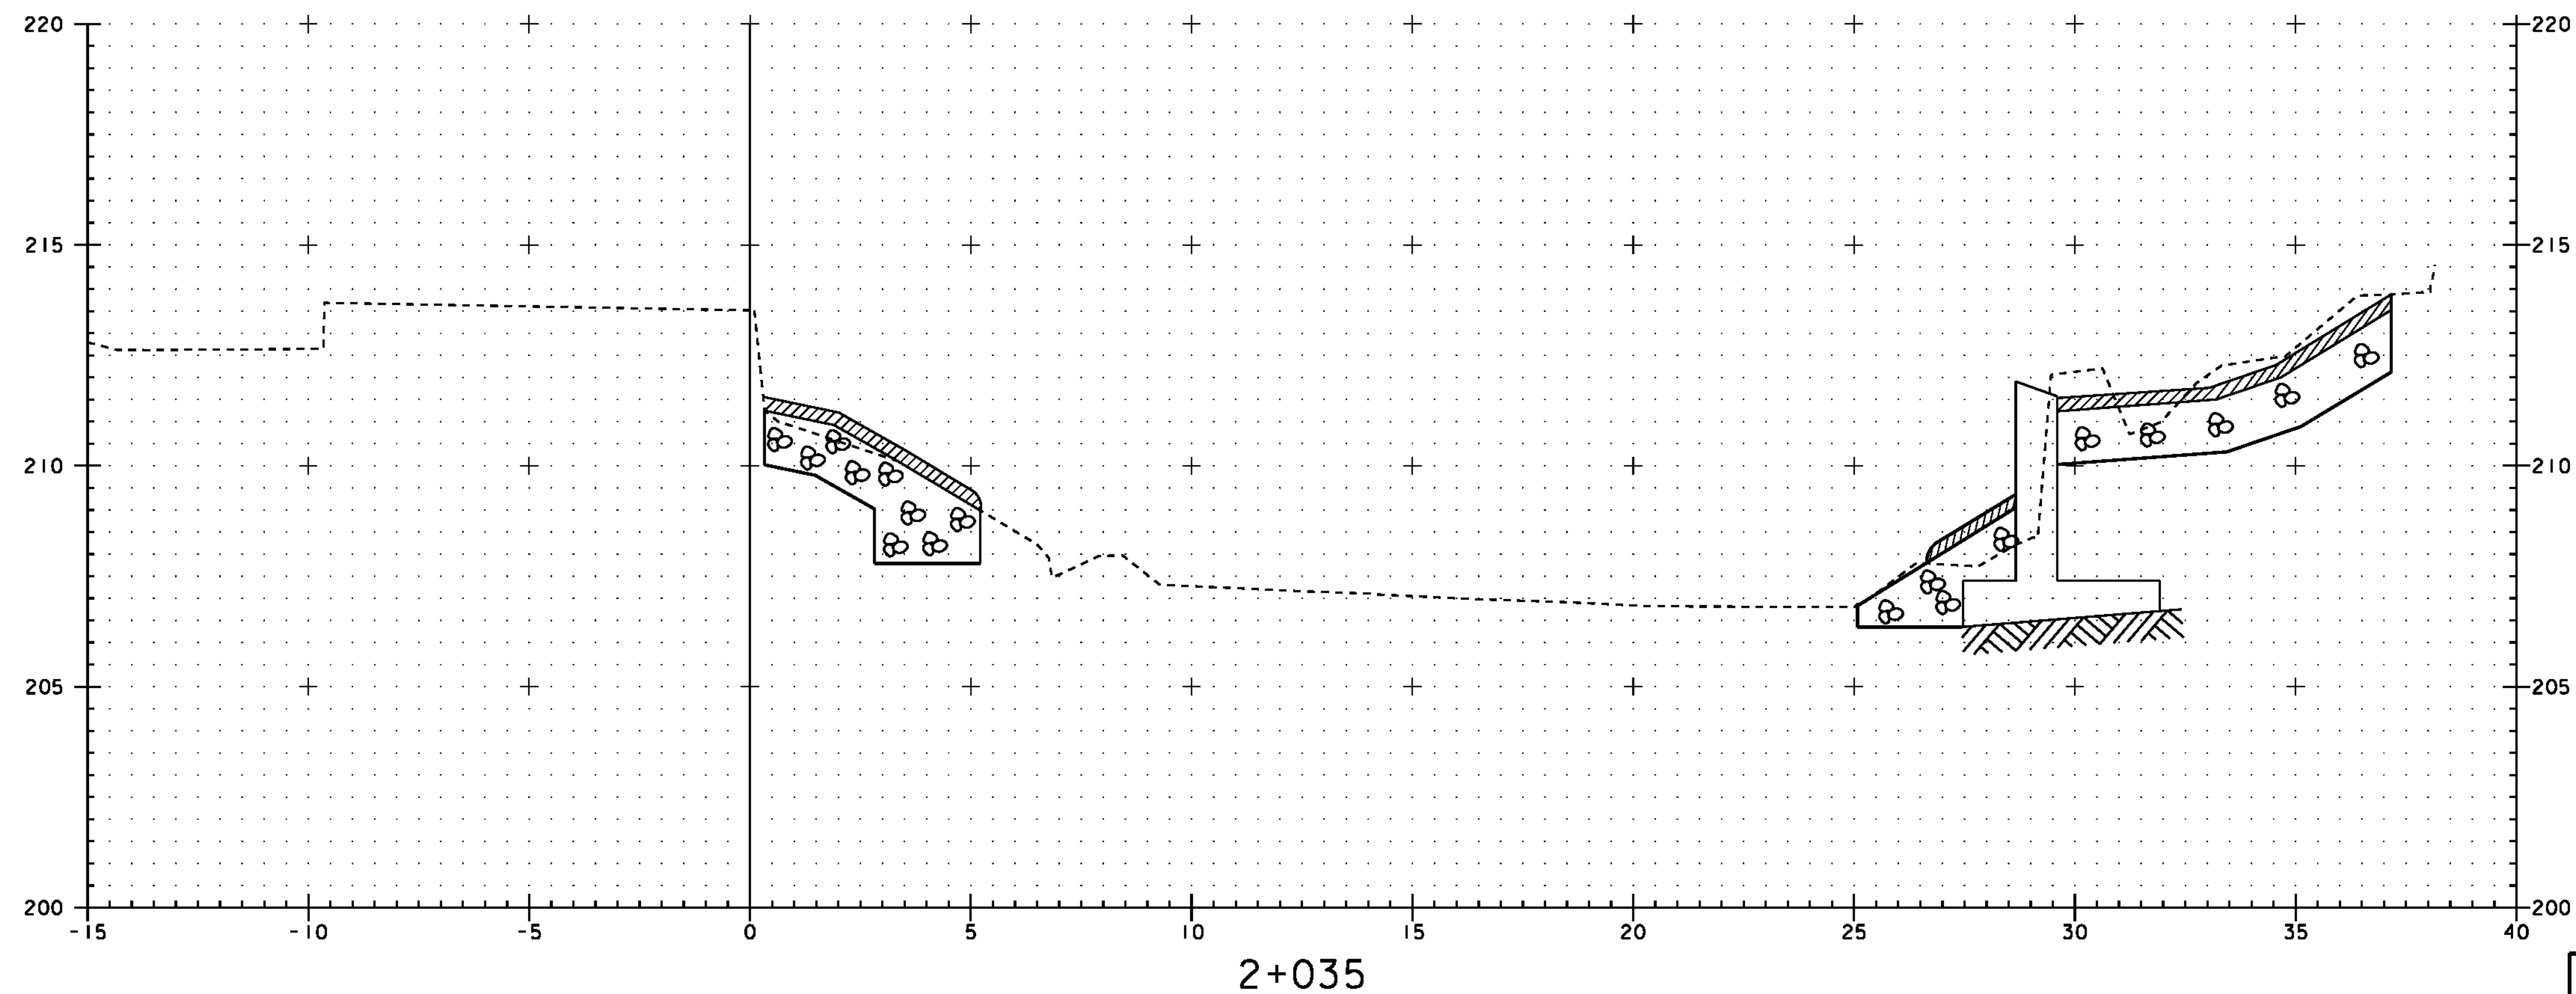

STA 2+039.00  
 (ABUTMENT No. 2)

END STONE FILL TYPE IV  
 END GEOTEXTILE UNDER STONE FILL  
 END GRUBBING MATERIAL  
 END UNCLASSIFIED CHANNEL EXCAVATION



PROJECT: EAST MONTPELIER	PROJECT NO.: BRF 037-2(8)
DESIGN FILE NAME: 86e054/structures/se054xsl.dgn	PLOT DATE: 18-AUG-2010
IPARM FILE NAME: se054ch3.i	
SECTION 2+035 THROUGH 2+040	
CHANNEL SECTIONS	SHEET: 59 OF 63