


STA 2+048.000  
 (ABUTMENT No. 1)  
 BEGIN STONE FILL TYPE IV  
 BEGIN GEOTEXTILE UNDER STONE FILL  
 BEGIN GRUBBING MATERIAL  
 BEGIN UNCLASSIFIED CHANNEL EXCAVATION

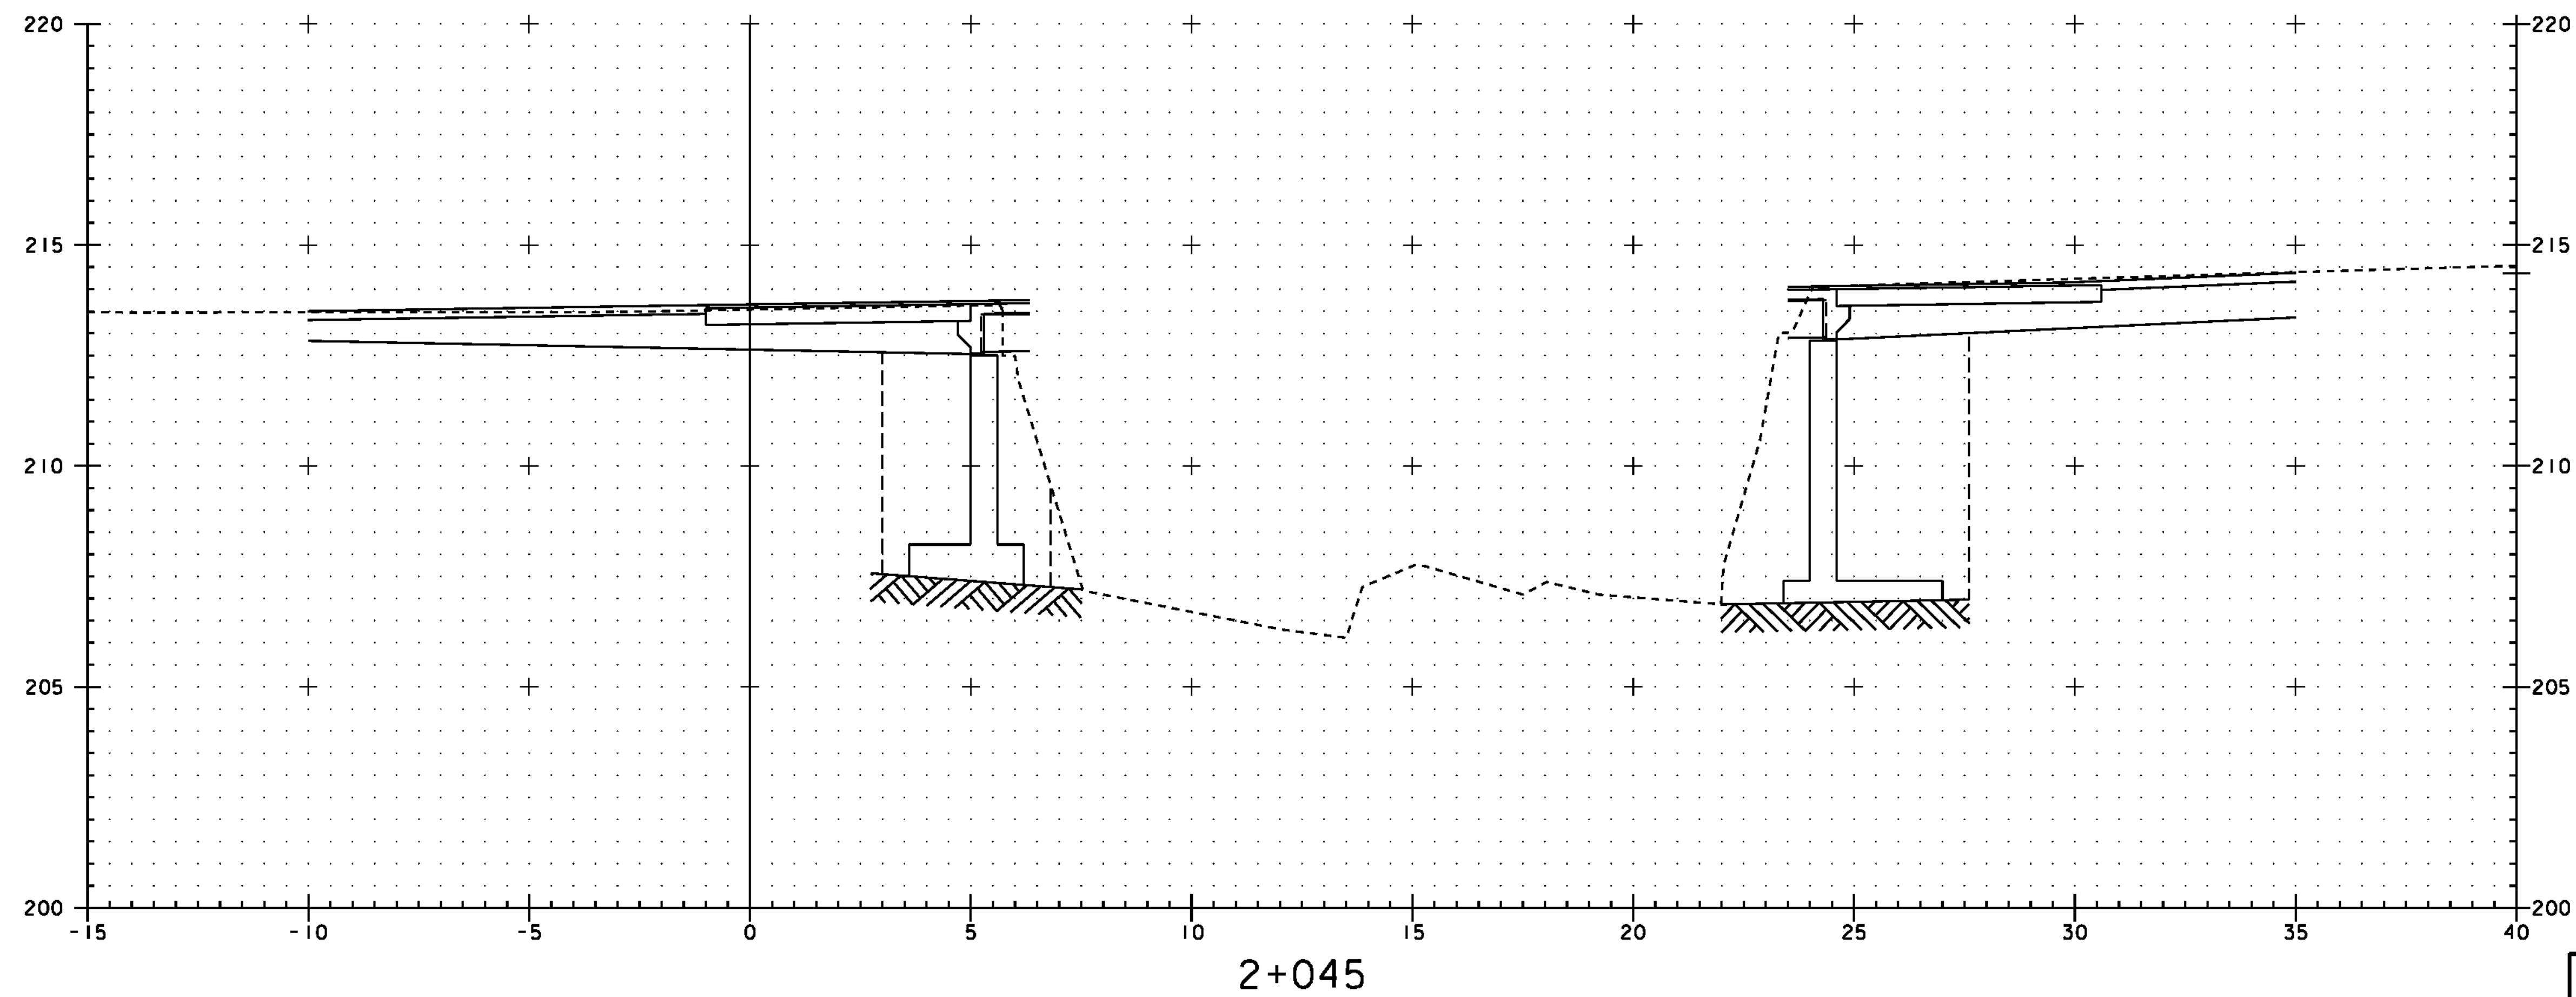

EAST MONTPELIER		PROJECT NO.:	BRF 037-2(8)
DESIGN FILE NAME: 86e054/structures/se054xsl.dgn		PLOT DATE: 18-AUG-2010	
IPARM FILE NAME: se054ch4.l		SECTION 2+045 THROUGH 2+050	
CHANNEL SECTIONS		SHEET: 60 OF 63	