



2+035.000

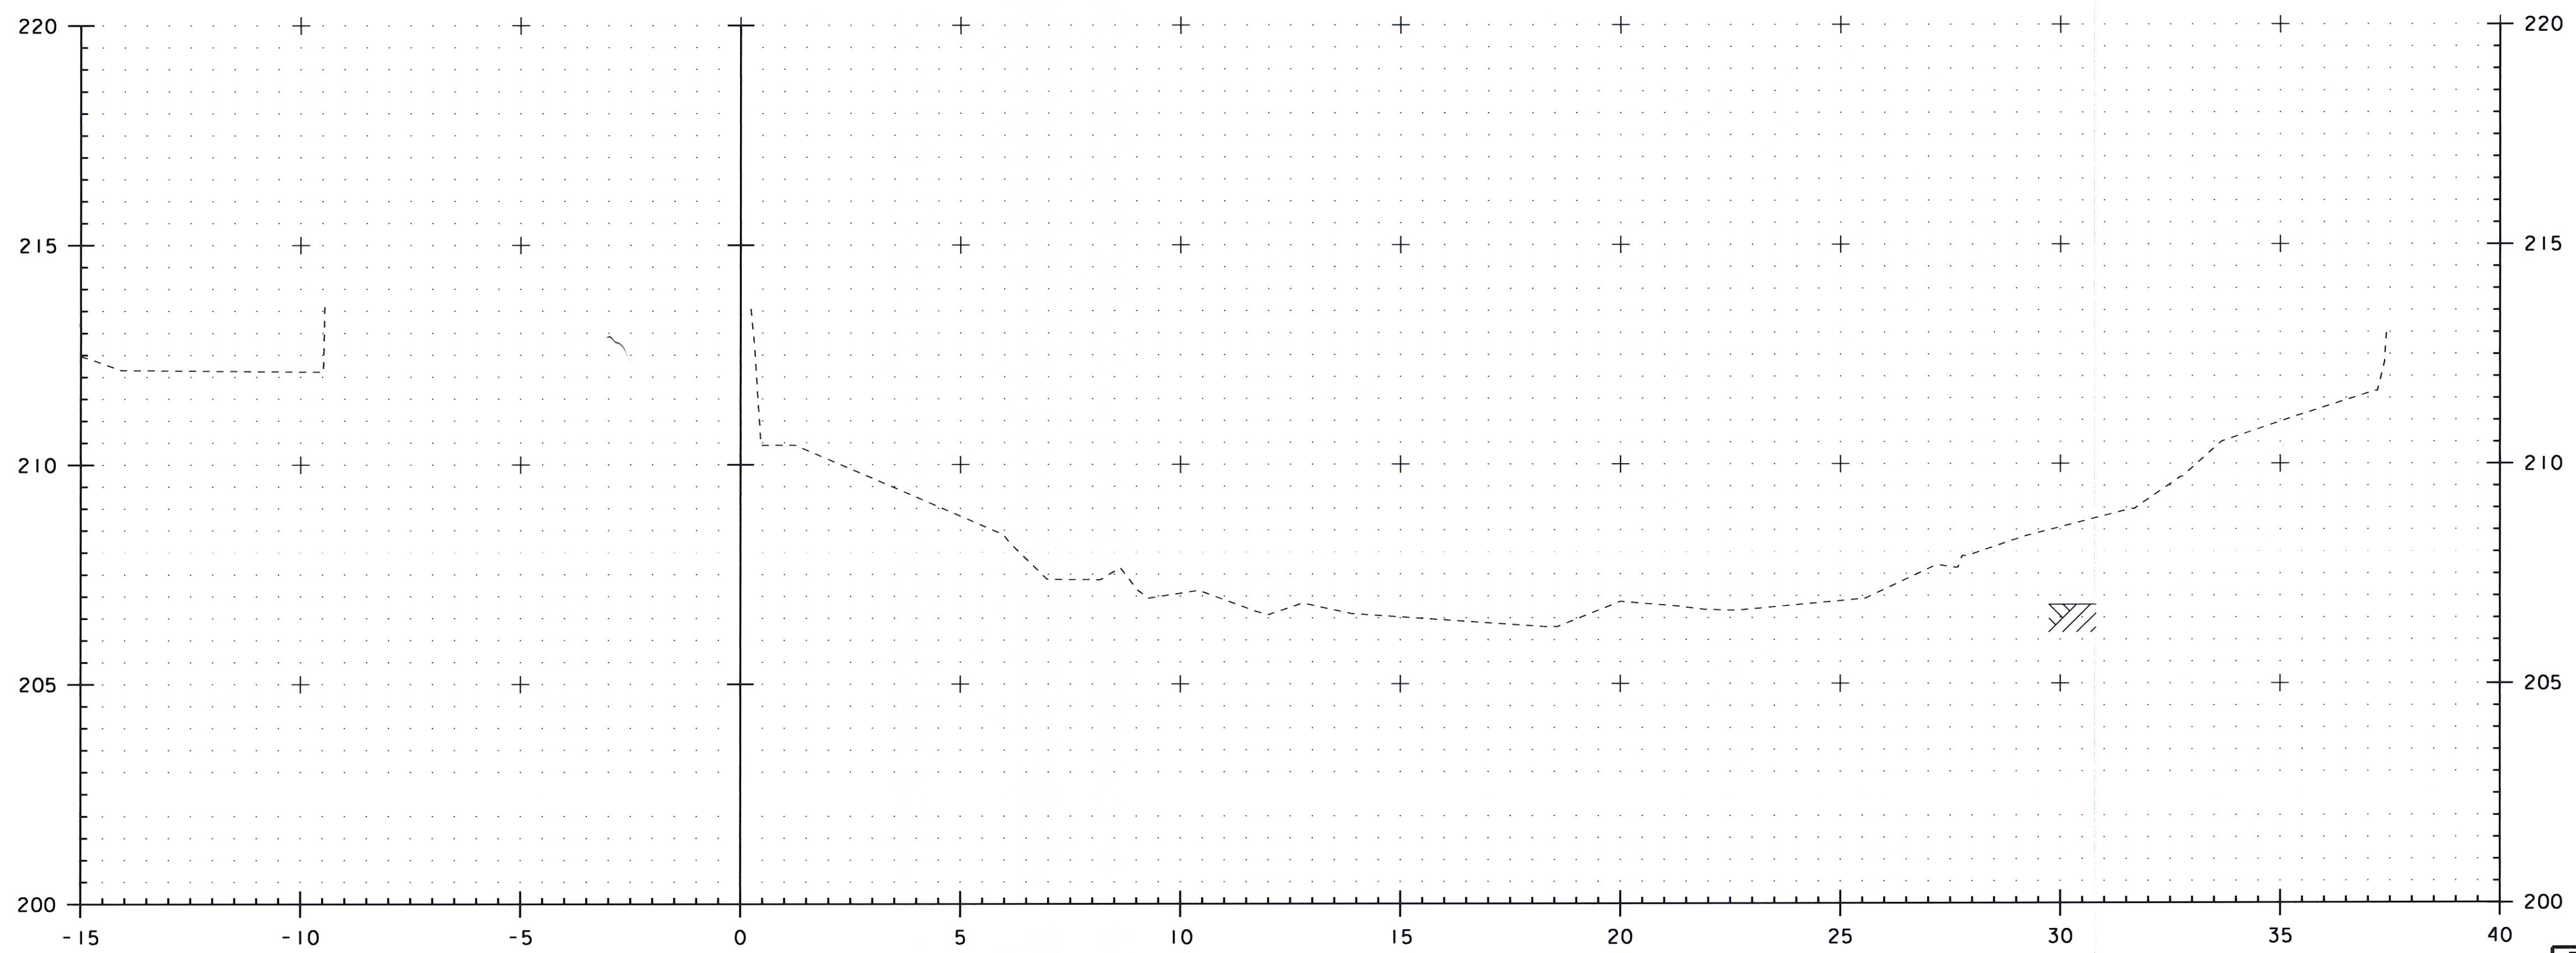

2+031.800

Begin Item 208.30 - Abut. #2 (Ø Section)

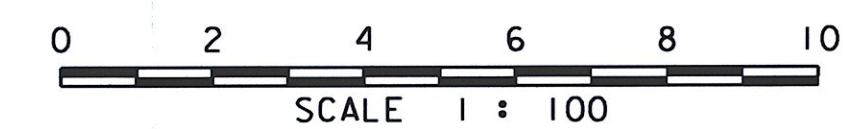

PROJECT: EAST MONTPELIER	PROJECT NO.: BRF 037-2(8)
DESIGN FILE NAME: 86e054/structures/se054xsl.extra.dgn	PLOT DATE: 19-DEC-2011
IPARM FILE NAME: se054chlextra.i	
SECTION 2+031.800 THROUGH 2+035.000	
CHANNEL SECTIONS	SHEET: 1 OF 6