



2+041.350
Same for Z+043.800 (Abut. No. 2)

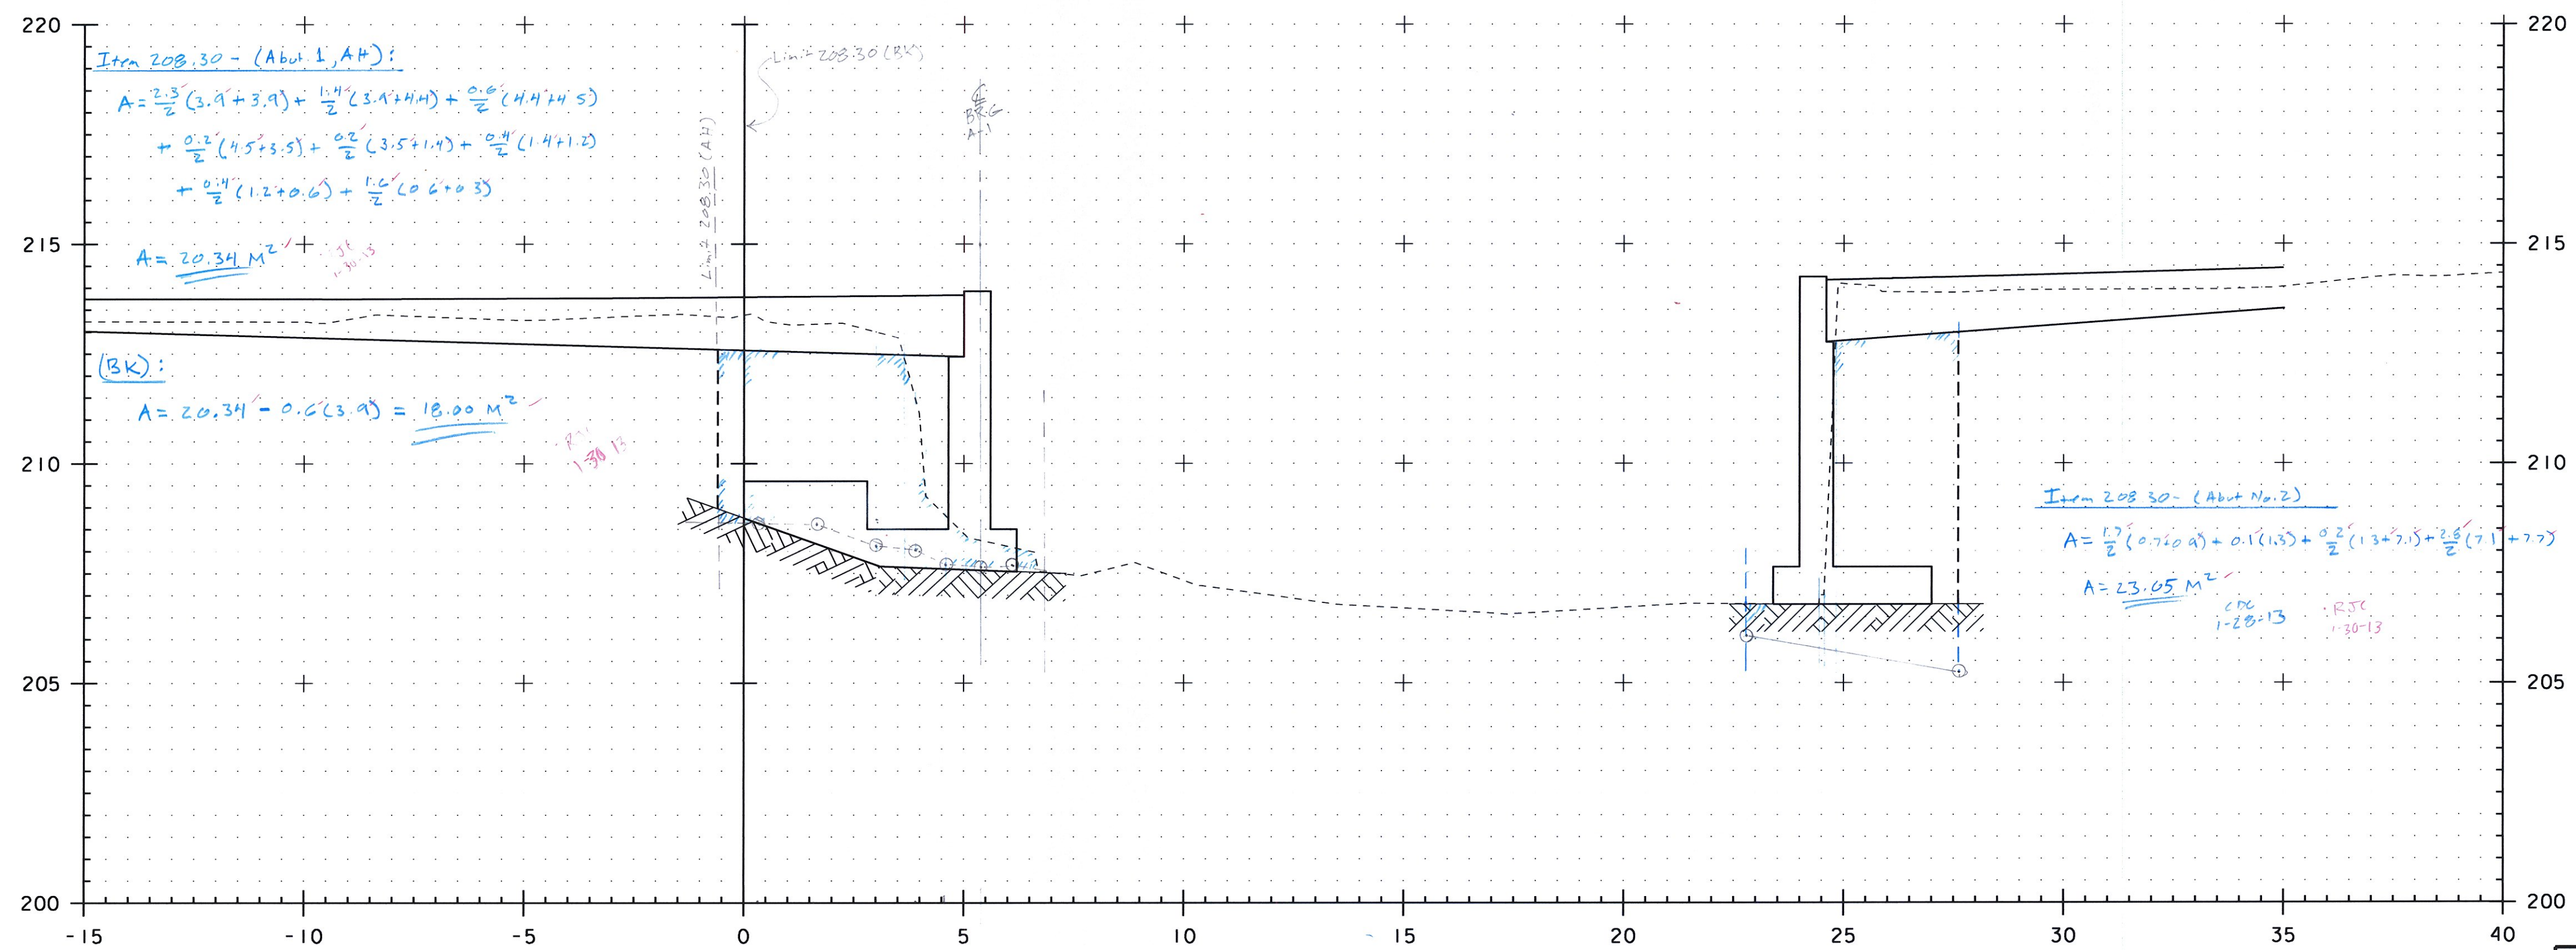

2+039.450
Same for: Z+039.200 (Abut. No. 1)

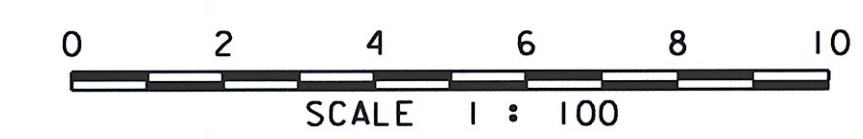

PROJECT: EAST MONTEPELIER	PROJECT NO.: BRF 037-2(8)
DESIGN FILE NAME: 86e054/structures/se054xsl_extra.dgn	PLOT DATE: 19-DEC-2011
SECTION 2+039.450 THROUGH 2+041.350	
CHANNEL SECTIONS	SHEET: 3 OF 6