


2+048.100



2+045.000 (Same for Sta 2+046.500 @ Abut. No. 2)

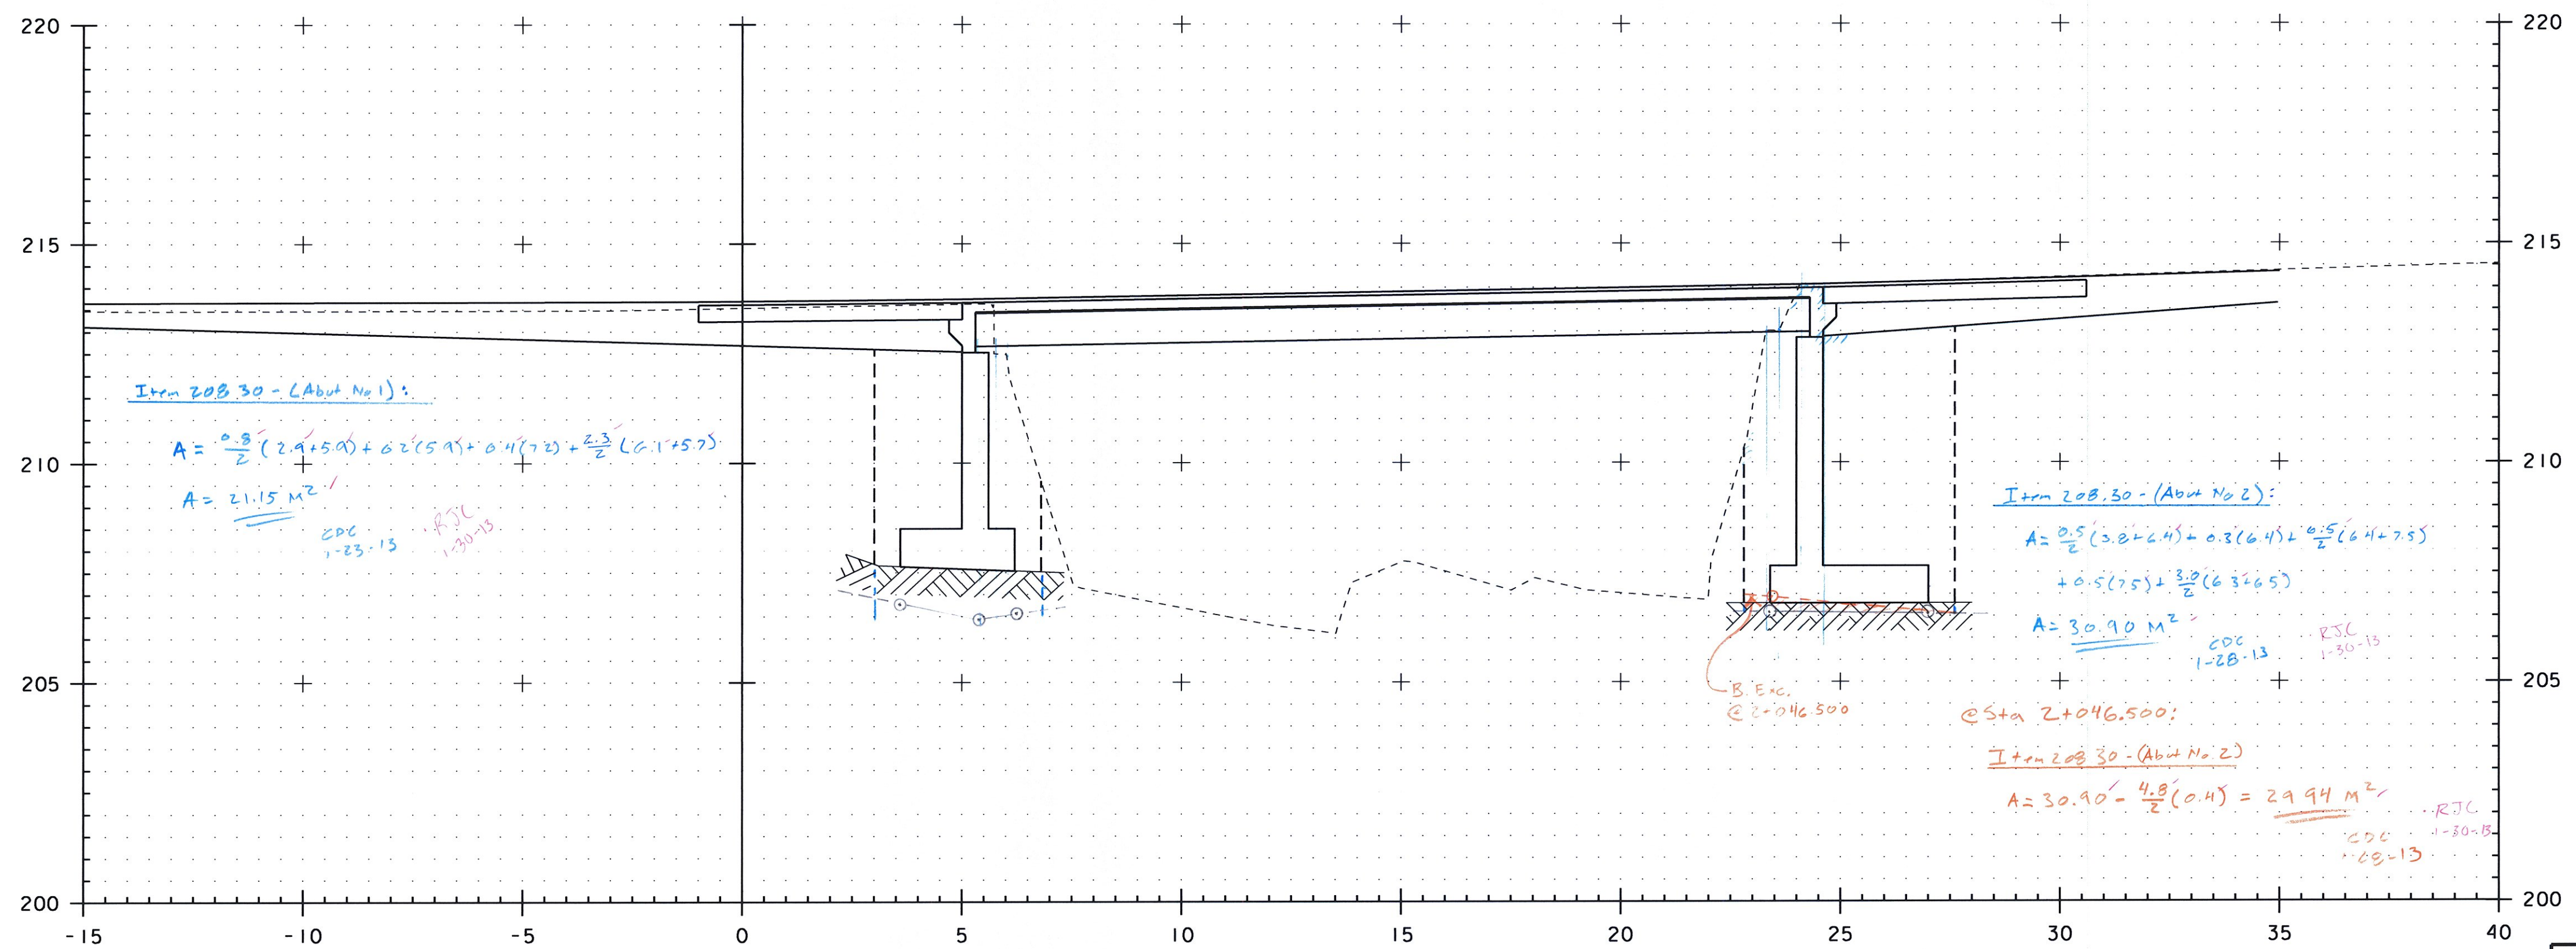

PROJECT: EAST MONTPELIER	PROJECT NO. : BRF 037-2(8)
DESIGN FILE NAME: 86e054/structures/se054xsl_extra.dgn	PLOT DATE: 19-DEC-2011
IPARM FILE NAME: se054ch4extra.i	
SECTION 2+045.000 THROUGH 2+048.100	
CHANNEL SECTIONS	SHEET: 4 OF 6