



2+051.700 = Z+051.500 (Abut. No. 2)  
 Same for Z+051.400 (Abut. 1)

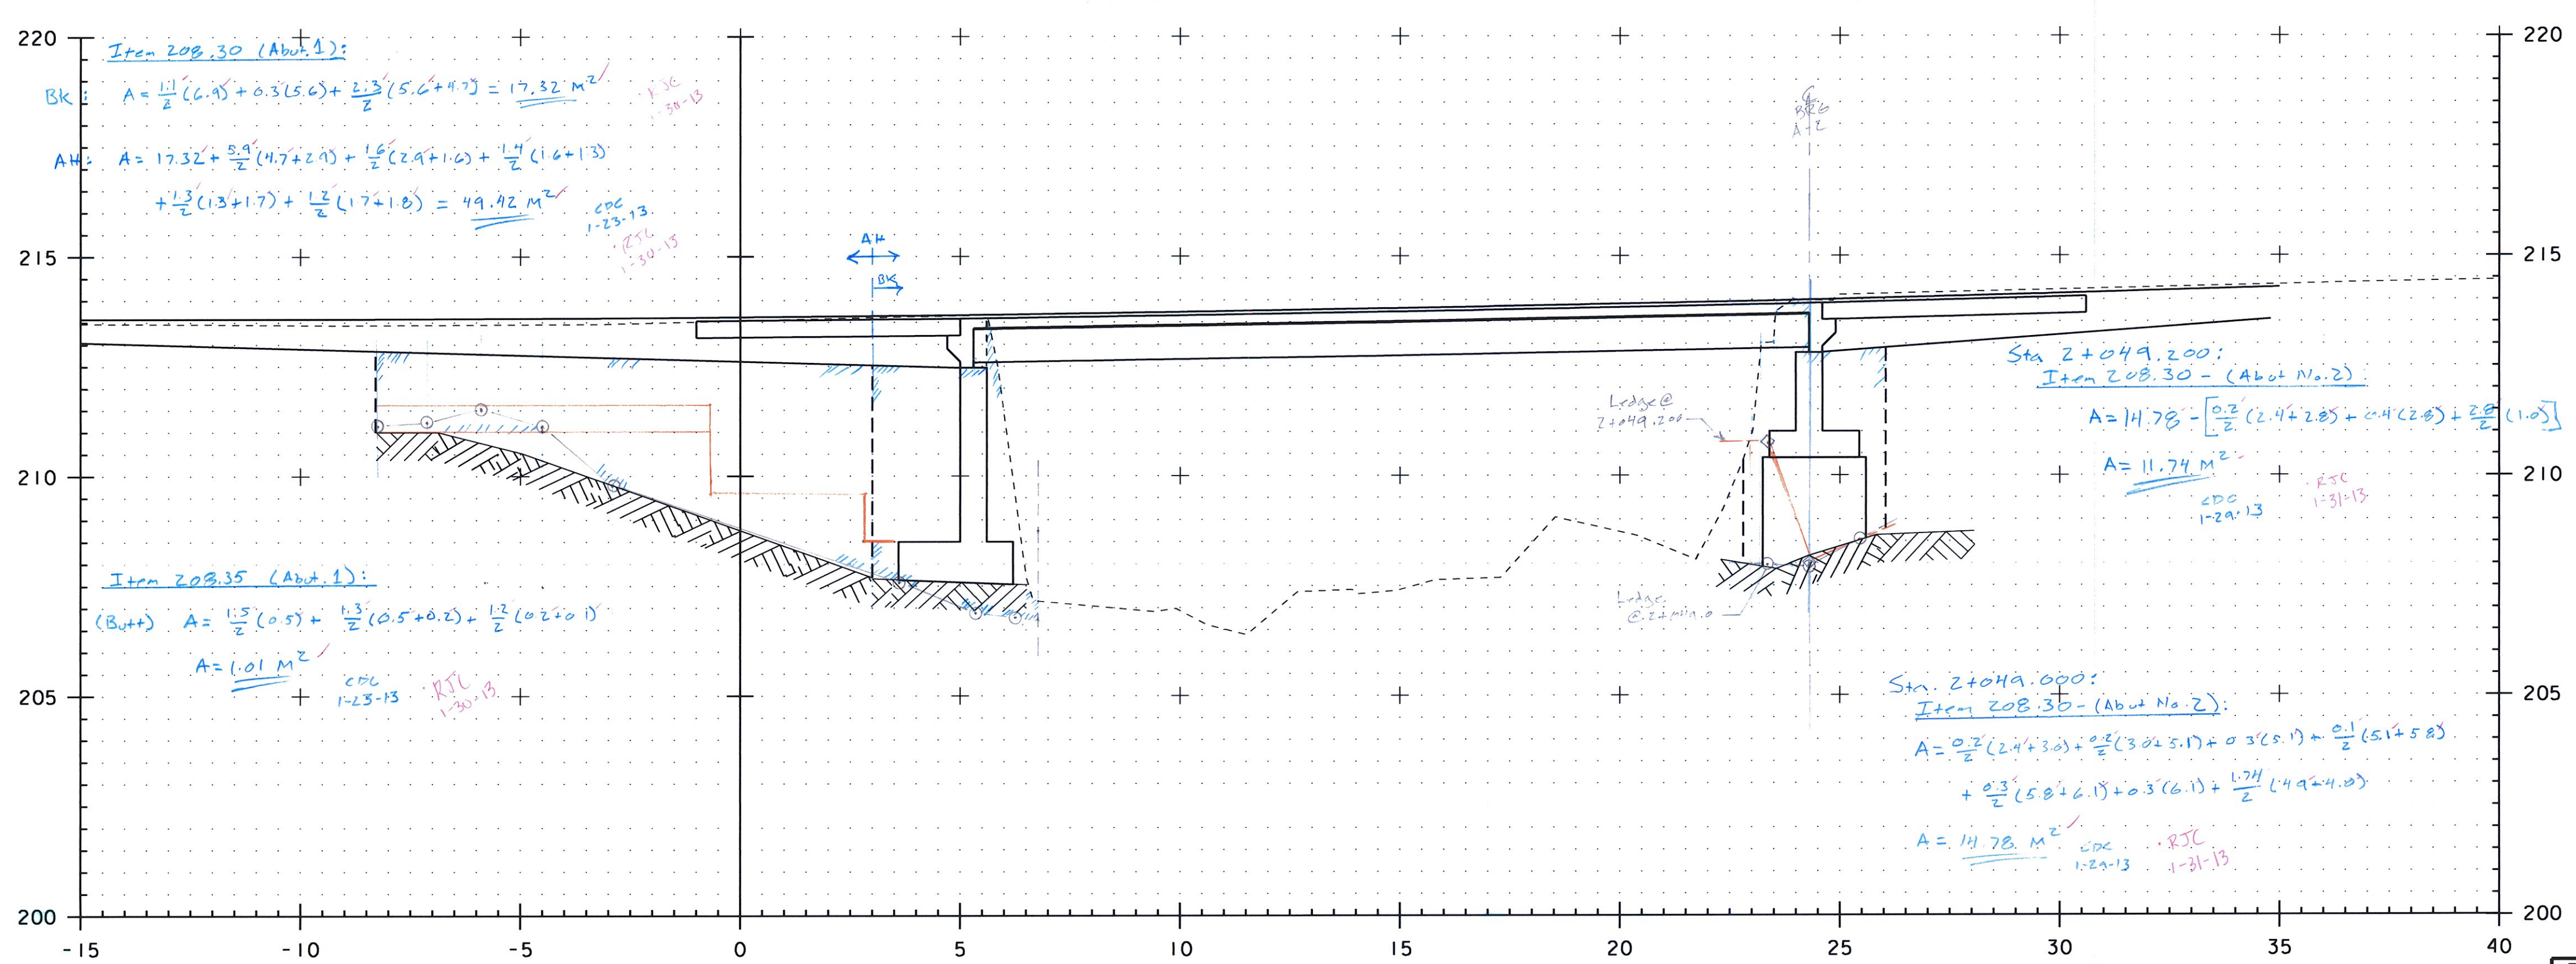

2+048.650  
 Same for Z+049.000 & Z+049.200 (Abut. No. 2)

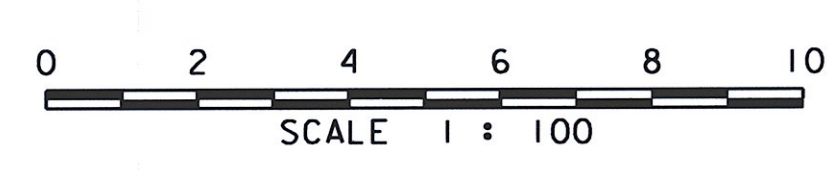

PROJECT: EAST MONTPELIER	PROJECT NO.: BRF 037-2(8)
DESIGN FILE NAME: 86e054/structures/se054xsl_extra.dgn	PLOT DATE: 19-DEC-2011
IPARM FILE NAME: se054ch5extra.i	
SECTION 2+048.650 THROUGH 2+051.700	
CHANNEL SECTIONS	SHEET: 5 OF 6