


DIM'S TYPICAL AT ALL APPROACH POSTS AND STANDOFFS  
MATERIAL: ALLOY 6061-T6

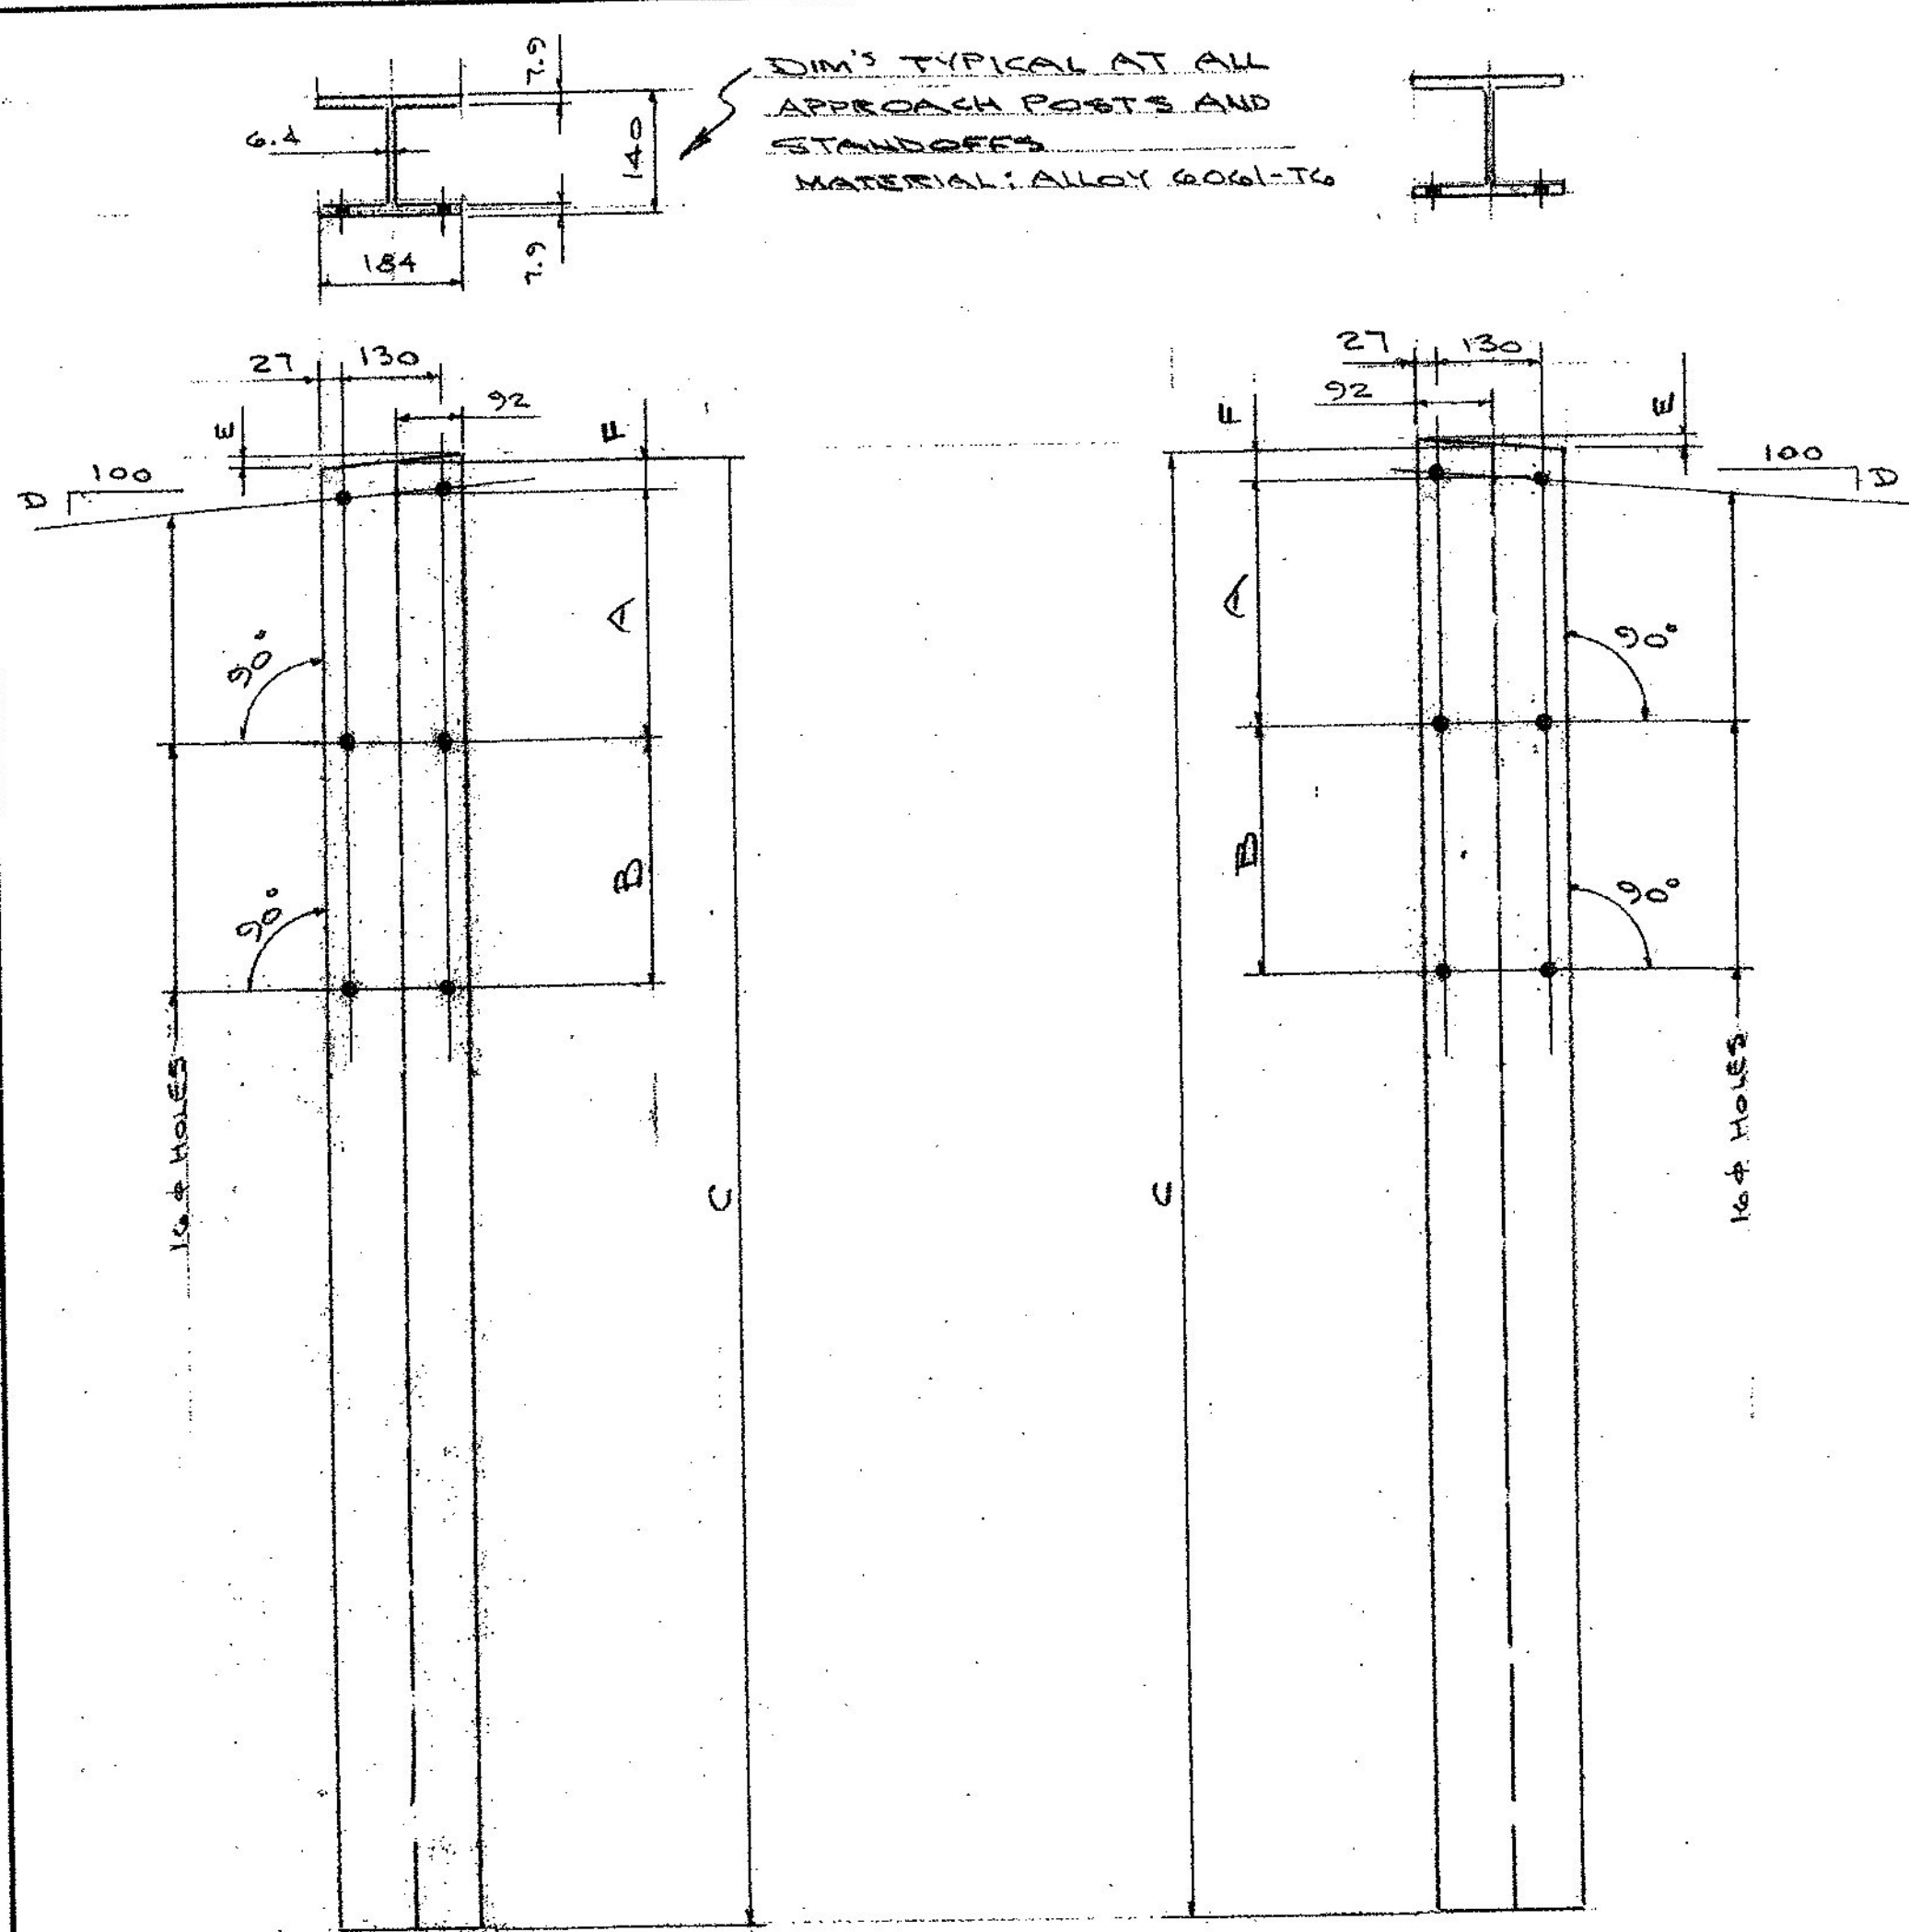


APPROACH POSTS

QUAN	MK	A	B	C	D	E	F
2	1L	291	435	1981	8.9	16	40
2	2L	248	403	1981	8.9	16	40
2	3L	206	370	1981	8.9	16	40
2	4L	167	337	1981	8.9	16	40
2	5L	-	294	1829	4.4	8	51
2	6L	-	249	1829	4.4	8	51
2	7L	-	205	1829	4.4	8	51


APPROACH POSTS

QUAN	MK	A	B	C	D	E	F
2	1R	291	435	1981	8.9	16	40
2	2R	248	403	1981	8.9	16	40
2	3R	206	370	1981	8.9	16	40
2	4R	167	337	1981	8.9	16	40
ONE	5R	-	294	1829	4.4	8	51
ONE	6R	-	249	1829	4.4	8	51
ONE	7R	-	205	1829	4.4	8	51

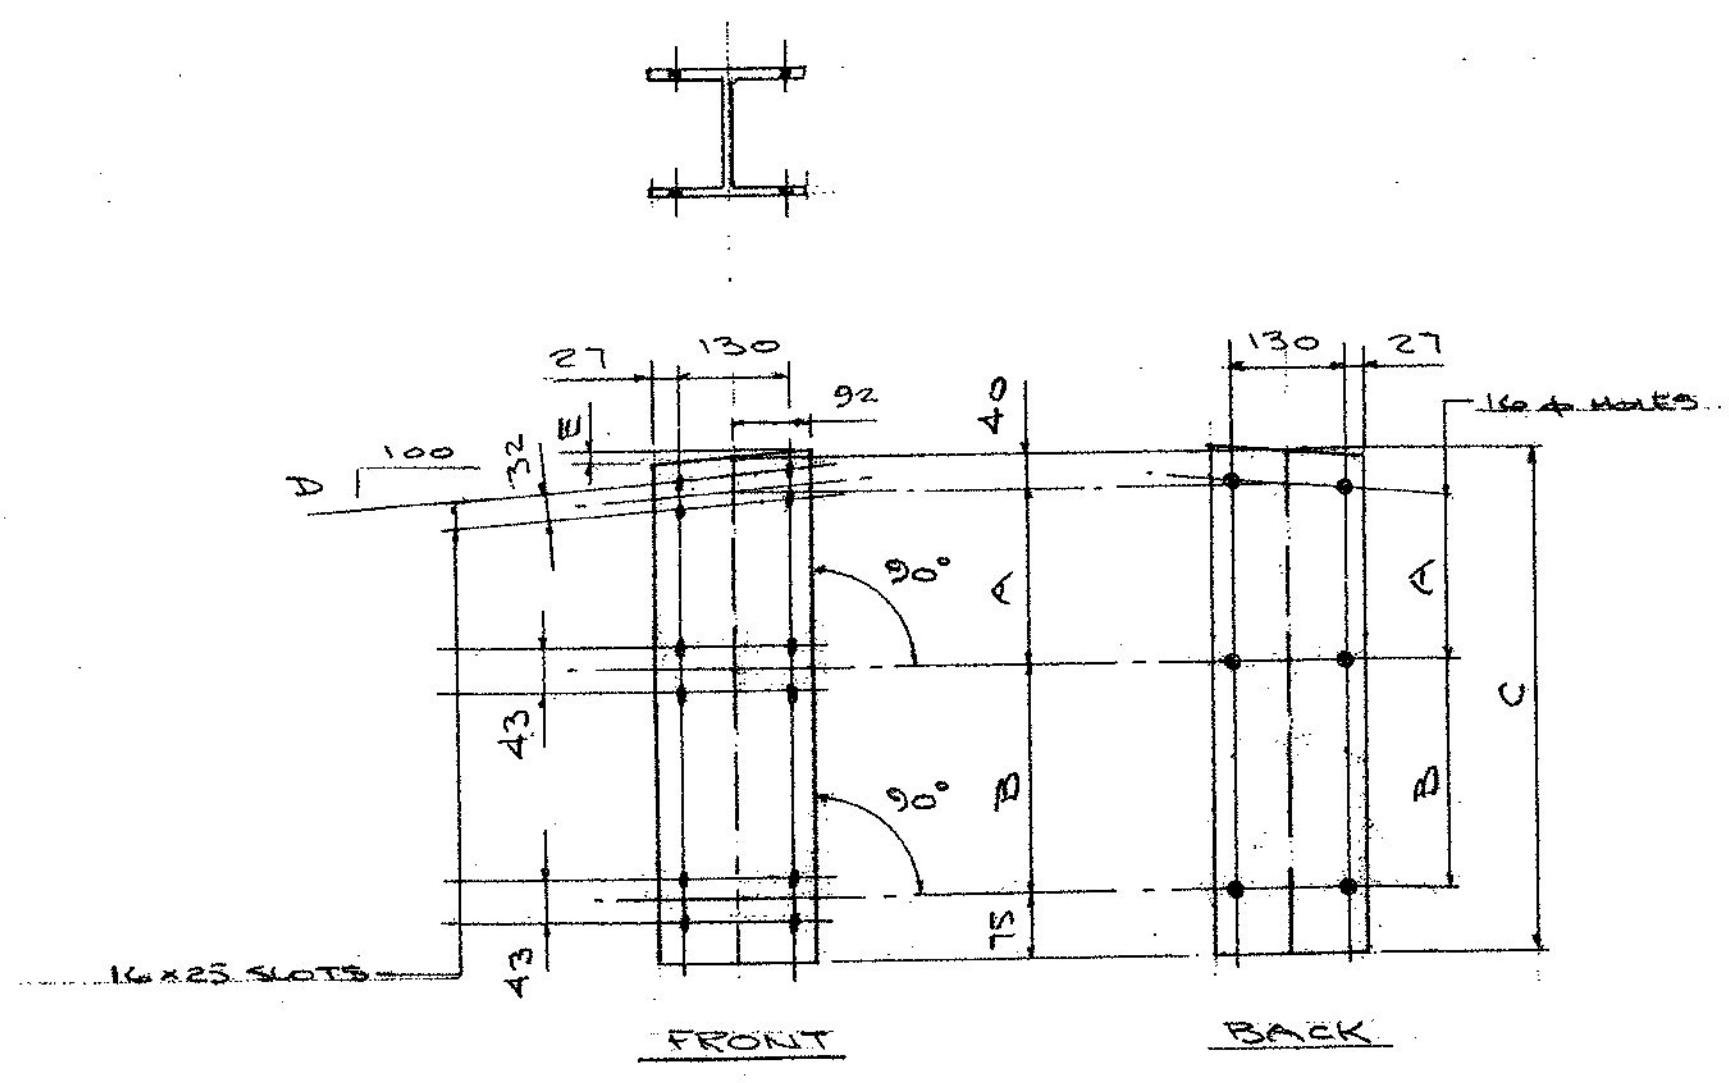


STANDOFFS

QUAN	MK	A	B	C	D	E
2	1L	291	435	841	8.9	16
2	2L	248	403	766	8.9	16
2	3L	206	370	691	8.9	16
2	4L	167	337	619	8.9	16

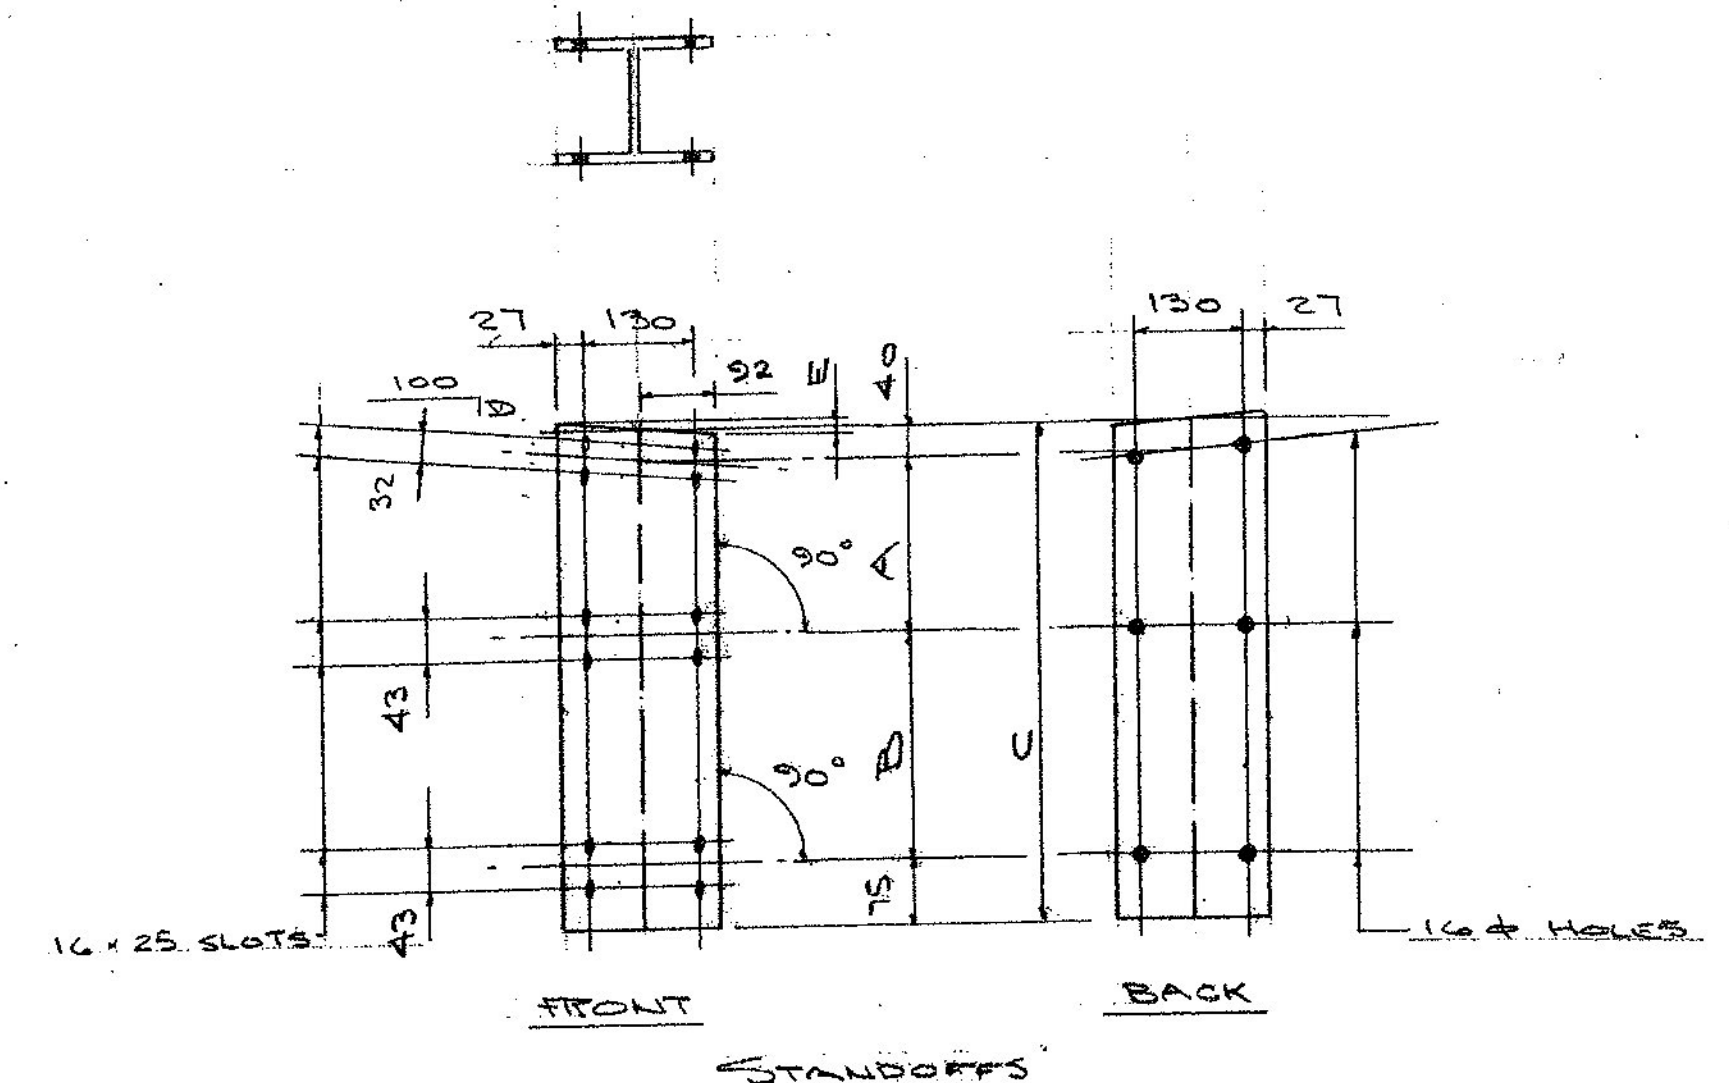


STANDOFFS

QUAN	MK	A	B	C	D	E
2	1R	291	435	841	8.9	16
2	2R	248	403	766	8.9	16
2	3R	206	370	691	8.9	16
2	4R	167	337	619	8.9	16

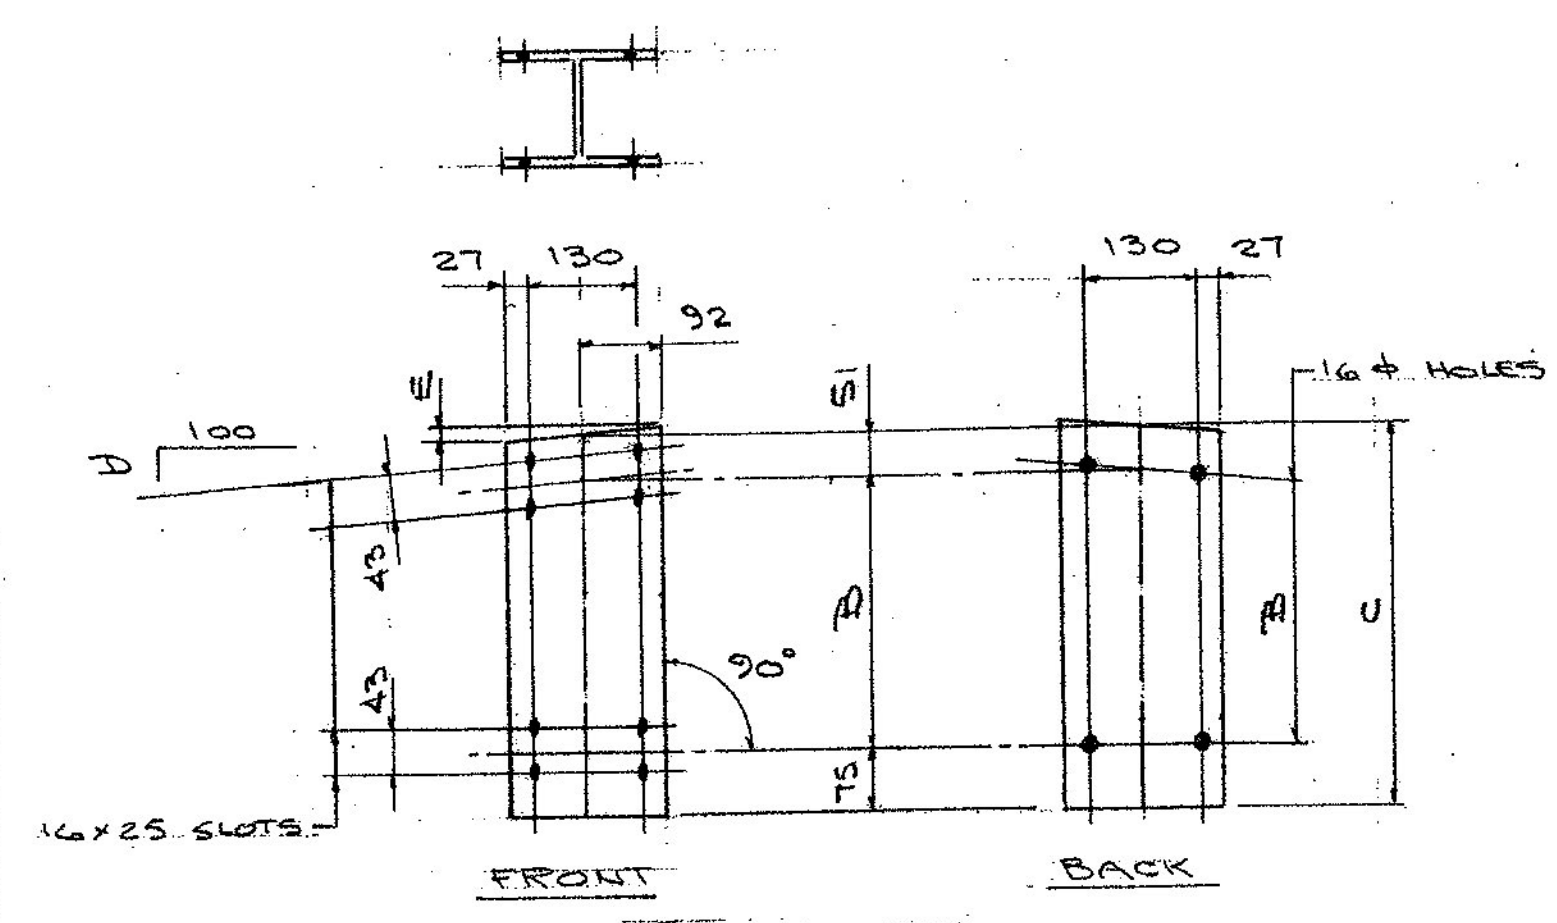

STANDOFFS

QUAN	MK	B	C	D	E
2	5L	294	420	4.4	8
2	6L	249	375	4.4	8
2	7L	205	331	4.4	8

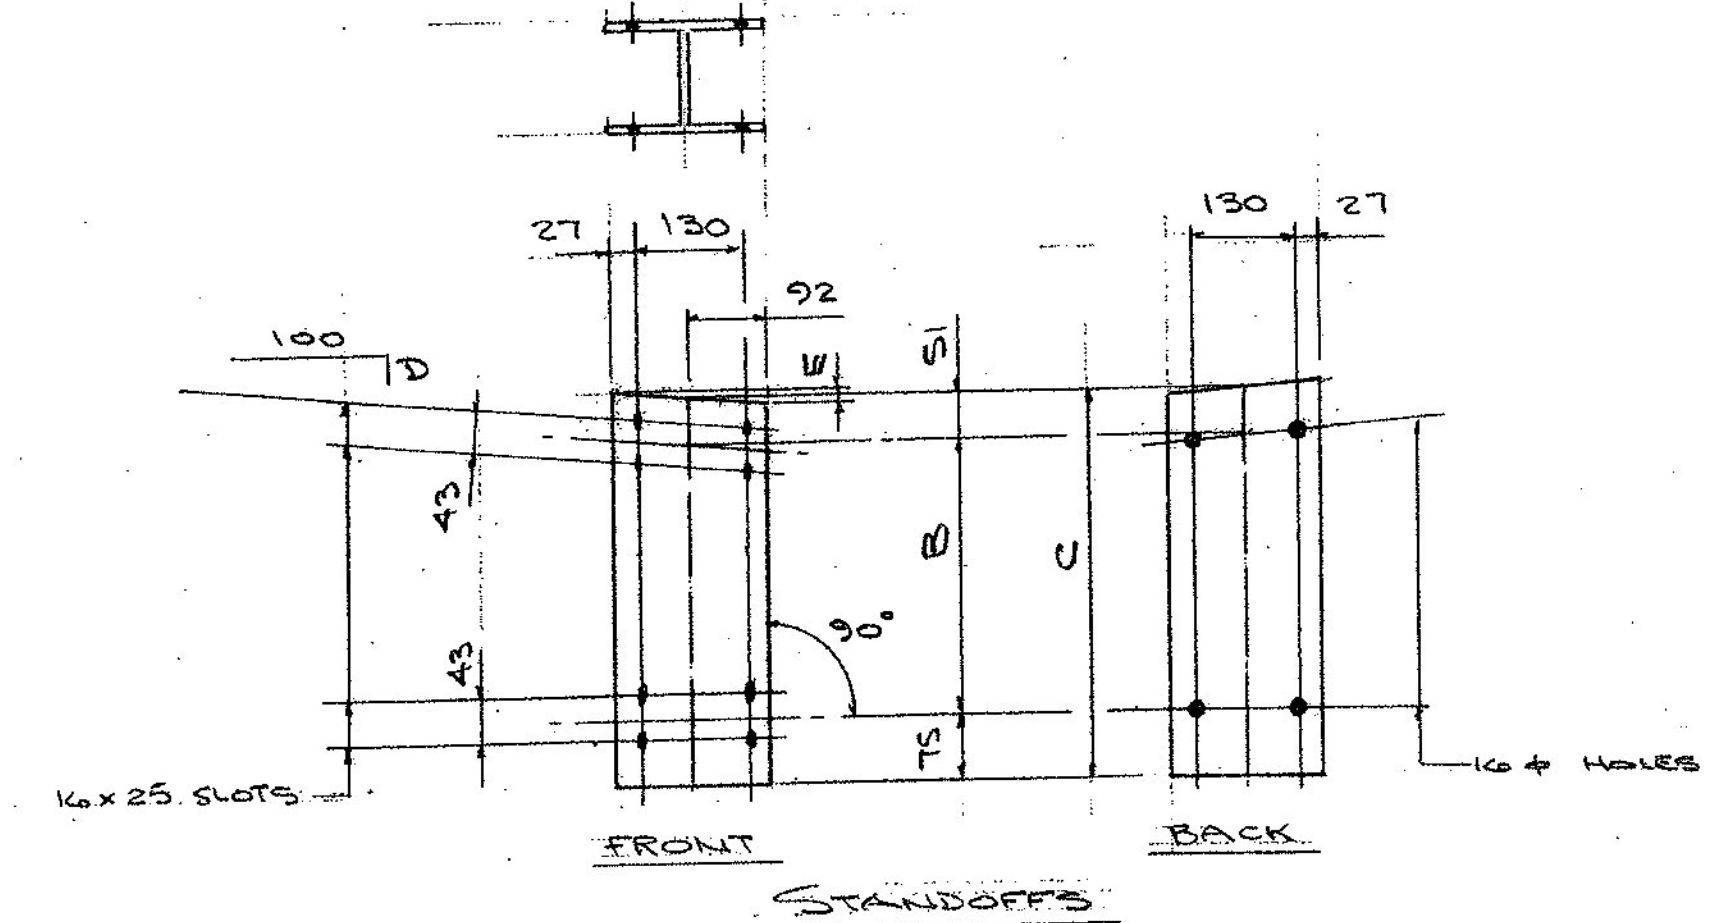

STANDOFFS

QUAN	MK	B	C	D	E
ONE	5R	294	420	4.4	8
ONE	6R	249	375	4.4	8
ONE	7R	205	331	4.4	8

Received Date: 6/1/11  
Checked By: Hiram Salls  
Reviewed By: Rob Young  
Approval Type: Approved  
Approved By: Chris Williams  
Date: 6/13/11

**AUCIELLO IRON WORKS INC**  
560 MAIN ST. HUDSON, MA (978) 568-8382

VT. AGENCY OF TRANSPORTATION  
EAST MONTPELIER, VT.  
VT. RT. 14, BRIDGE # 17  
BRF 037-2(8)

ALUM. APPROACH RAILING

SURFACE PREP: NONE FINISH: MILL

FOR: FR. LAFAYETTE, INC.  
DR: 3-22-2011 DWG. NO.  
CHK: 5-25-11 BR-3006

JOB NO. A817044-1002 SHEET 2 OF 10

ISSUE	DATE	DESCRIPTION
1	5-25-11	FOR APPROVAL

DIM'S ARE GIVEN IN MILLIMETERS