


CONTRACTOR NOTE:
 TOP OF CONCRETE PEDESTAL ELEVATIONS SHOWN CONFORM TO CONTRACT DRAWING ELEVATIONS. TOP OF CONCRETE PEDESTAL ELEVATIONS MUST BE ADJUSTED FOR ANY DEVIATION IN BEARING HEIGHTS. "FOSTER.PRECISE" WILL NOT BE RESPONSIBLE FOR ANY COST RELATIVE TO IMPROPER PEDESTAL ELEVATIONS.

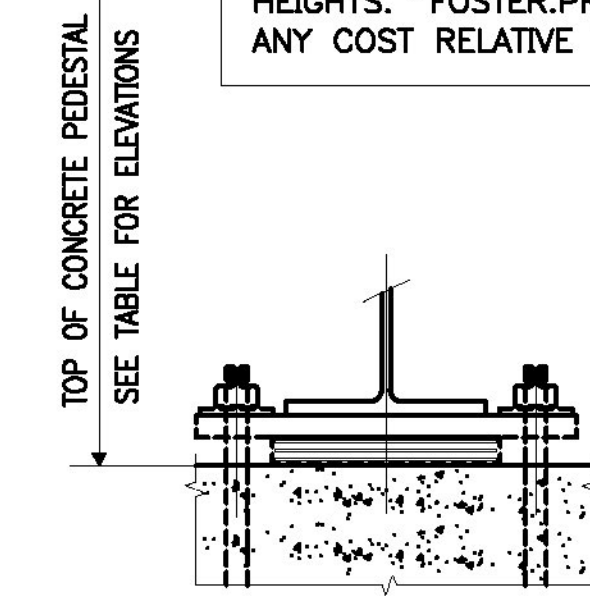

TOP OF CONCRETE PAD ELEV'S (mm)

BEAM	ABUT 1	ABUT 2
BM1	212429	212759
BM2	212464	212795
BM3	212482	212813
BM4	212518	212848
BM5	212518	212848
BM6	212482	212813
BM7	212464	212795
BM8	212429	212759

TYP ABUT. BRG.
 SOLE PL, ELAST. PAD AND ANCHOR BOLTS (BY OTHERS)

STEEL ERECTION PLAN

- ALL DIMENSIONS SHOWN ARE HORIZONTAL AND DO NOT REFLECT ANY CHANGE DUE TO GRADE.
- ALL STEEL TO BE ERECTED WITH THE SHIPPING MARK IN THE SAME RELATIVE POSITION AS SHOWN ON THE ERECTION PLAN.
- SEE SHEET E2 FOR DIAPH. SECTION A-A & TYP. SECTIONS B & C.

FIELD BOLTS

(ACTUAL COUNT - NO EXTRA ADDED)
 (ASTM A325 TYPE 3) H.S. BOLTS WITH HEAVY HEX HEAD & (ASTM A563 GR DH3) HEAVY HEX NUT.

TOTAL	DESCRIPTION	QUANTITY
60	22Ø H.S. BOLT x 57 INT. DIAPH. -C380x50 TO 13mm CONN. PL	
60	HARD FLAT WASHER (F436 -WEATHERING) FOR 22Ø (7/8) H.S. BOLTS	

Received Date: 3/25/11
 Checked By: Hiram Salls
 Approval Type: Approved
 Approved By: Chris Williams
 Date: 4/13/11

NOTICE TO ERECTOR

BACKCHARGES FOR CORRECTIVE WORK OR REPLACED MATERIALS WILL NOT BE ACCEPTED UNLESS EXPRESSLY AUTHORIZED BY FOSTER . PRECISE BEFORE ANY SUCH COSTS ARE INCURRED.

REV. NO.	DATE	REVISION
3		
2		
1		

ERECTION PLAN

PROJECT No. BRF 037-2(8)
 REPLACEMENT OF BRIDGE No. 71
 TOWN OF EAST MONTPELIER, WASHINGTON COUNTY, VT

FOSTER . PRECISE
 3 FARM LANE
 GEORGETOWN, MA 01833-1843

OWNER: STATE OF VERMONT AGENCY OF TRANSPORTATION
 CONTRACTOR: J.R. SLAW

DRAWN BY	CHECKED BY	APP.	SHOP	DIST.	CONTRACT NO.	SHEET NO.
PDC/WS 03-2011	PDC/SB 03-2011				3561	E1