


SEE SHEET 2 FOR INDEX OF SHEETS AND STANDARDS

STATE OF VERMONT AGENCY OF TRANSPORTATION

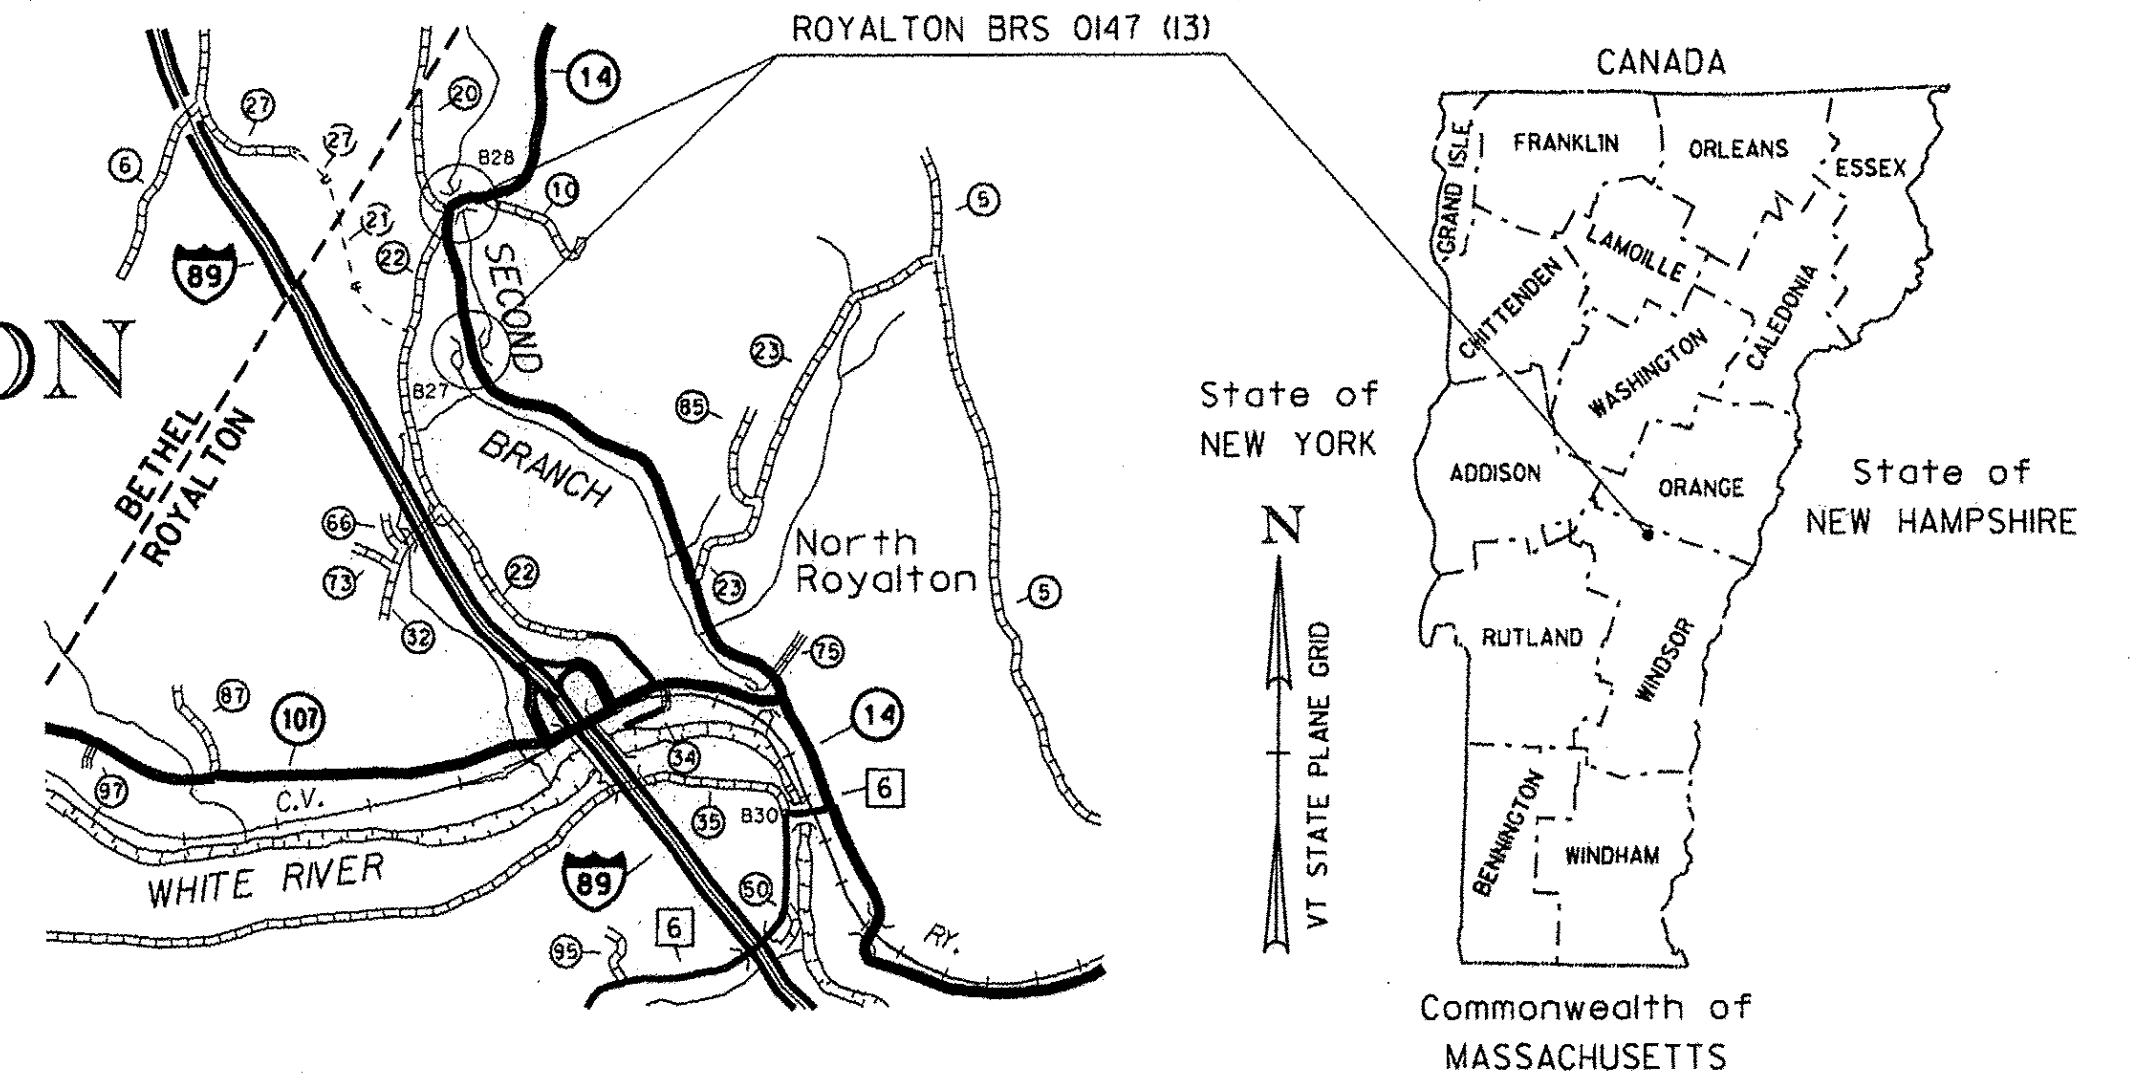

RECORD PLANS	
CONTRACTOR:	WINTerset, INC. - LYNDONVILLE, VT
RESIDENT ENGINEER:	TOM CHASE
CONSTRUCTION BEGAN:	APRIL 18, 2014
CONSTRUCTION COMPLETE:	SEPTEMBER 17, 2015
RECORD PLANS BY:	TOM CHASE & AARON JAMES
I HEREBY CERTIFY THAT ALL THE CONSTRUCTION REQUIRED BY THIS SET OF DRAWINGS HAS BEEN ACCOMPLISHED AS INDICATED HEREIN.	
BY	<i>Thomas A. Chase</i> RESIDENT ENGINEER
DATE	07/14/16
NOTE: Any further information concerning final quantities, amounts or other details relative to this project may be found at Central Files in the electronic archives.	


PROPOSED IMPROVEMENT BRIDGE PROJECT TOWN OF ROYALTON COUNTY OF WINDSOR

ROUTE NO: VT 14 MAJOR COLLECTOR BRIDGES NO: 27 & 28 & CATTLE PASS

PROJECT LOCATION : BEGINNING AT A POINT ON VT 14 APPROXIMATELY 1.418 MILES NORTHWESTERLY FROM THE INTERSECTION OF VT 107 AND VT 14 AND EXTENDING NORTHERLY 0.665 MILES ALONG VT 14.

PROJECT DESCRIPTION : REPLACEMENT OF THE EXISTING BRIDGES INCLUDING RELATED APPROACH ROADWAY AND CHANNEL WORK AT EACH BRIDGE.

LENGTH OF STRUCTURE (BRIDGE 27): 137.78 FEET
 LENGTH OF STRUCTURE (CATTLE PASS): 9.66 FEET
 LENGTH OF STRUCTURE (BRIDGE 28): 123.65 FEET
 LENGTH OF ROADWAY : 1473.91 FEET
 LENGTH OF PROJECT : 1745.00 FEET

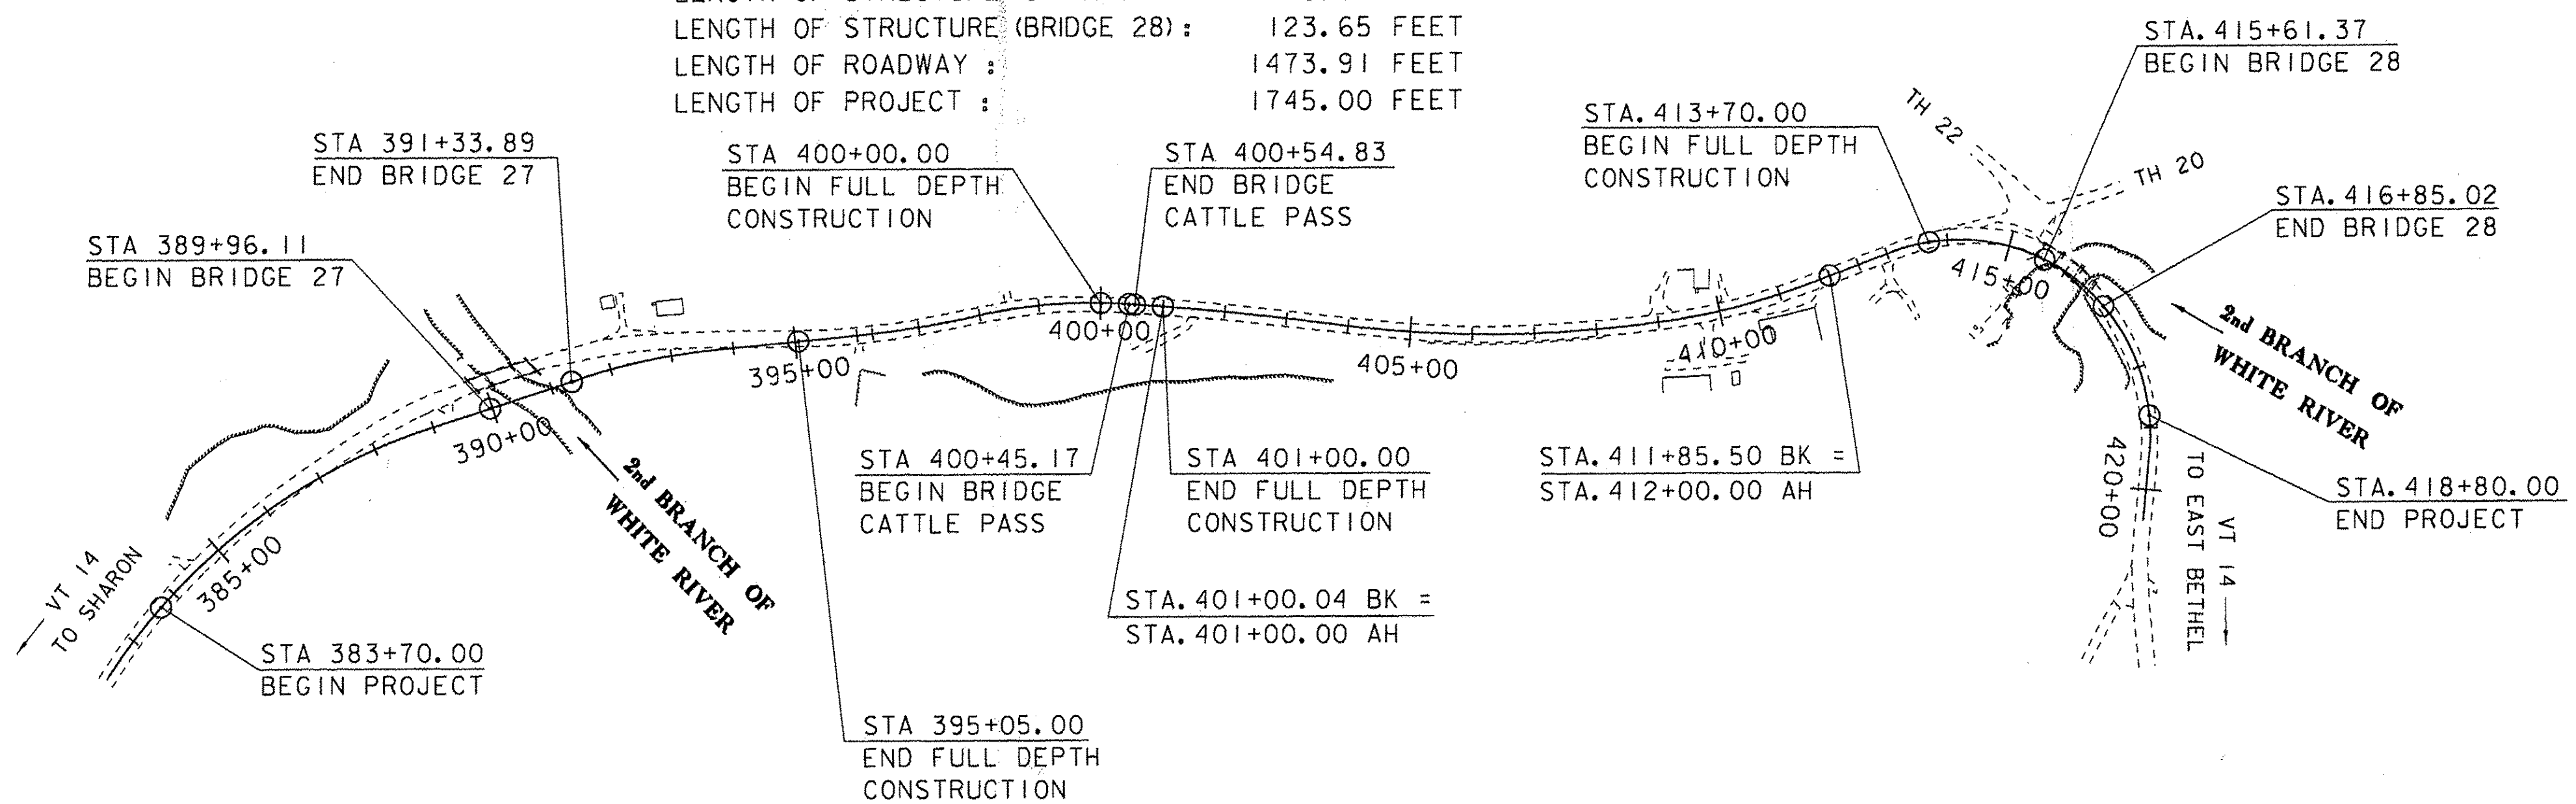

QUALITY ASSURANCE PROGRAM: LEVEL 2

CONVENTIONAL SYMBOLS	
COUNTY LINE	
TOWN LINE	
LIMITS OF ACCESS	
POINT OF ACCESS	
FENCE LINE	
STONE WALL	
TRAVELED WAY	
GUARD RAIL	
RAILROAD	
SURVEY LINE	
CULVERT	
POWER POLE	
TELEPHONE POLE	
TREES	
CONTROL OF ACCESS	
PROPERTY LINE	
R.O.W. TAKING LINE	
SLOPE RIGHTS	
TOP OF CUT	
TOE OF SLOPE	

SURVEYED BY : R. GILMAN
 SURVEYED DATE : 07-16-2001
 DATUM
 VERTICAL : NAVD 88
 HORIZONTAL : NAD 83 (96)

200 0 200
 SCALE: 1" = 200' - 0"

THESE PLANS ARE SUBJECT TO SUCH ENGINEERING CHANGES AS MAY BE REQUIRED BY THE FEDERAL HIGHWAY ADMINISTRATION OR THE DIRECTOR OF PROGRAM DEVELOPMENT.
 CONSTRUCTION IS TO BE CARRIED ON IN ACCORDANCE WITH THESE PLANS AND THE STANDARD SPECIFICATIONS FOR CONSTRUCTION DATED 2014, AS APPROVED BY THE FEDERAL HIGHWAY ADMINISTRATION ON JULY 20, 2011 FOR USE ON THIS PROJECT, INCLUDING ALL SUBSEQUENT REVISIONS AND SUCH REVISED SPECIFICATIONS AND SPECIAL PROVISIONS AS ARE INCORPORATED IN THESE PLANS.

DIRECTOR OF PROGRAM DEVELOPMENT
 APPROVED: *Kevin A. Naudie* DATE 10/4/13
 PROJECT MANAGER : C. CARLSON, P.E.
 PROJECT NAME : ROYALTON
 PROJECT NUMBER : BRS 0147 (13)
 SHEET 1 OF 186 SHEETS