


VT 14 PT NO. 2  
 STA 393+67.52  
 N = 489496.0969  
 E = 1617682.7473

VT 14 POE  
 STA 396+30.00  
 N = 489748.9789  
 E = 1617612.4143

DATUM	
VERTICAL	NAVD 88
HORIZONTAL	NAD 83 (96)
ADJUSTMENT	Compass

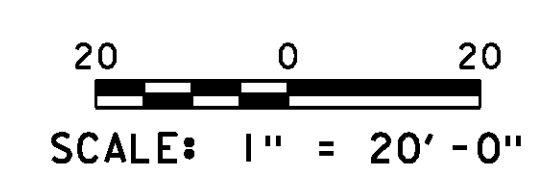

PROJECT NAME:	ROYALTON
PROJECT NUMBER:	BRS 0147(13)
FILE NAME:	\BR 27\s86e055alnbdm_27.dgn
PROJECT LEADER:	C. CARLSON
DESIGNED BY:	D. PETERSON
BRIDGE 27 ALIGNMENT LAYOUT (3)	
PLOT DATE:	08-OCT-2013
DRAWN BY:	L. BULLOCK
CHECKED BY:	C. CARLSON
SHEET	20 OF 186